FHWA REGION NO.	STATE	FED. AID PROJ. NO.	SHEET NO.	TOTAL SHEETS
3	MD			

SIGNALS

1-6

R
Y
G

12"

SIGNS

7

Underwood RD. 18000

Underwood RD. 18000

D 3-2
16" x Var.
(Dual Faced)

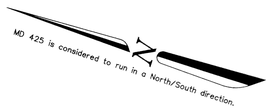

NEMA PHASING

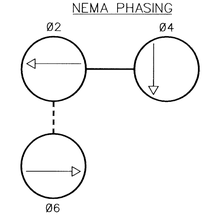

FLASHING OPERATION

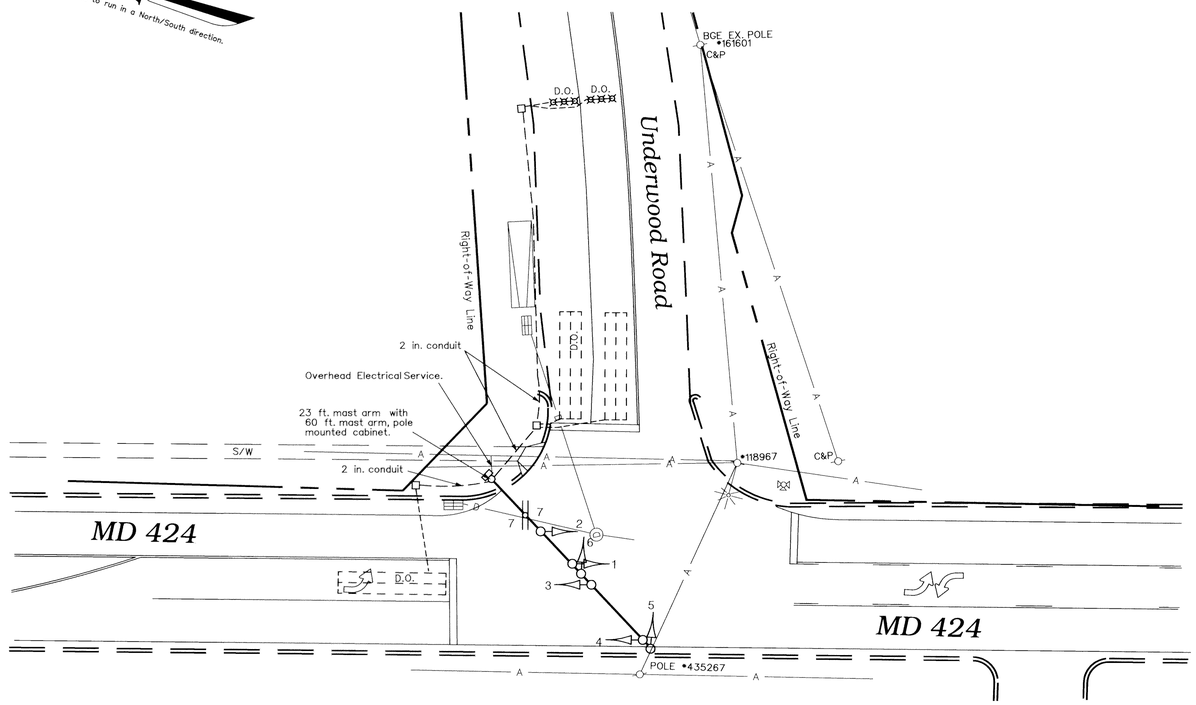

"As-Built"

The Traffic Group

The Traffic Group, Inc.
Suite 600
40 W. Chesapeake Avenue
Towson, Maryland 21204
410-583-8405
1-800-583-8411
Fax: 410-321-8458
Job. No. 970216
ASBUILT.DGN

GEOMETRIC LEGEND

EXISTING GEOMETRICS
PROPOSED GEOMETRICS

UTILITY LEGEND

G — G	GAS MAIN
W — W	WATER MAIN
S — S	SEWER MAIN
E — E	ELECTRIC CABLES
D — D	STORM DRAIN
A — A	AERIAL CABLES
T — T	TELEPHONE CABLES

REVISIONS

Ⓑ ASBUILT Febuary 16,1998
S.H.A. No.:BW983M82
FTH

APPROVALS

ASST. DIVISION CHIEF TRAFFIC ENGINEERING DESIGN DIVISION

CHIEF, TRAFFIC ENGINEERING DESIGN DIVISION

ASST. DISTRICT ENGINEER - TRAFFIC

DIRECTOR, OFFICE OF TRAFFIC & SAFETY

ORIGINAL ON FILE

MDOT – STATE HIGHWAY ADMINISTRATION
Office of Traffic & Safety
TRAFFIC ENGINEERING DESIGN DIVISION

DRAWN BY: James Allen Jr.
DES. BY: Mike Kotzen
CHK. BY: Steve Renzi

(Traffic Signal Plan)

MD 424 at Underwood Road

COUNTY: Anne Arundel

LOG MILE • 02042406.04

DATE: October , 1994
SCALE: 1" = 20'

F.A.P. NO. N/A
S.H.A. NO. AW793- -585

TS/STD. NO. *3470B*

SHEET NO. 1 of 1