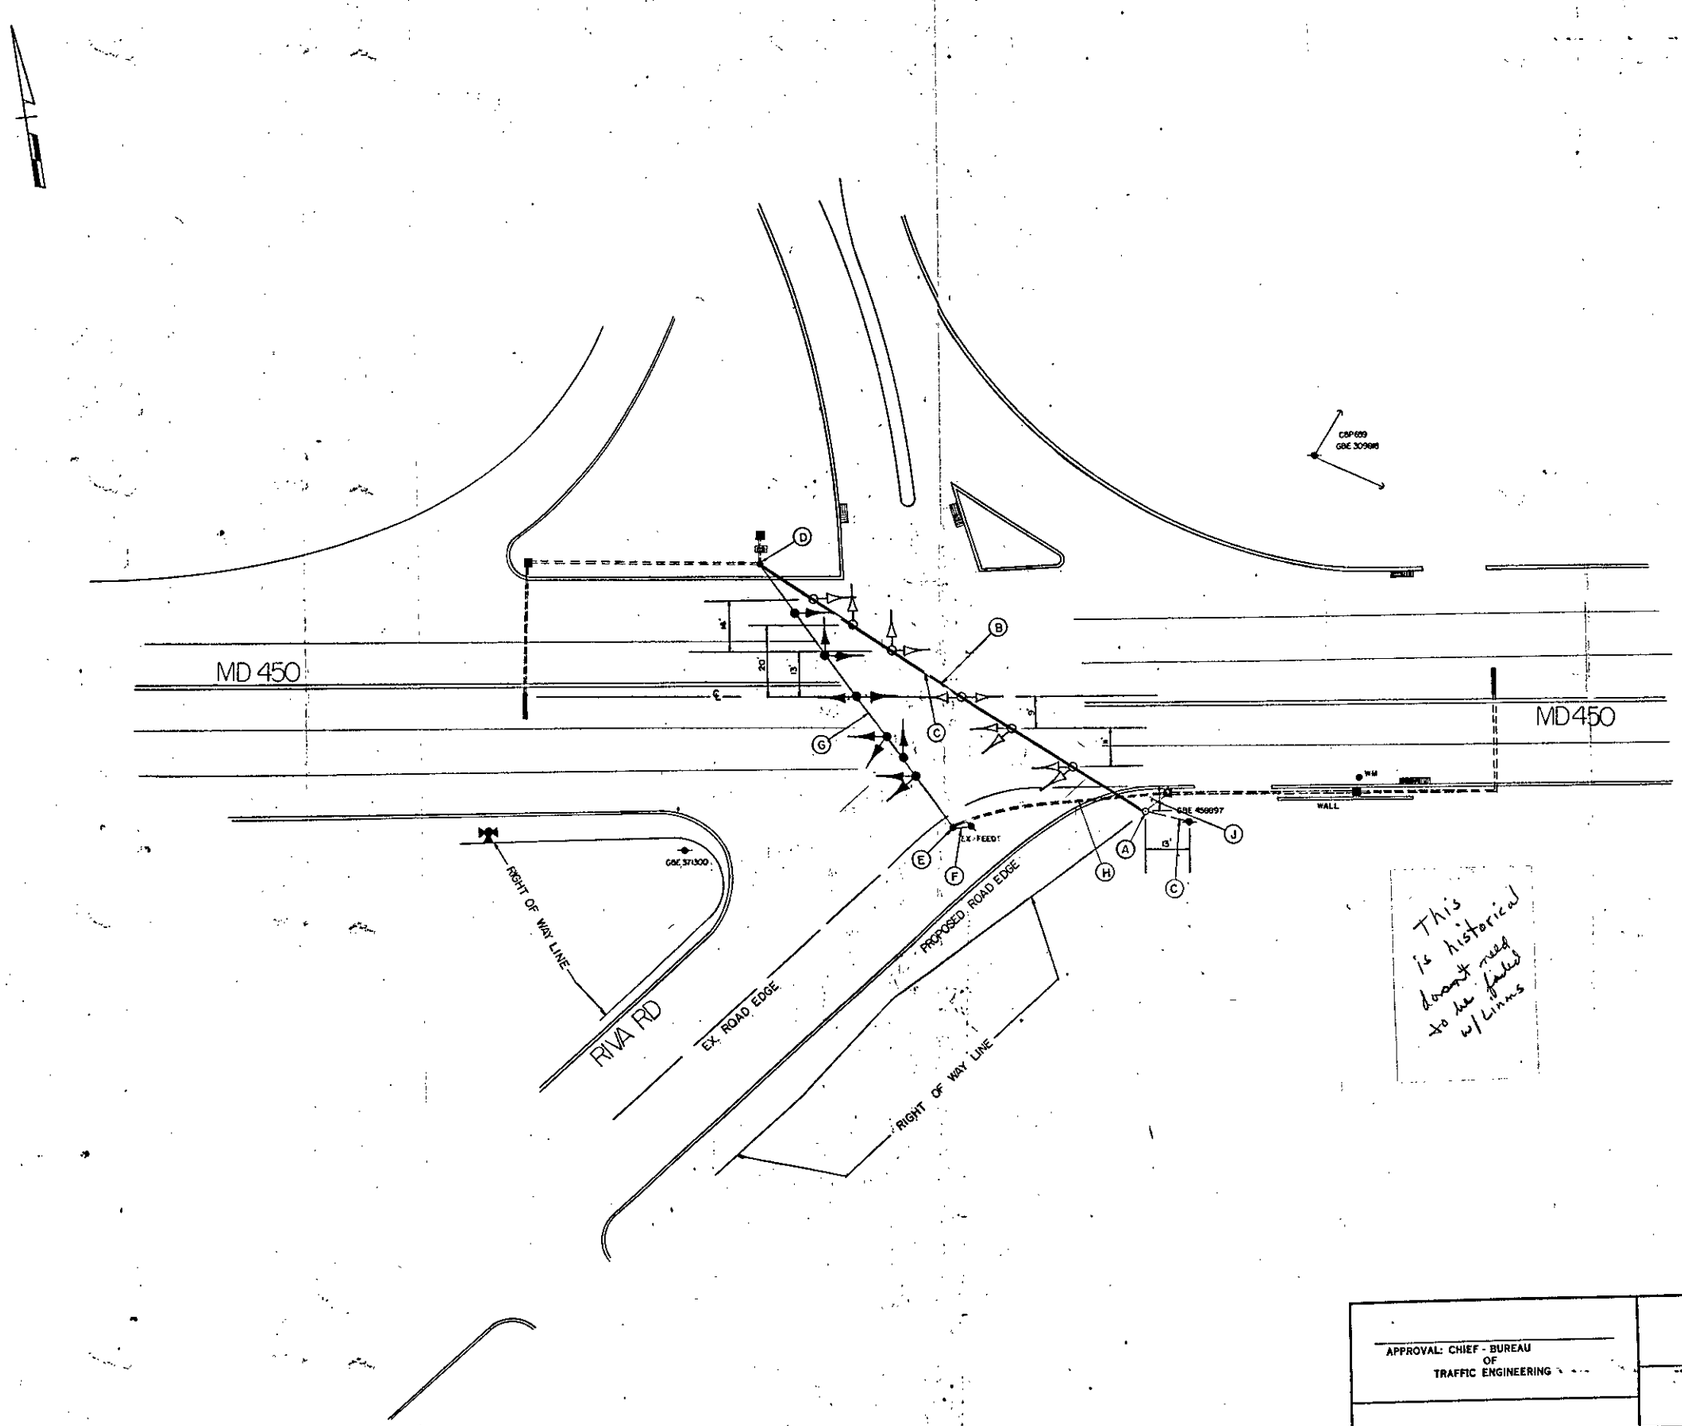


This is historical doesn't need to be filled w/ Lines

| | |
|---|---|
| A | MAY 24, 1973 RELOCATED POLE IN SOUTHEAST QUADRANT |
| JB | |

REVISIONS

APPROVAL: CHIEF - BUREAU OF TRAFFIC ENGINEERING

APPROVAL: ASS'T CHIEF ENGINEER TRAFFIC SAFETY

**MARYLAND STATE ROADS COMMISSION**
DIVISION OF TRAFFIC SAFETY
BUREAU OF TRAFFIC ENGINEERING

MD 450 & RIVA RD
ANNE ARUNDEL CO. ROAD PROJECT NO. 931-R

DATE 4-27-73 CONTRACT NO
SCALE 1" = 20' COUNTY ANNE ARUNDEL
DRAWN BY: M LINARDI JB CHECKED BY:

DRAWING NO. TS-864A

02045009.81