FED. ROAD DIV. NO.	STATE	FED. AID PROJ. NO.	SHEET NO.	TOTAL SHEETS
3	MD.		2	8

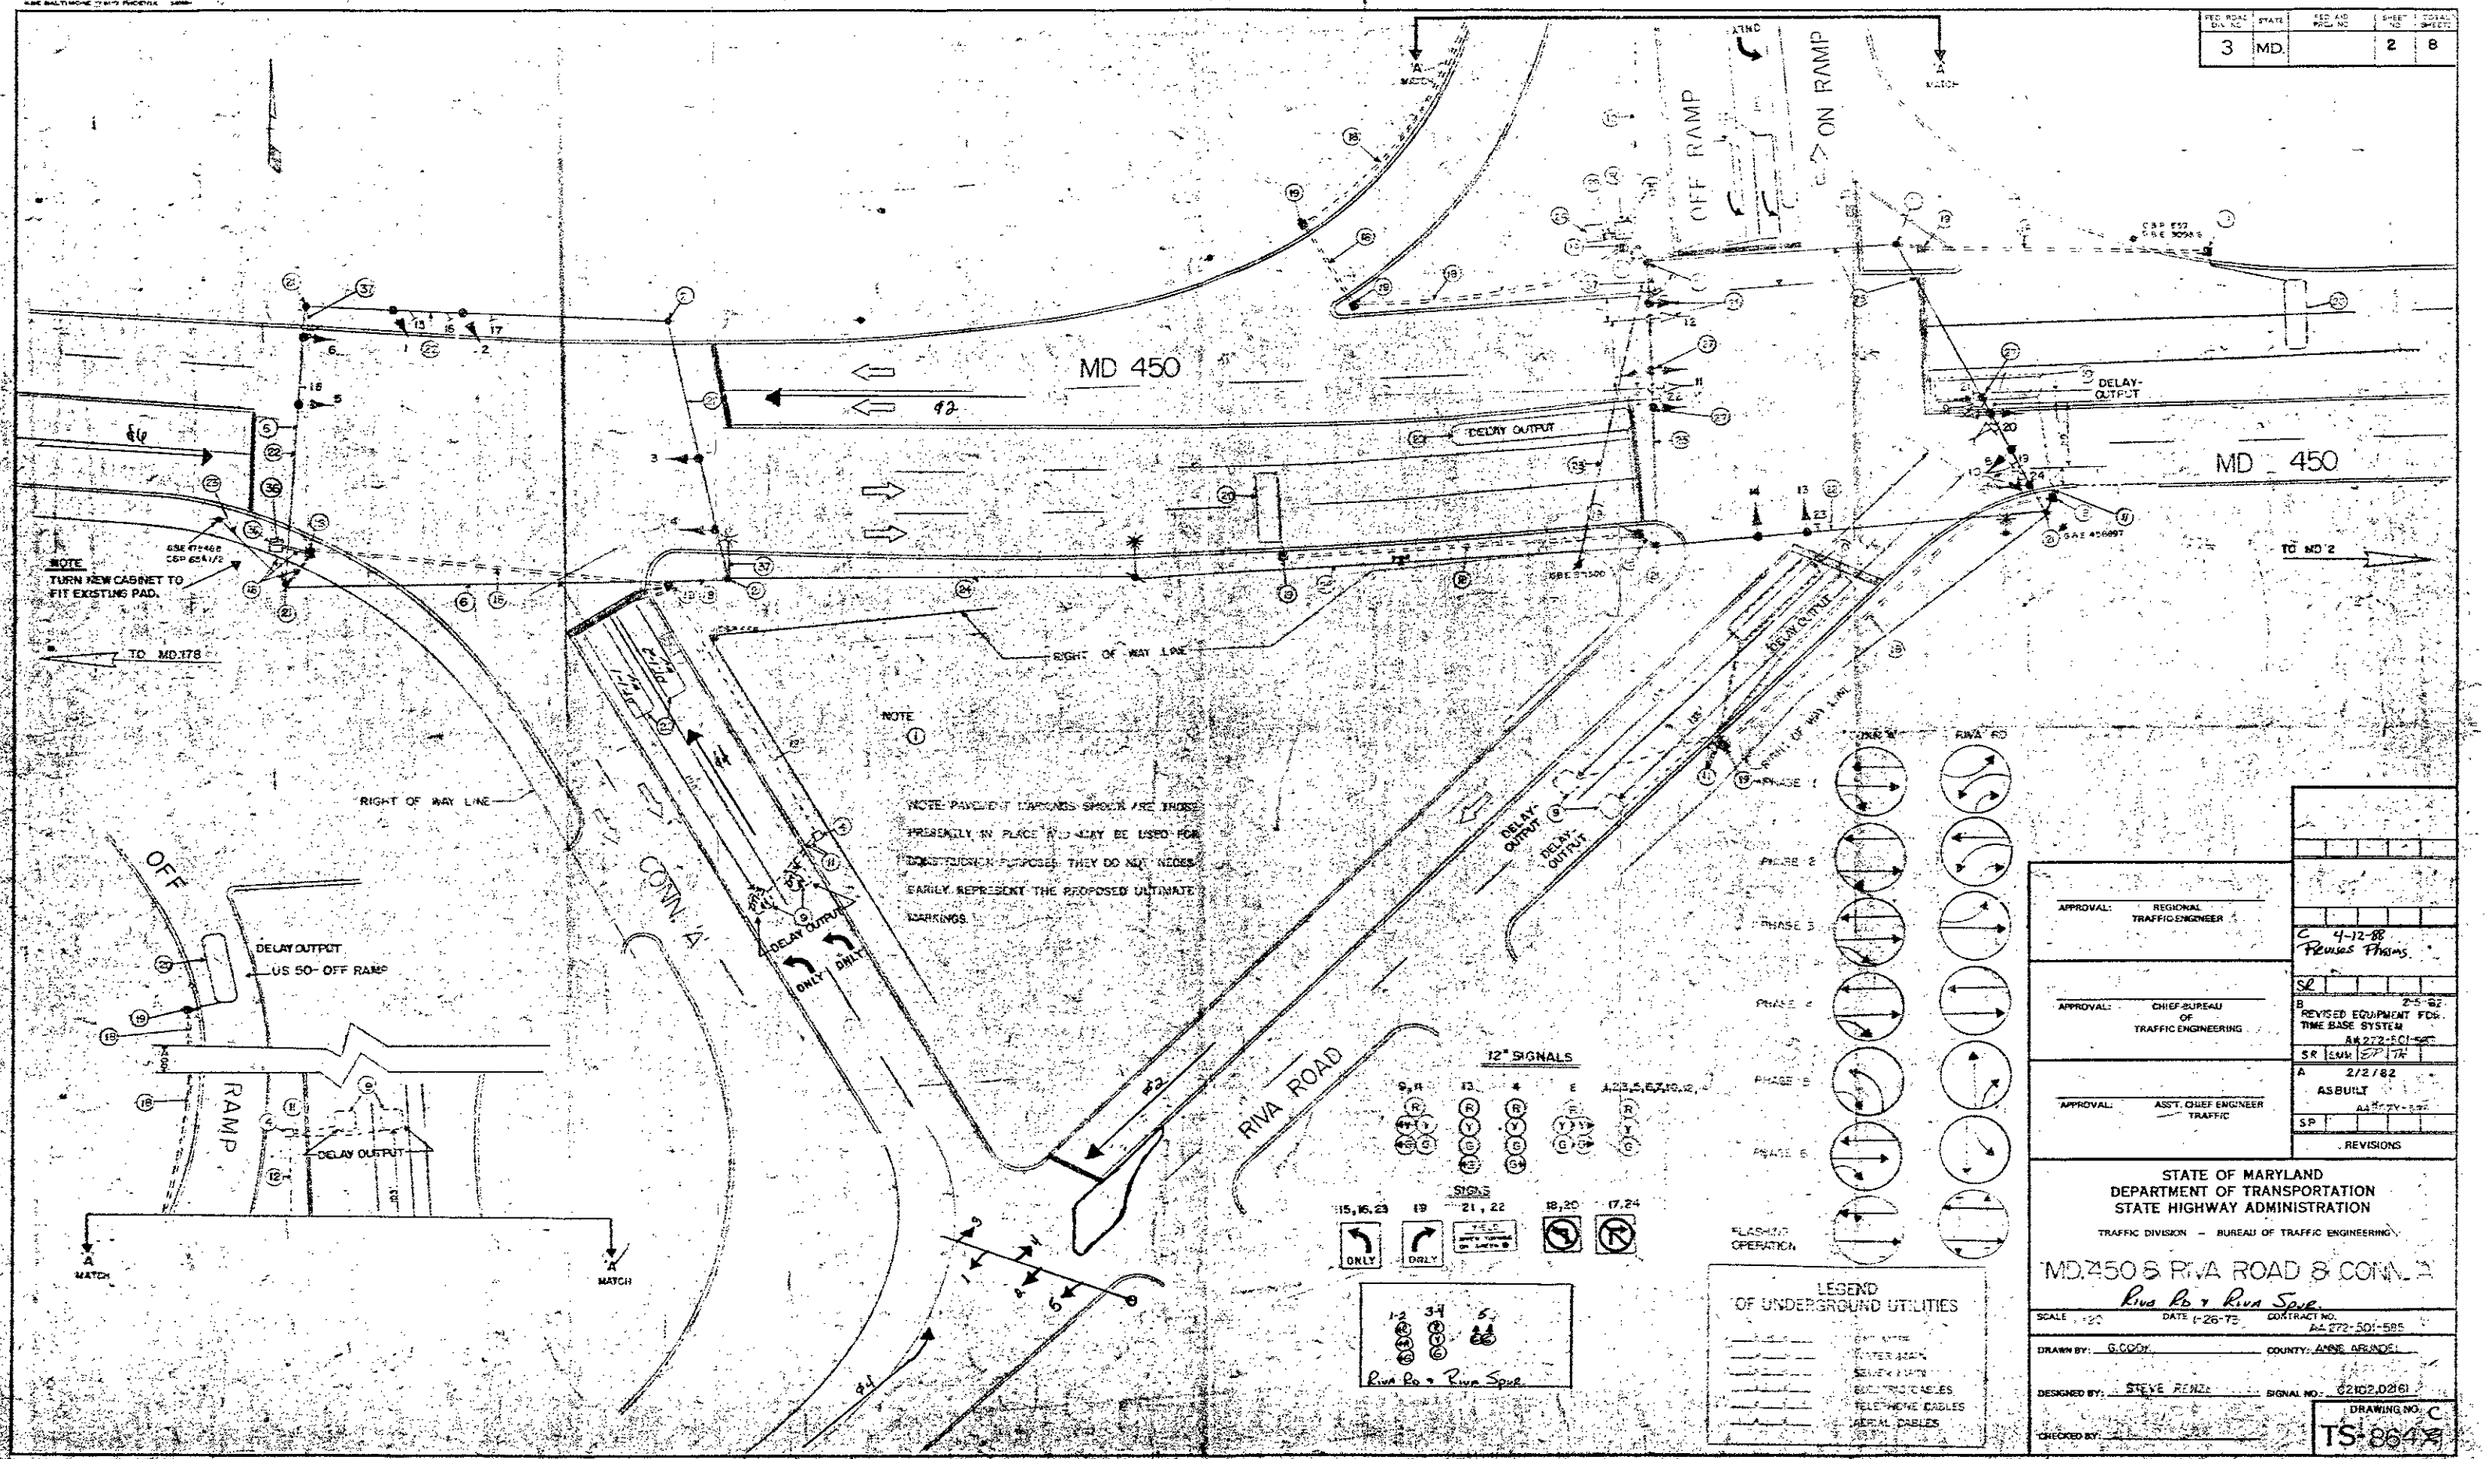

APPROVAL: REGIONAL TRAFFIC ENGINEER

APPROVAL: CHIEF BUREAU OF TRAFFIC ENGINEERING

APPROVAL: ASS'T. CHIEF ENGINEER TRAFFIC

C 4-12-88 Revises Phasing

B 2-5-82 REVISED EQUIPMENT FOR TIME BASE SYSTEM AA 272-501-585

A 2/2/82 AS BUILT AA 272-501-585

REVISIONS

STATE OF MARYLAND
DEPARTMENT OF TRANSPORTATION
STATE HIGHWAY ADMINISTRATION

TRAFFIC DIVISION – BUREAU OF TRAFFIC ENGINEERING

MD.450 & RIVA ROAD & CONN. A

Riva Rd + Riva Spur

SCALE 1:20 DATE 1-26-75 CONTRACT NO. AA 272-501-585

DRAWN BY: G. CODY COUNTY: ANNE ARUNDEL

DESIGNED BY: STEVE RENZI SIGNAL NO.: 02102,0261

CHECKED BY:

DRAWING NO. C TS-8648

020450098