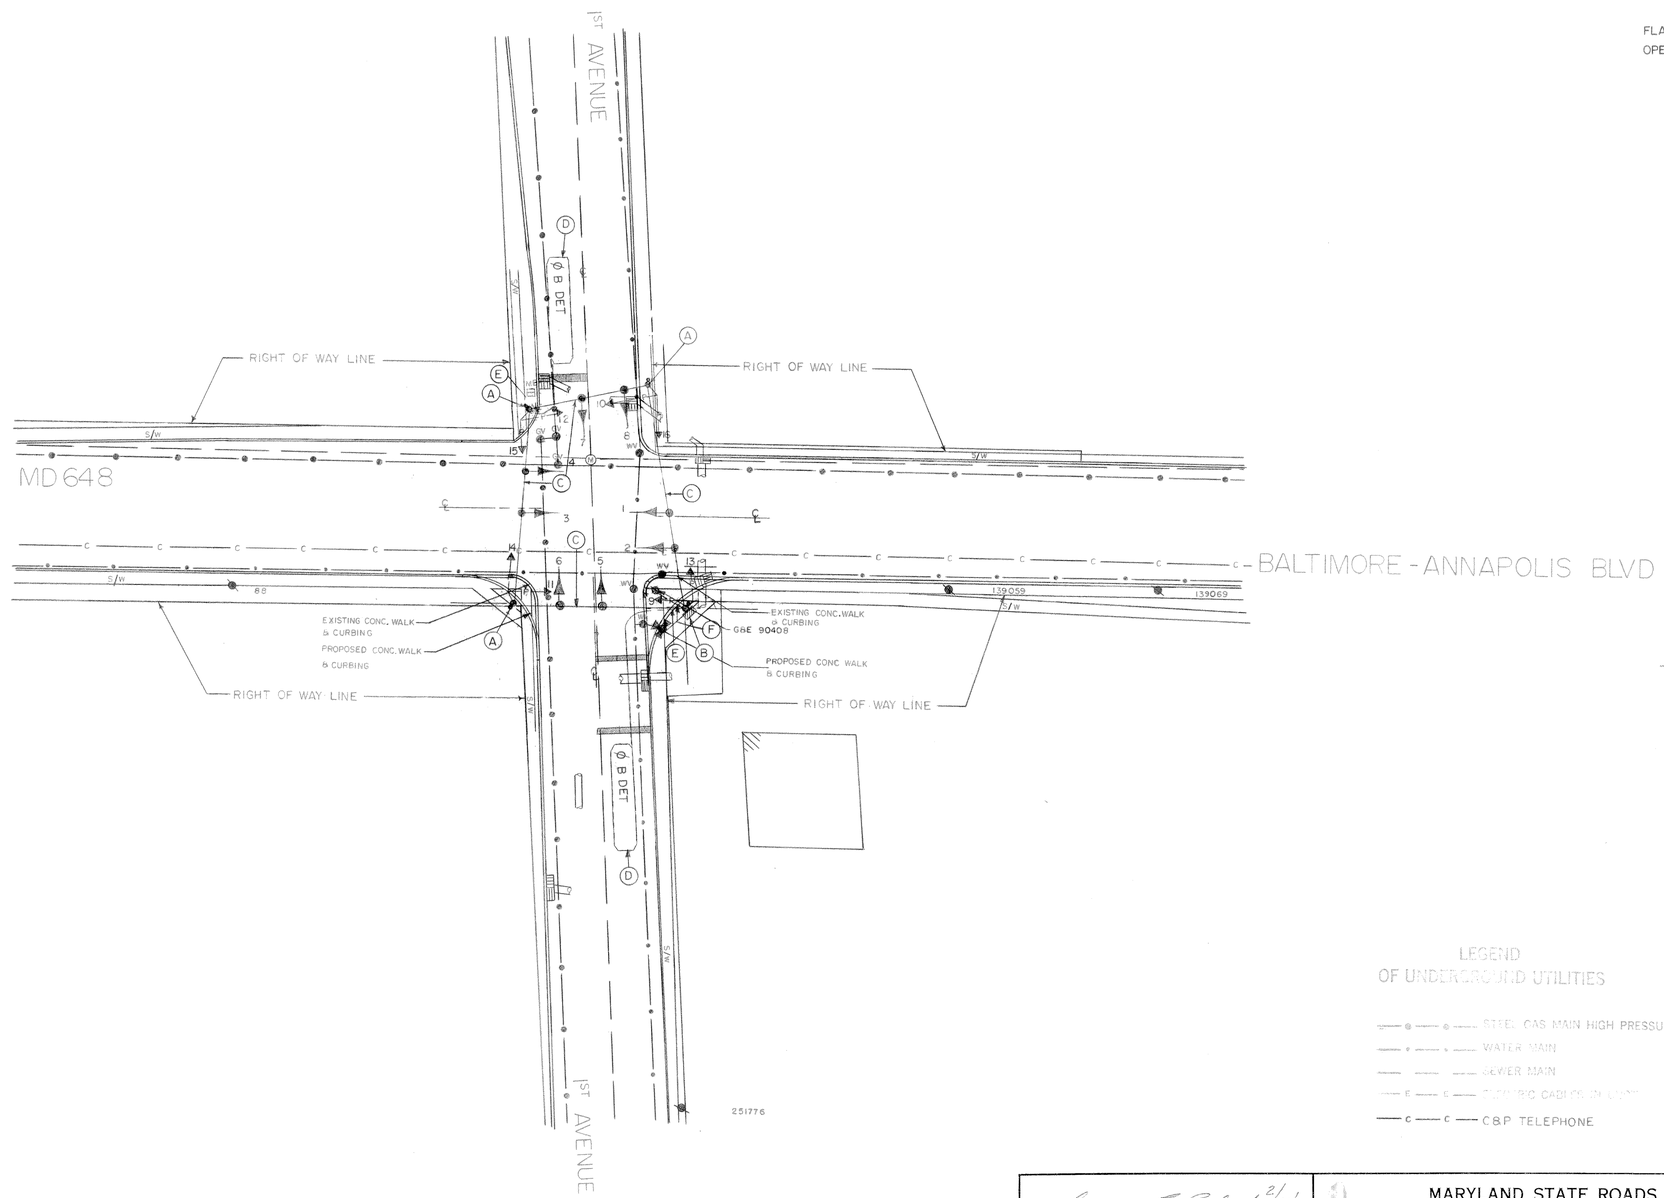

SIGNALS
1-8 9-16
R Y G DW WK

PHASE A

PHASE B

PHASE B ALTERNATE

FLASHING OPERATION

LEGEND
OF UNDERGROUND UTILITIES

STEEL GAS MAIN HIGH PRESSURE
WATER MAIN
SEWER MAIN
ELECTRIC CABLE OR CONDUIT
C&P TELEPHONE

A	5-1-74 ASBUILT
FR	

REVISIONS

APPROVAL: [redacted] R.T.E. 2/14/73

APPROVAL: ANNE ARUNDEL CO.-TRAFFIC ENGINEER 2/8/73

APPROVAL: ASS'T. CHIEF ENGINEER TRAFFIC SAFETY 2/14/73

MARYLAND STATE ROADS COMMISSION
DIVISION OF TRAFFIC SAFETY
BUREAU OF TRAFFIC ENGINEERING

MD 648 & 1ST AVENUE

SIGNAL NO 02154

DATE 12-20-72
SCALE 1"=20'
DRAWN BY: D DODA
CONTRACT NO AA-886X-575
COUNTY ANNE ARUNDEL
CHECKED BY: 2-7-73

DRAWING NO. TS-821A