F H WA REGION NO	STATE	FED. AID PROJ. NO	SHEET NO.	TOTAL SHEETS
3	MD.			

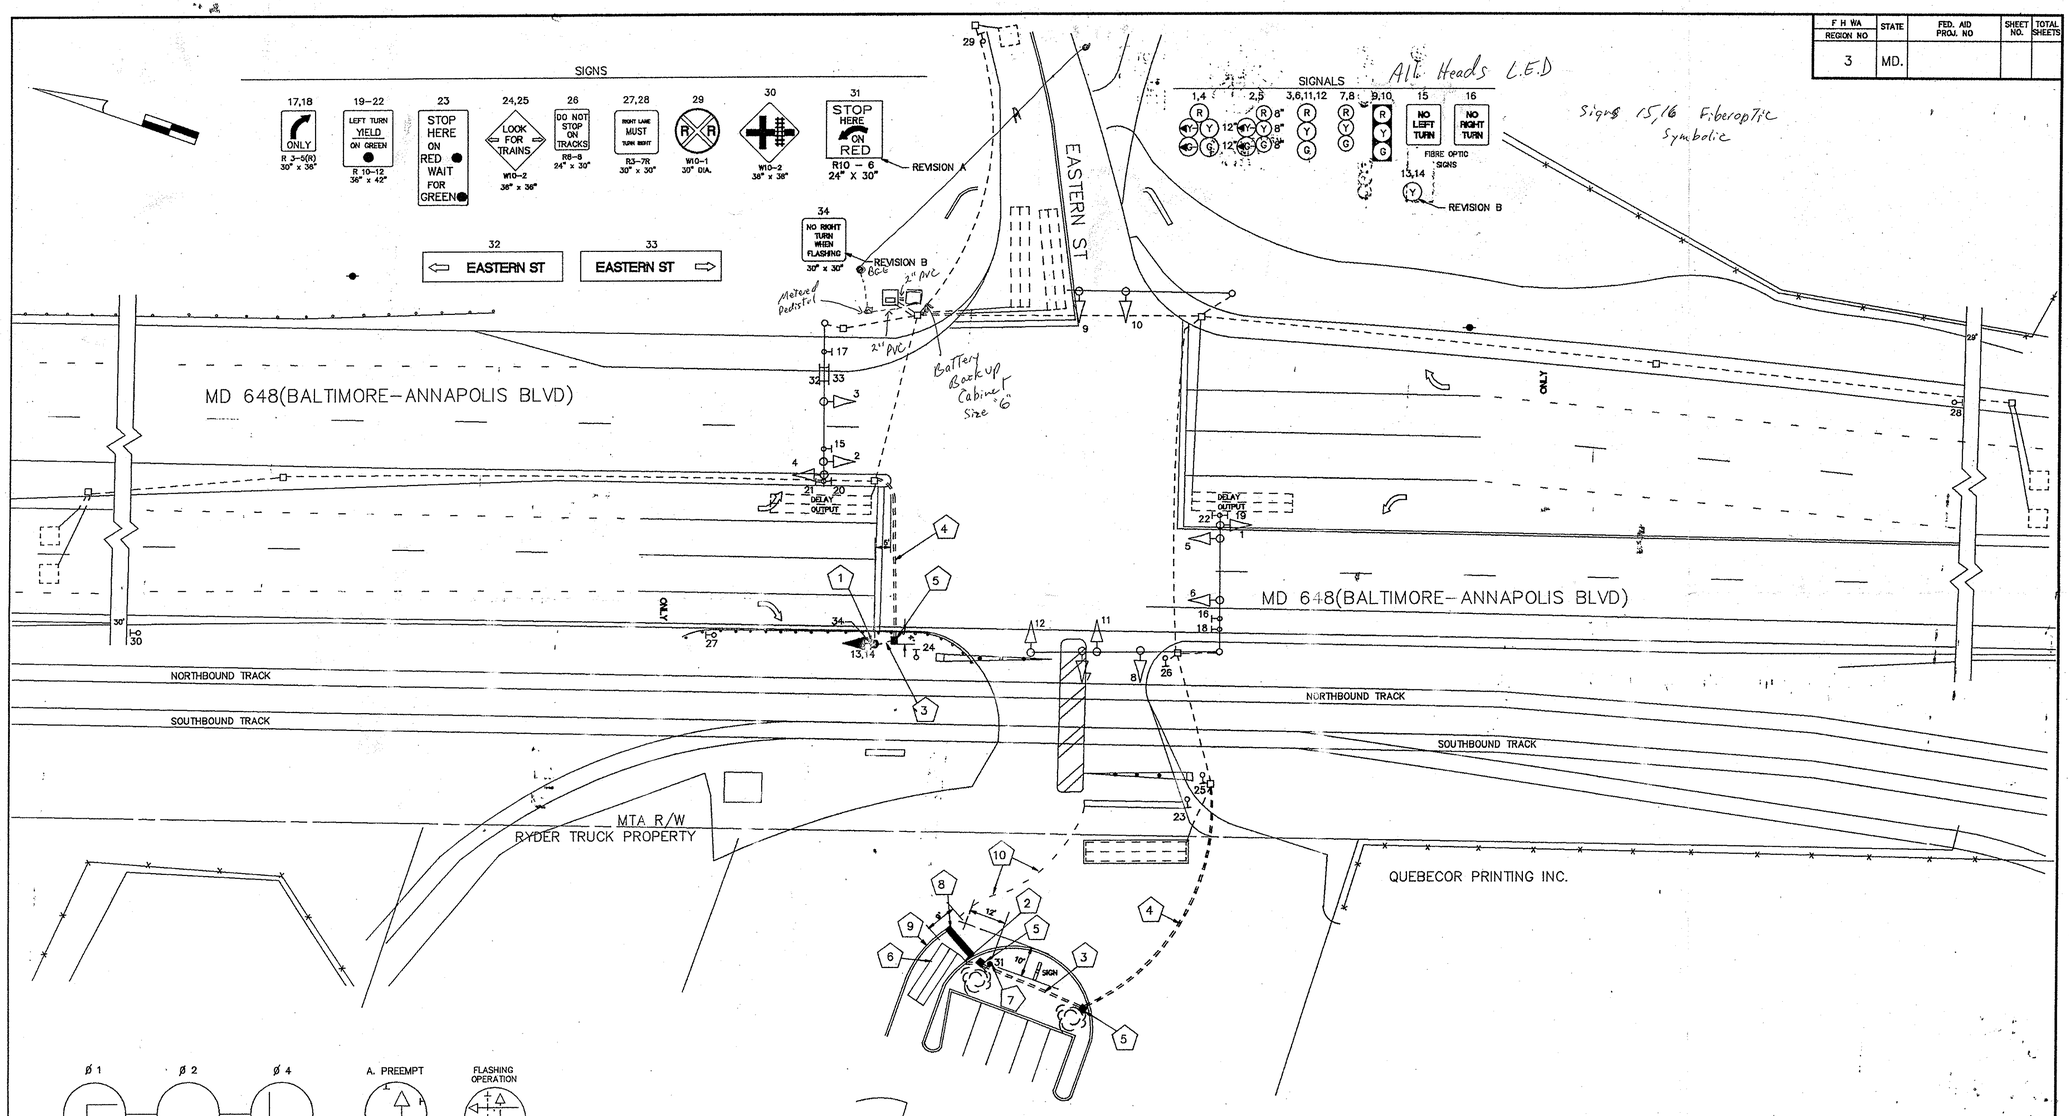

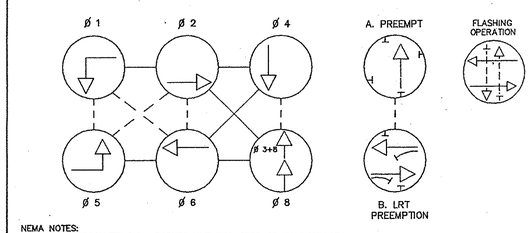

NEMA NOTES:
1. PHASES ASSOCIATED BY A DASHED LINE WILL OPERATE CONCURRENTLY.
2. PHASES ASSOCIATED BY A SOLID LINE WILL NOT OPERATE CONCURRENTLY.

REVISIONS	APPROVALS
(C) AS built: Install WPS and LEDs and metered Pedistal February 2006	CHIEF, SIGNAL DESIGN SECTION
B 4/95 REVISE PED. MOUNT SIGNAL TO H.I.B. SHA NO. 85525057021	ASST. DISTRICT ENGINEER, TRAFFIC
(A) ASBUILT 12/94 ADD PED. MOUNT RT. TURN SIGNAL AND DETECTION. SHA NO. 85525057021	CHIEF, TRAFFIC ENGINEERING DESIGN DIVISION
DJD DAZ ETP TH	DIRECTOR, OFFICE OF TRAFFIC & SAFETY

MDOT – STATE HIGHWAY ADMINISTRATION
Office of Traffic & Safety
TRAFFIC ENGINEERING DESIGN DIVISION

DRAWN BY: BRUCE THOMPSON JFF
DES. BY:
CHK. BY:

MD 648 and EASTERN AVE
02E64804.12 AS Built
COUNTY: ANNE ARUNDEL

DATE: REDRAWN 10-31-94
SCALE: 1"=20'
F.A.P. NO.
S.H.A. NO.
TS/STD. NO. 2304 C
SHEET NO. ___ OF ___