GENERAL NOTE

1. THE CONTRACTOR SHALL BE RESPONSIBLE FOR TERMINATING ALL SIGNAL CABLE TO THE APPROPRIATE TERMINALS AND PROPERLY LABEL EACH CABLE.

CONSTRUCTION DETAILS

A. USE PROPOSED CONDUIT. INSTALL 12-PAIR COMMUNICATION CABLE. (SEE SIGNAL PLANS)

B. USE PROPOSED HANDHOLE. INSTALL 12-PAIR COMMUNICATION CABLE. (SEE SIGNAL PLANS)

C. USE PROPOSED BASE MOUNTED CABINET AND CONTROLLER. INSTALL 12 PAIR COMMUNICATION CABLE. (SEE SIGNAL PLANS)

G. INSTALL 3 IN. PVC SCHEDULE 80 ELECTRICAL CONDUIT - TRENCHED. INSTALL 12-PAIR COMMUNICATION CABLE.

K. INSTALL 40 FT. CLASS II WOOD POLE, 3 IN. ELECTRICAL CONDUIT PVC RISER AND BACK GUYS.

L. INSTALL 3/8 IN. SPAN WIRE AND 12-PAIR COMMUNICATION CABLE.

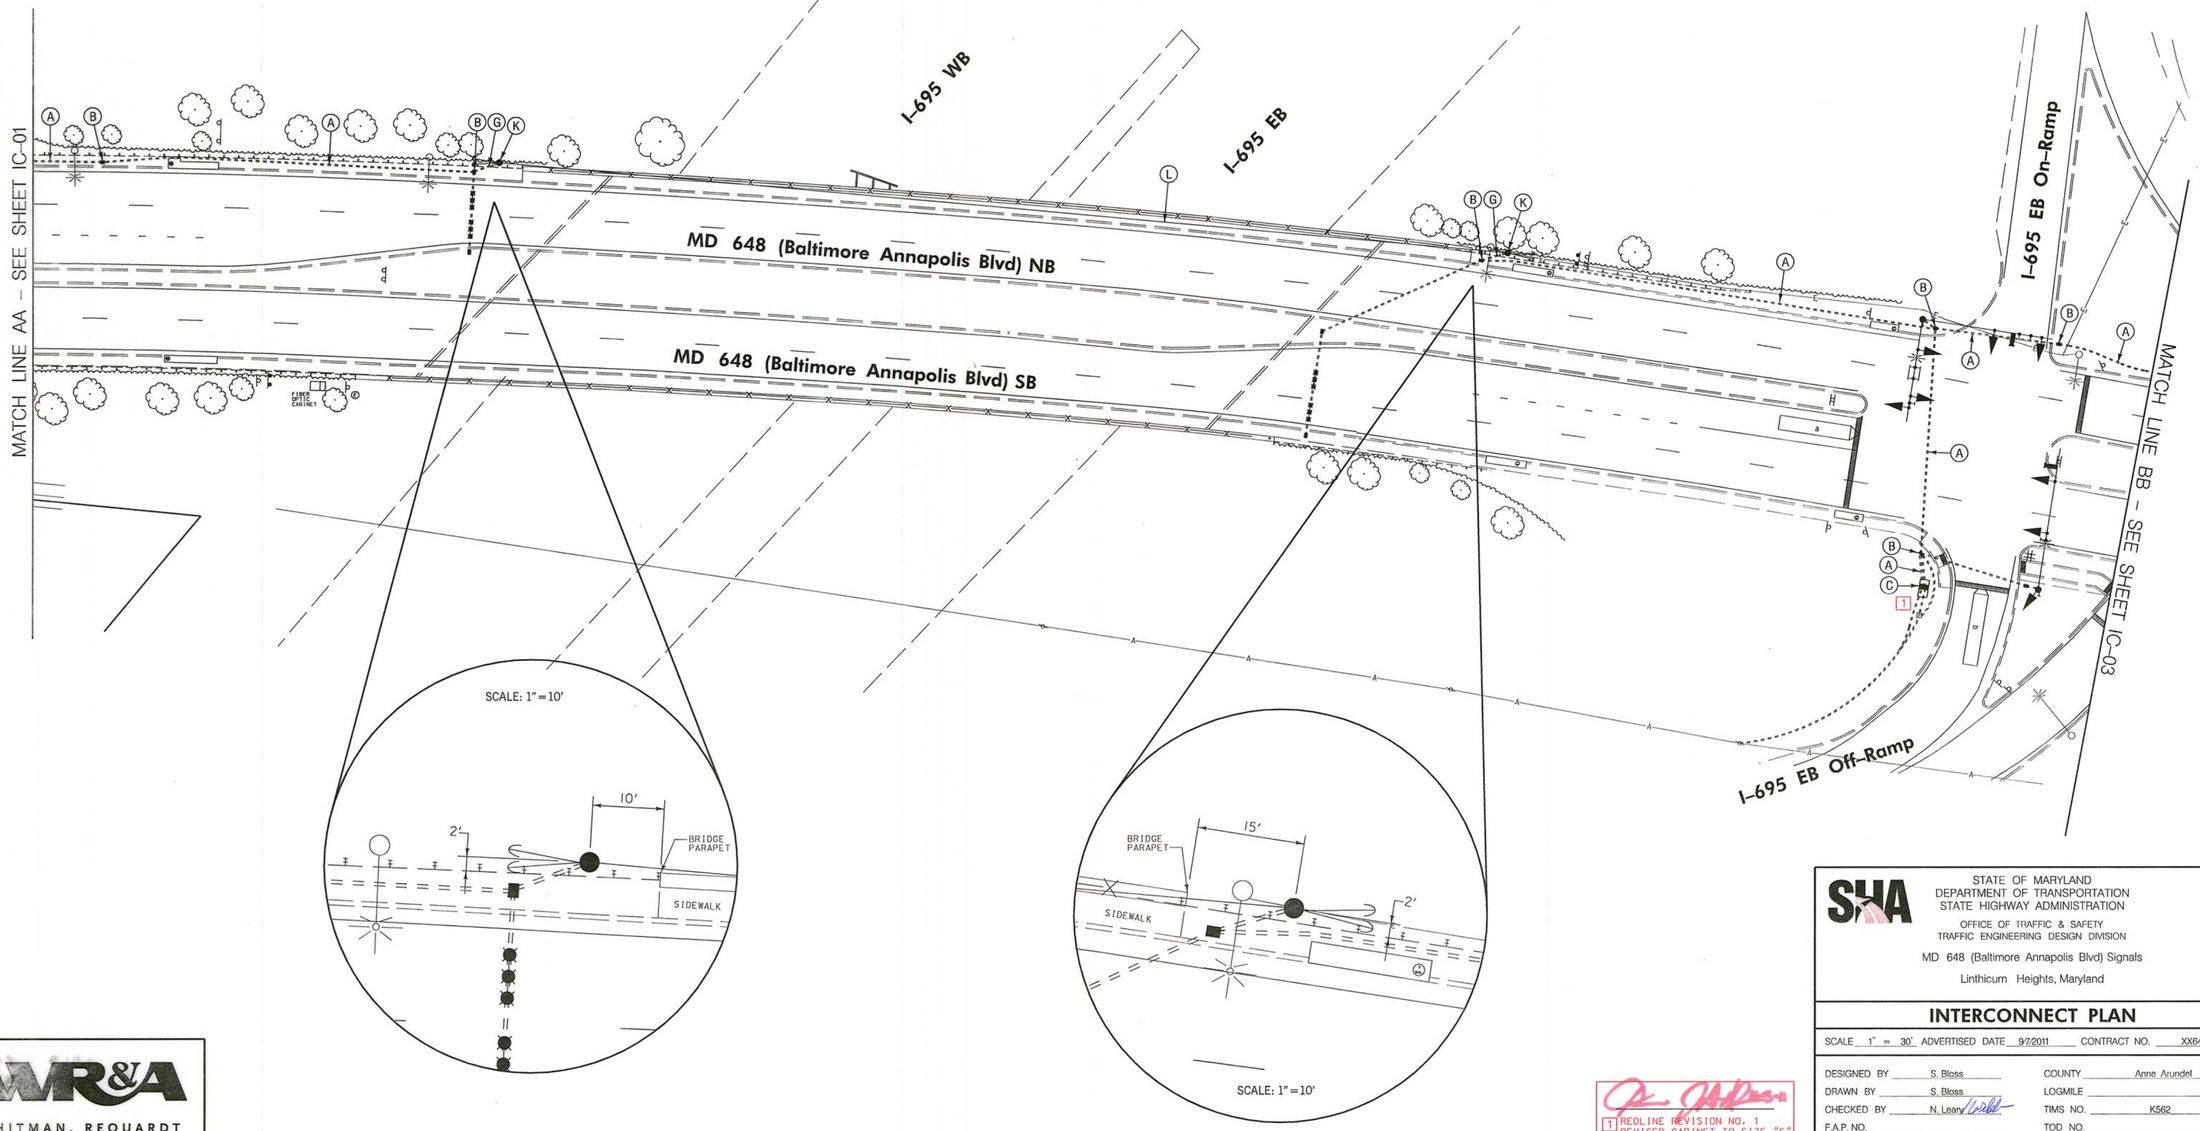

WR&A
WHITMAN, REQUARDT & ASSOCIATES, LLP
801 South Caroline Street, Baltimore, Maryland 21231

BY: sbloss

1 REDLINE REVISION NO. 1
REVISED CABINET TO SIZE "S"
11/2/2011

SHA
STATE OF MARYLAND
DEPARTMENT OF TRANSPORTATION
STATE HIGHWAY ADMINISTRATION
OFFICE OF TRAFFIC & SAFETY
TRAFFIC ENGINEERING DESIGN DIVISION

MD 648 (Baltimore Annapolis Blvd) Signals

Linthicum Heights, Maryland

INTERCONNECT PLAN

SCALE 1" = 30' ADVERTISED DATE 9/7/2011 CONTRACT NO. XX6475185

DESIGNED BY	S. Bloss	COUNTY	Anne Arundel
DRAWN BY	S. Bloss	LOGMILE	
CHECKED BY	N. Leary	TIMS NO.	K562
F.A.P. NO.		TOD NO.	

TS NO.	DRAWING IC-02 OF 3	SHEET NO. 4 OF 6

PLOTTED: November 02, 2011
FILE: N:\31669-150\CADD\Redline 1\pSG-C002_md648-RL1.dgn