K&E 19 1153 6-81 MC 2647•

F.H.W.A. REGION NO.	STATE	FED. AID PROJ. NO.	SHEET NO.	TOTAL SHEETS
3	MD.			

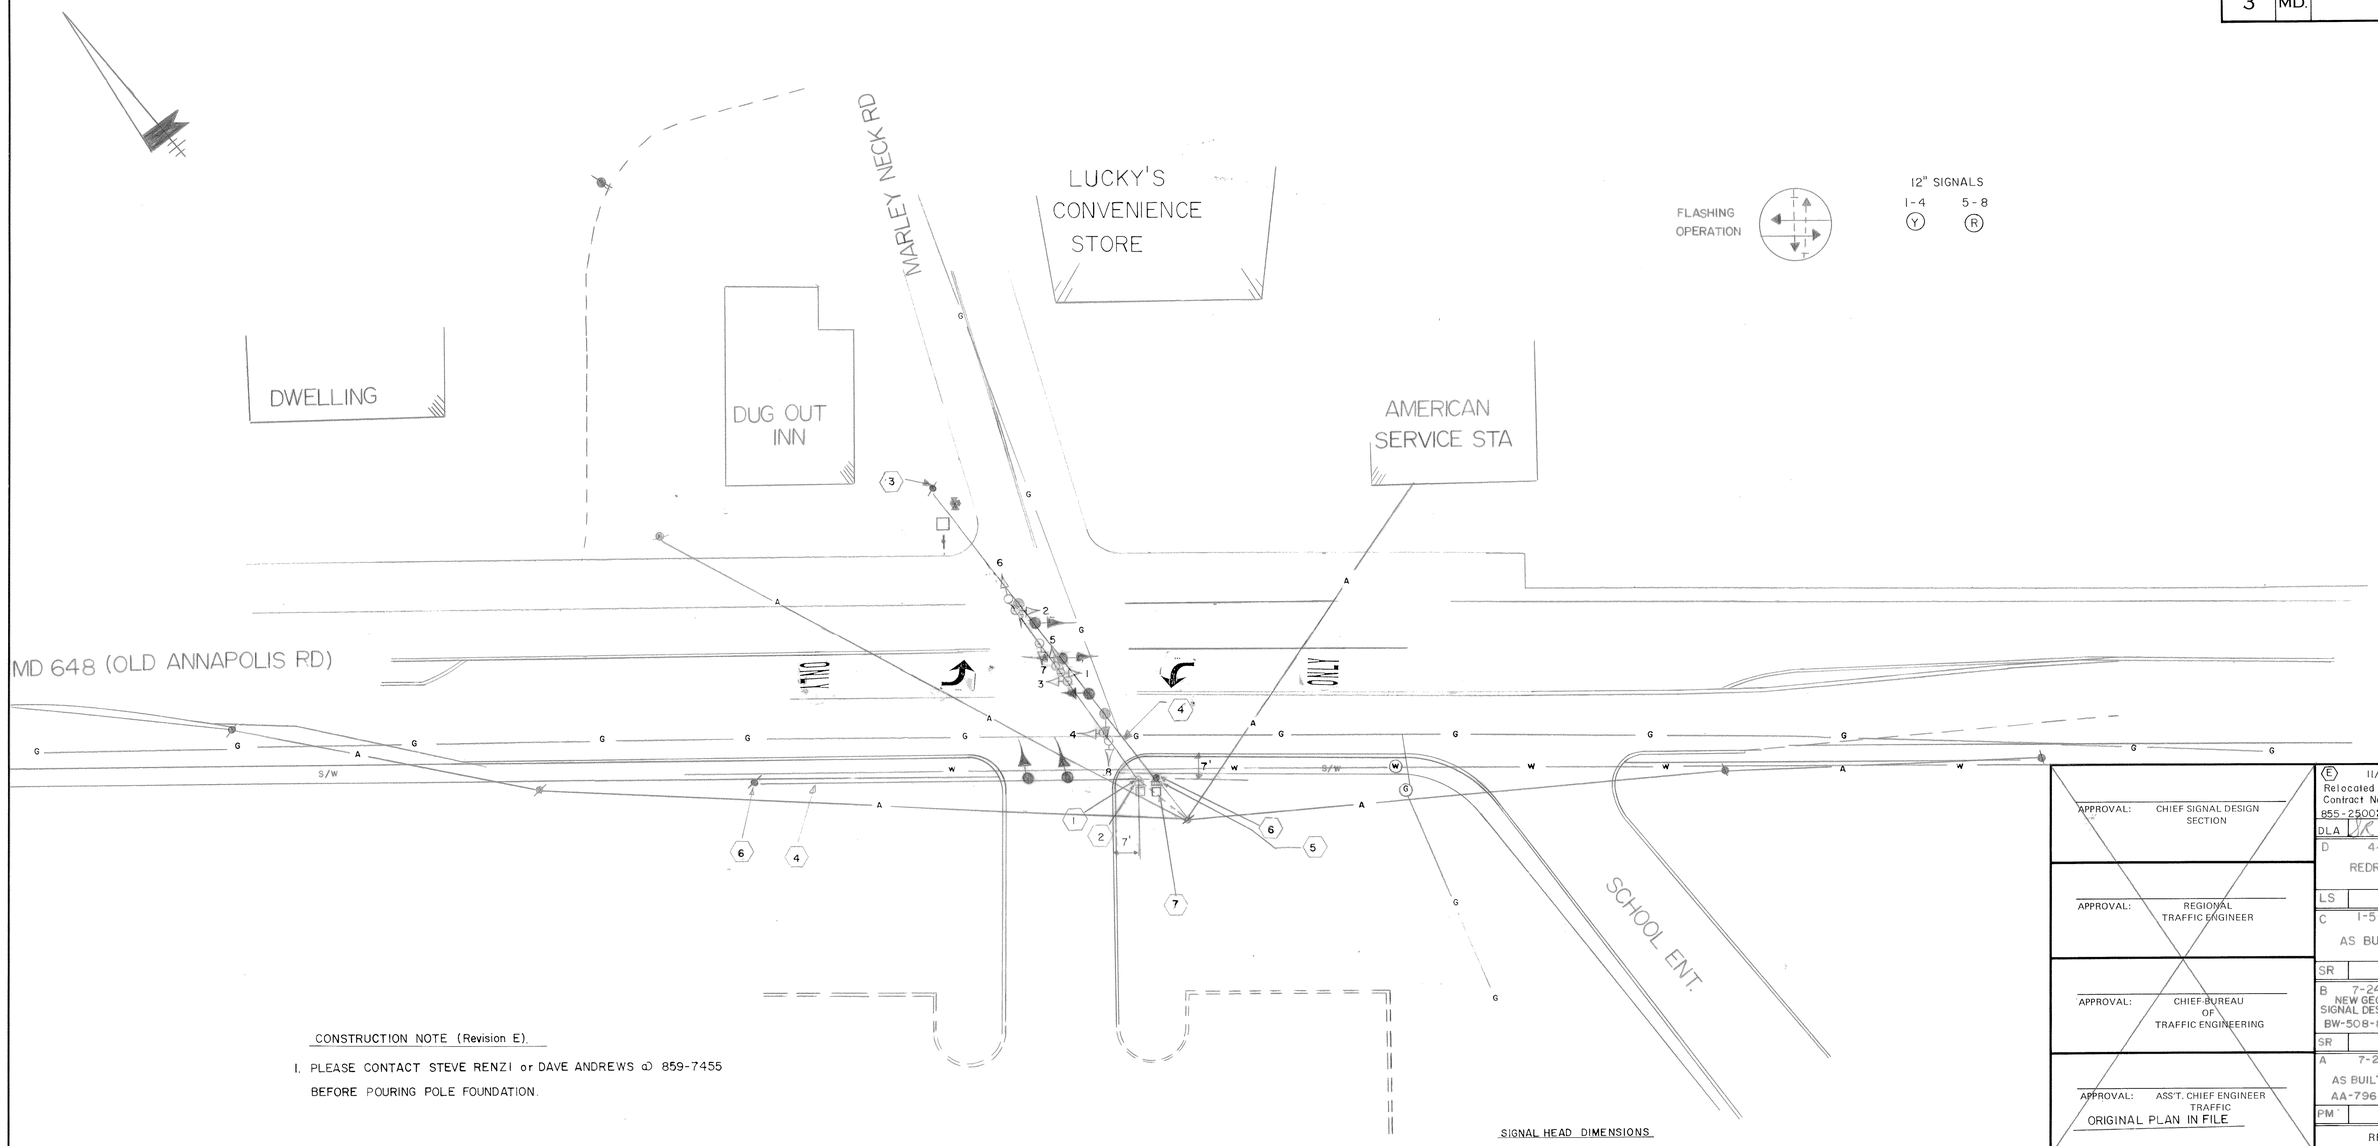

CONSTRUCTION NOTE (Revision E).

1. PLEASE CONTACT STEVE RENZI or DAVE ANDREWS @ 859-7455 BEFORE POURING POLE FOUNDATION.

LEGEND OF UNDERGROUND UTILITIES

SIGNAL HEAD DIMENSIONS

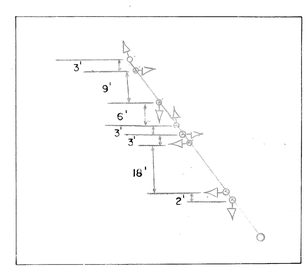

APPROVAL: CHIEF SIGNAL DESIGN SECTION

APPROVAL: REGIONAL TRAFFIC ENGINEER

APPROVAL: CHIEF BUREAU OF TRAFFIC ENGINEERING

APPROVAL: ASS'T. CHIEF ENGINEER TRAFFIC

ORIGINAL PLAN IN FILE

E 11/14/84 Relocated Flasher. Contract No. 855-25002 DLA

D 4-26-83 REDRAWN

LS

C 1-5-81 AS BUILT

SR

B 7-24-80 NEW GEOMETRICS & SIGNAL DESIGN BW-508-801-512

SR

A 7-25-73 AS BUILT AA-796X-575

PM

REVISIONS

STATE OF MARYLAND
DEPARTMENT OF TRANSPORTATION
STATE HIGHWAY ADMINISTRATION

TRAFFIC DIVISION – BUREAU OF TRAFFIC ENGINEERING

MD 648 (OLD ANNAPOLIS RD) & MARLEY NECK RD

SCALE 1" = 20' DATE 5-21-71 CONTRACT NO. AA-796X-575

DRAWN BY: COUNTY: ANNE ARUNDEL

DESIGNED BY: LES TOWNSEND SIGNAL NO.: 02113

CHECKED BY: J SPENCE

DRAWING NO. TS- 341E