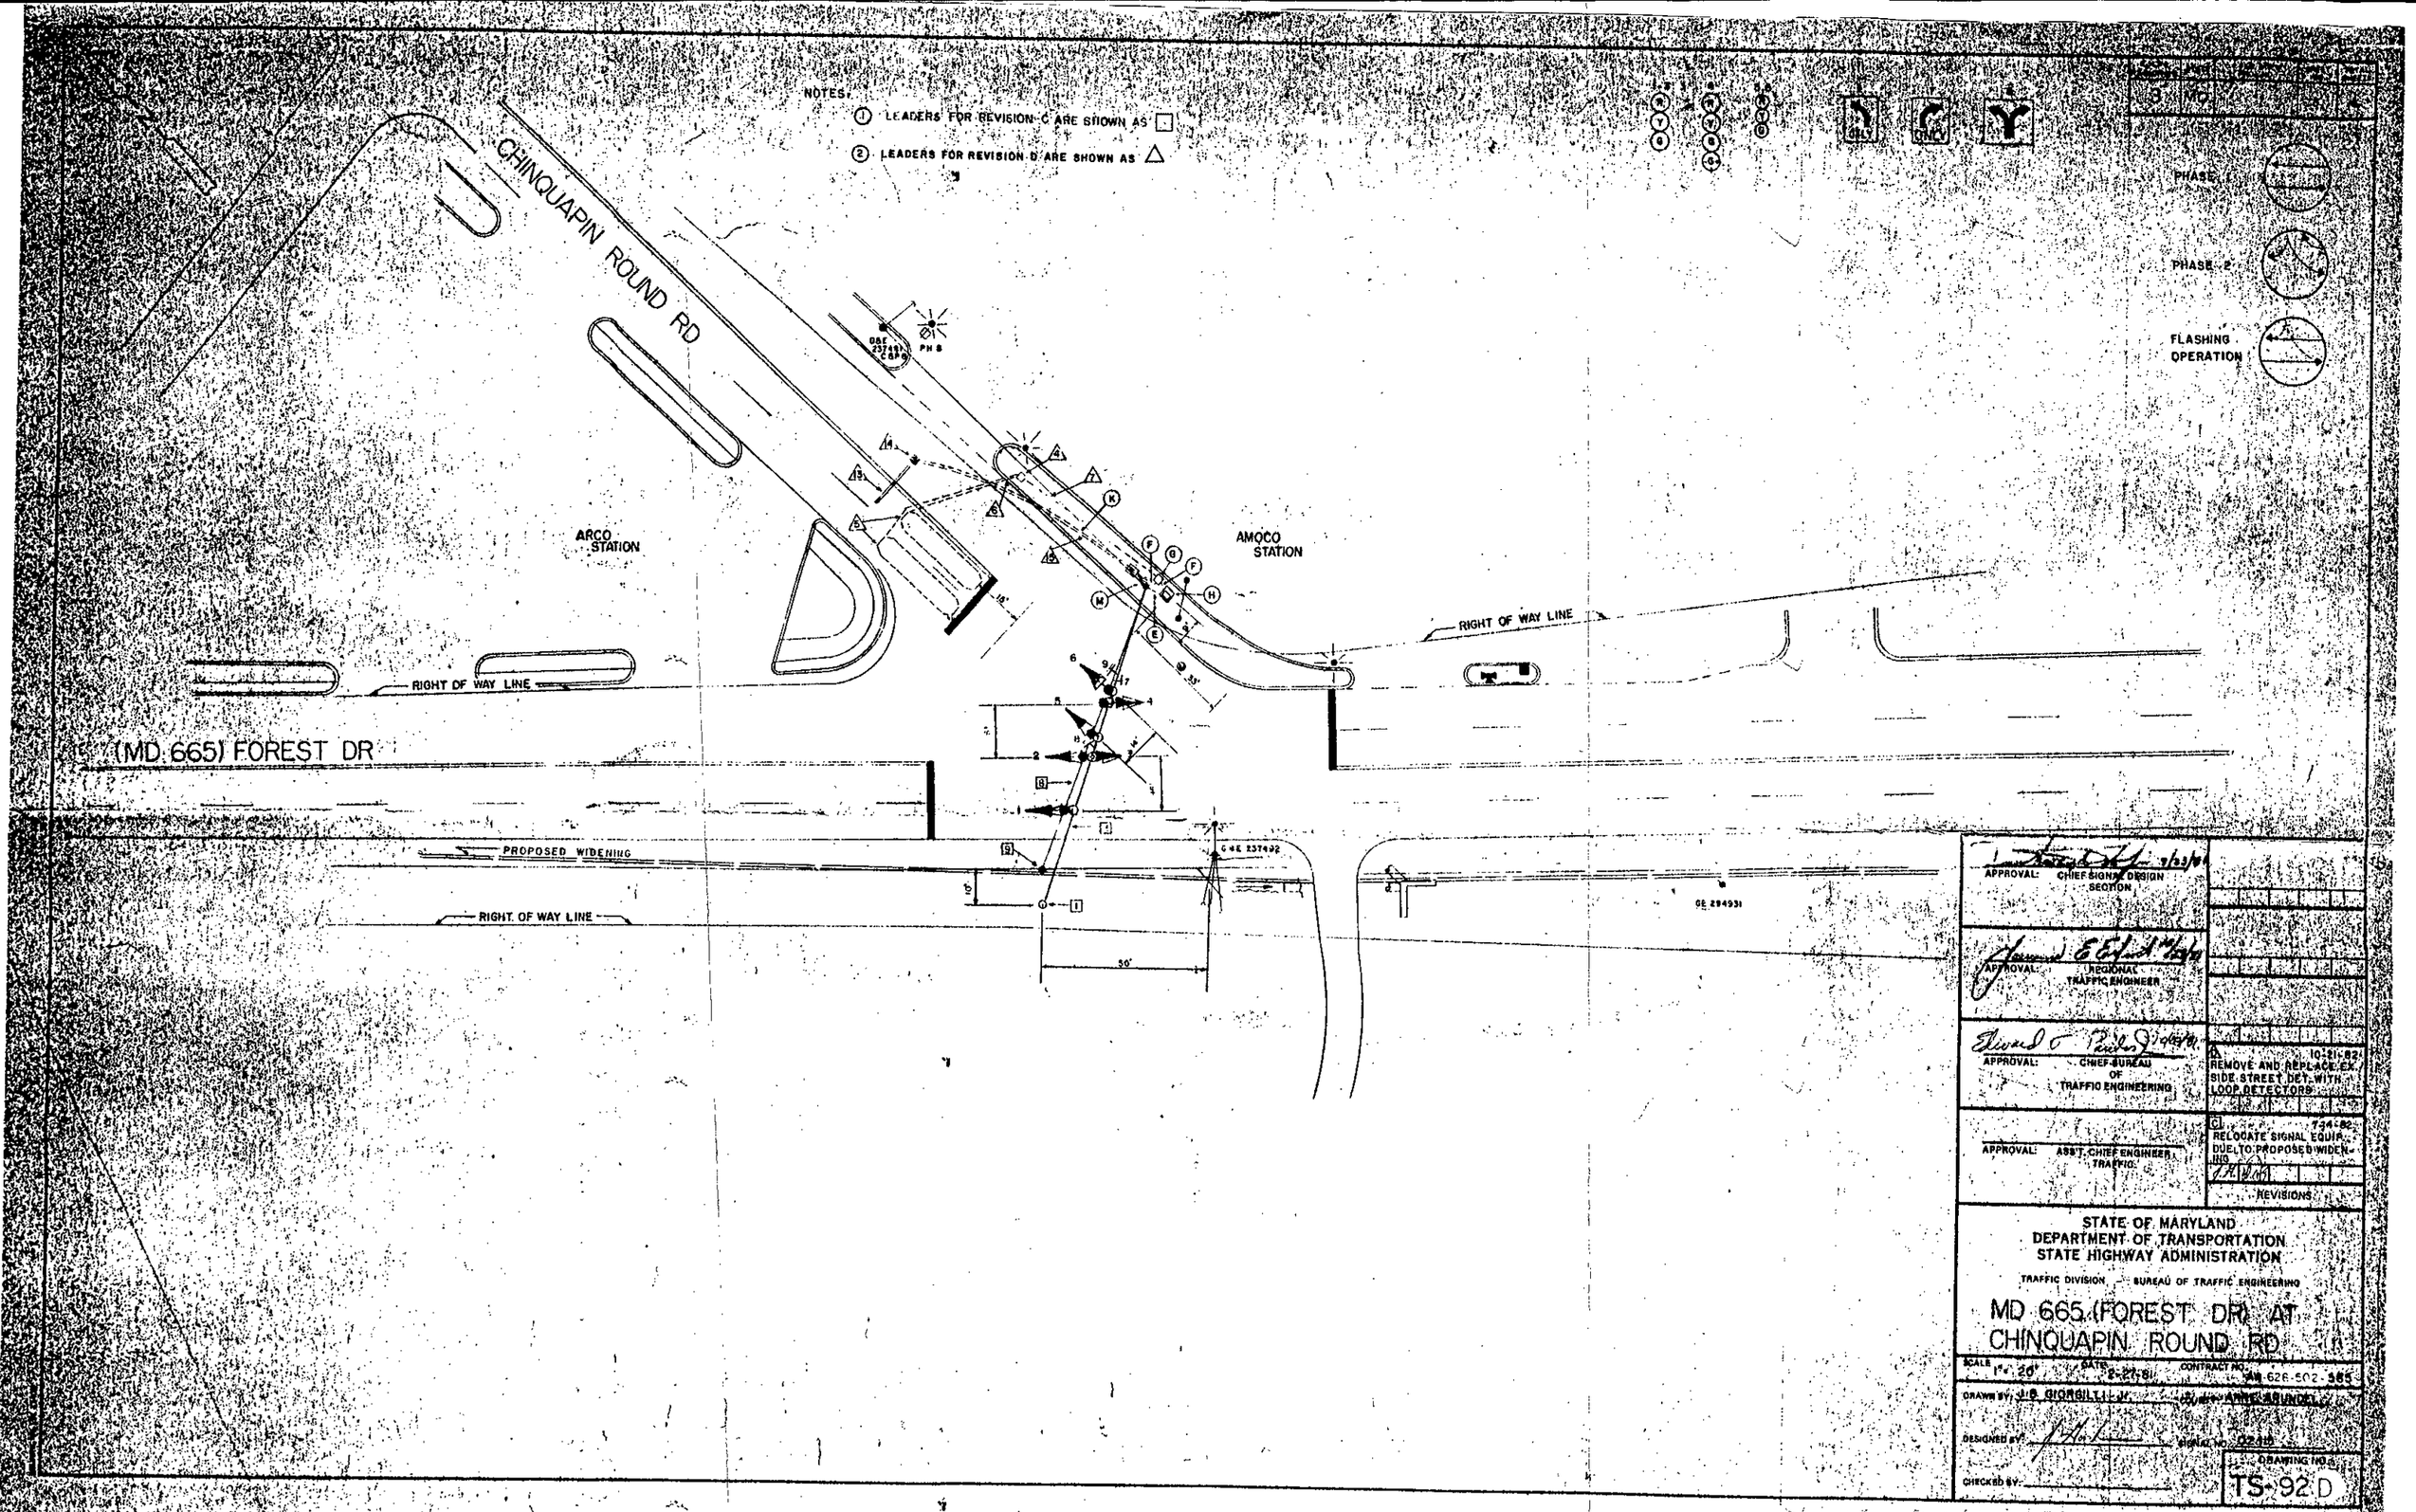
NOTES:
① LEADERS FOR REVISION C ARE SHOWN AS
② LEADERS FOR REVISION D ARE SHOWN AS
CHINQUAPIN ROUND RD
ARCO STATION
AMOCO STATION
RIGHT OF WAY LINE
(MD 665) FOREST DR
PROPOSED WIDENING
PHASE 1
PHASE 2
FLASHING OPERATION
APPROVAL: CHIEF SIGNAL DESIGN SECTION
APPROVAL: REGIONAL TRAFFIC ENGINEER
APPROVAL: CHIEF BUREAU OF TRAFFIC ENGINEERING
APPROVAL: ASS'T. CHIEF ENGINEER TRAFFIC
D 10-21-82 REMOVE AND REPLACE EX. SIDE STREET DET. WITH LOOP DETECTORS
C 7-14-82 RELOCATE SIGNAL EQUIP. DUE TO PROPOSED WIDENING
REVISIONS
STATE OF MARYLAND
DEPARTMENT OF TRANSPORTATION
STATE HIGHWAY ADMINISTRATION
TRAFFIC DIVISION — BUREAU OF TRAFFIC ENGINEERING
MD 665 (FOREST DR) AT CHINQUAPIN ROUND RD
SCALE 1" = 20'
DATE 2-27-81
CONTRACT NO. AA 626-502-385
DRAWN BY: J.B. GIORGILLI, JR.
DESIGNED BY:
SIGNAL NO. 02410
CHECKED BY:
DRAWING NO. TS-92 D

02065000.00