F.H.W.A. REGION NO.	STATE	FED. AID PROJ. NO.	SHEET NO.	TOTAL SHEETS
3	MD.	HES 000S (53)	23	32

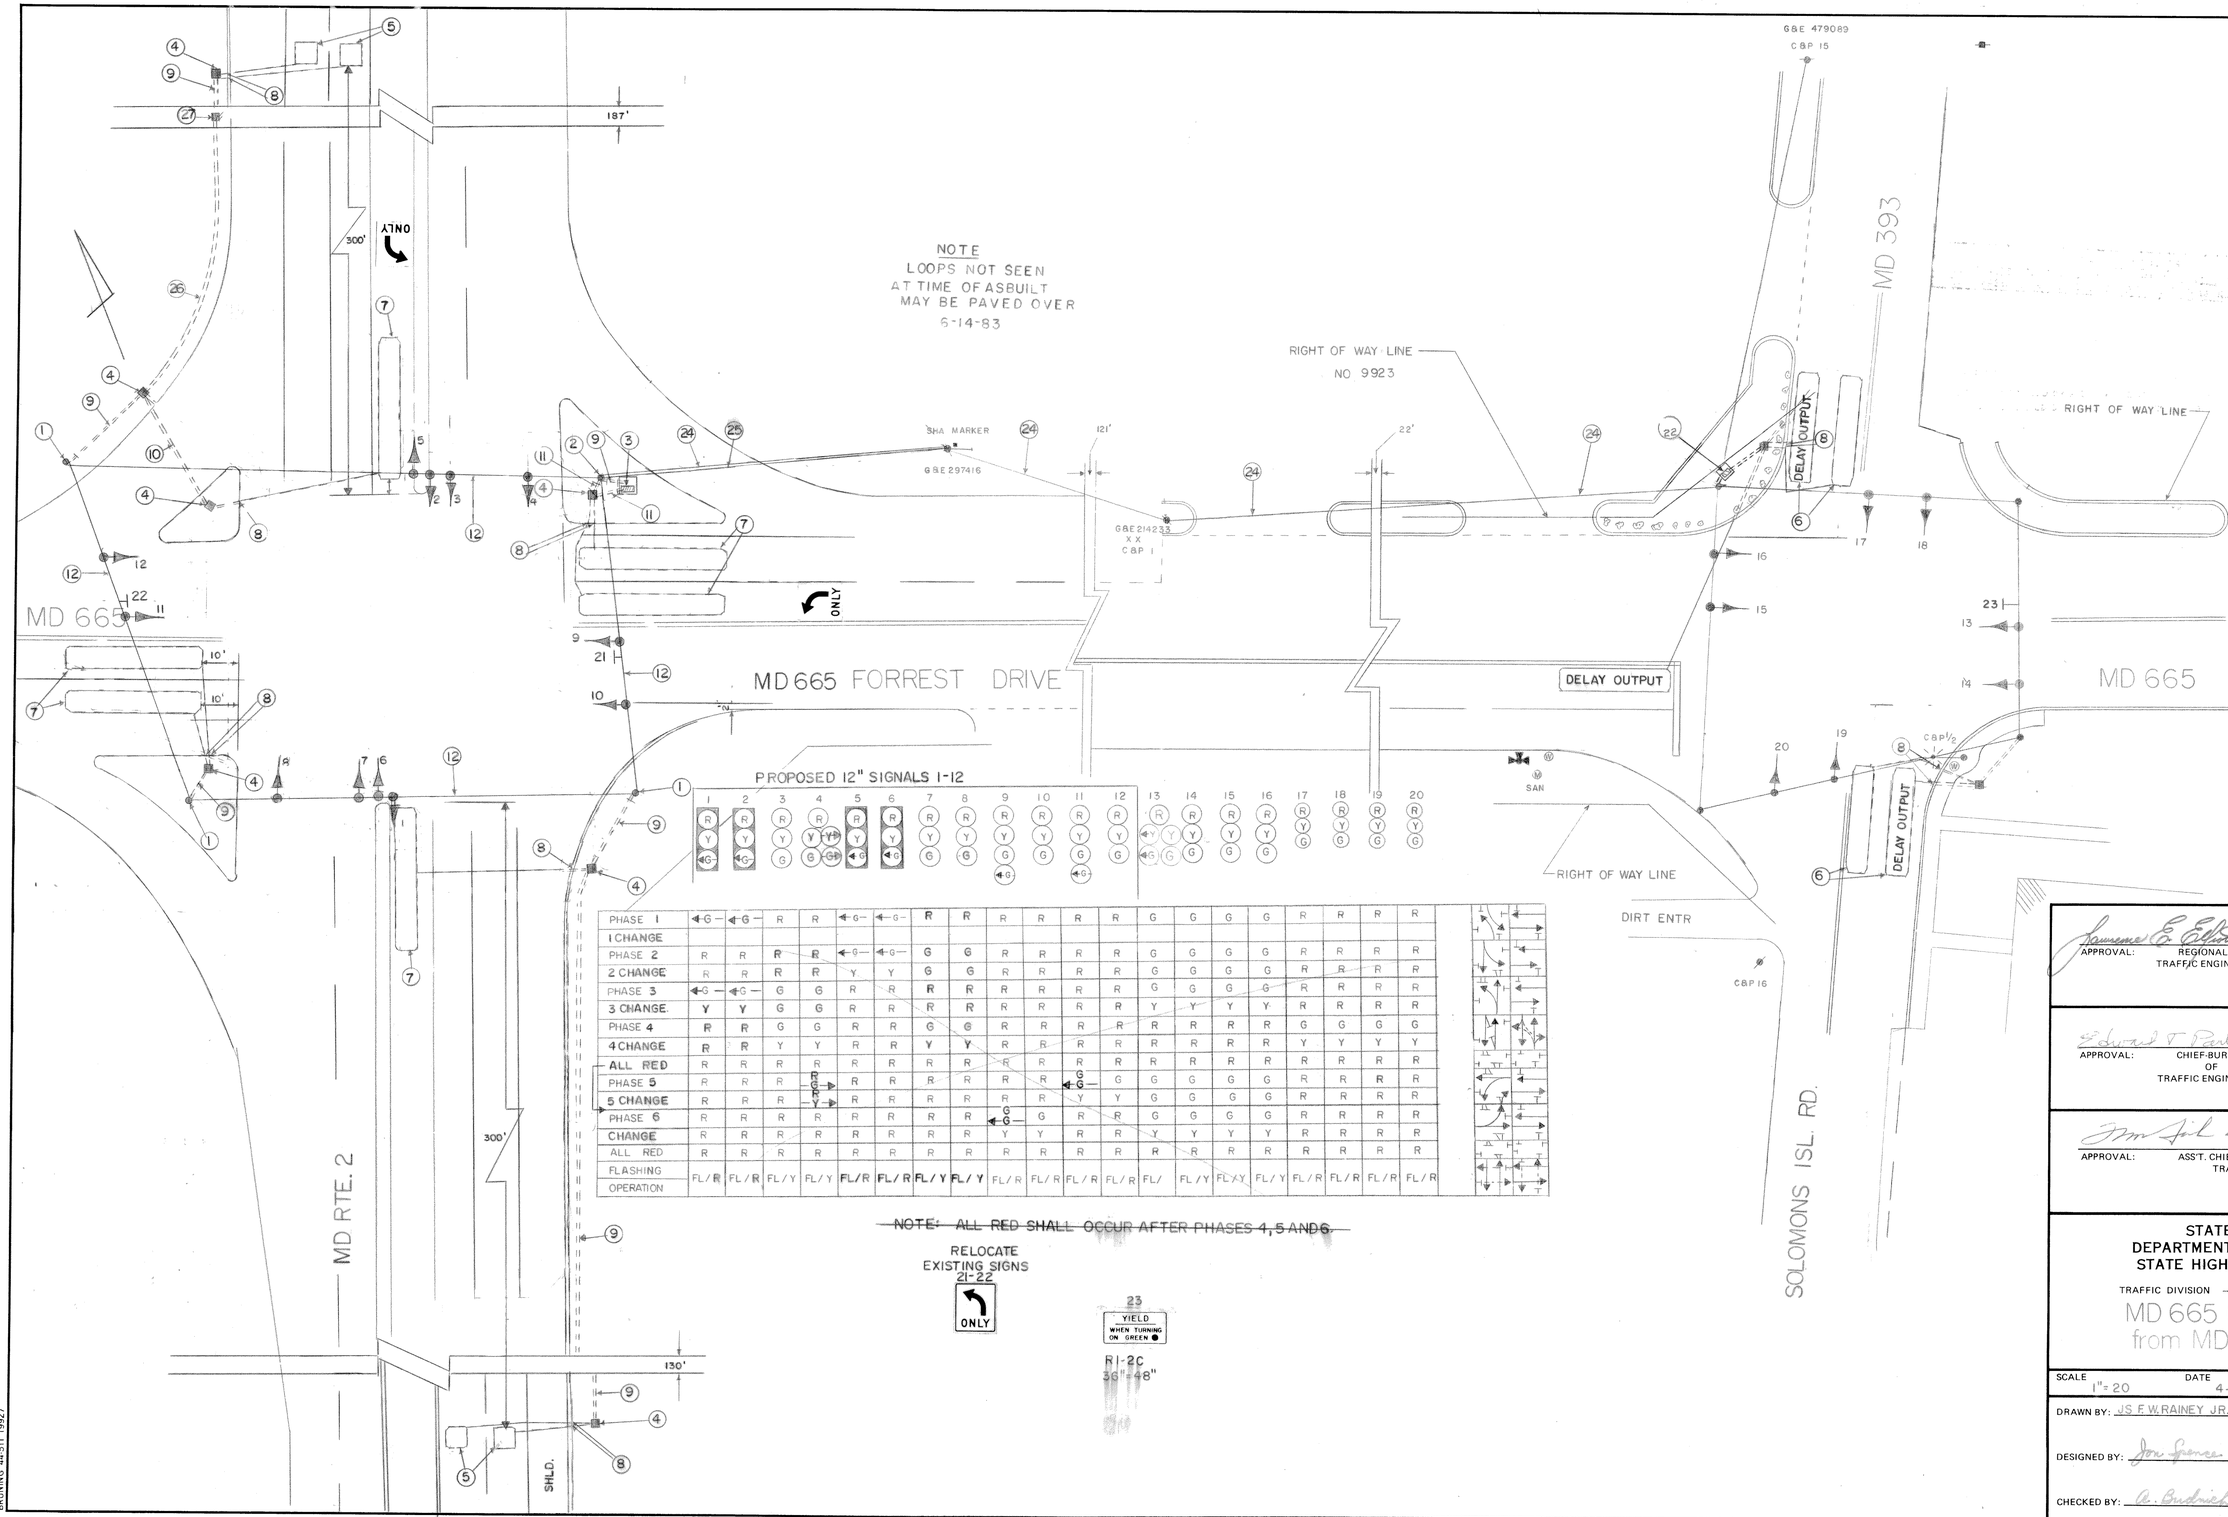

APPROVAL: REGIONAL TRAFFIC ENGINEER — Lawrence E. Elliott 4/23/74

APPROVAL: CHIEF-BUREAU OF TRAFFIC ENGINEERING — Edward T. Parker Jr.

APPROVAL: ASS'T. CHIEF ENGINEER TRAFFIC — 4/22/74

REVISIONS		
C	6-14-83	ASBUILT
B	11/24/81	NEW EQUIPMENT DUE TO NEW GEOMETRICS AA 216-501-577
A	3-13-74	AS-BUILT AA 841X-585

STATE OF MARYLAND
DEPARTMENT OF TRANSPORTATION
STATE HIGHWAY ADMINISTRATION

TRAFFIC DIVISION – BUREAU OF TRAFFIC ENGINEERING

MD 665 (FORREST DR)
from MD 2 to MD 393

SCALE 1" = 20 | DATE 4-23-74 | CONTRACT NO.

DRAWN BY: J.S. F.W. RAINEY JR. | COUNTY: ANNE ARUNDEL

DESIGNED BY: Don Spence | SIGNAL NO.: 020218 02009

CHECKED BY: A. Budniechuk

DRAWING NO. TS- 71C

BRUNING 44-511 19927