K&E BALTIMORE 17 0153 PHOENIX 10-75 MC 4156

F.H.W.A. REGION NO.	STATE	FED. AID PROJ. NO.	SHEET NO.	TOTAL SHEETS
3	MD.		2	5

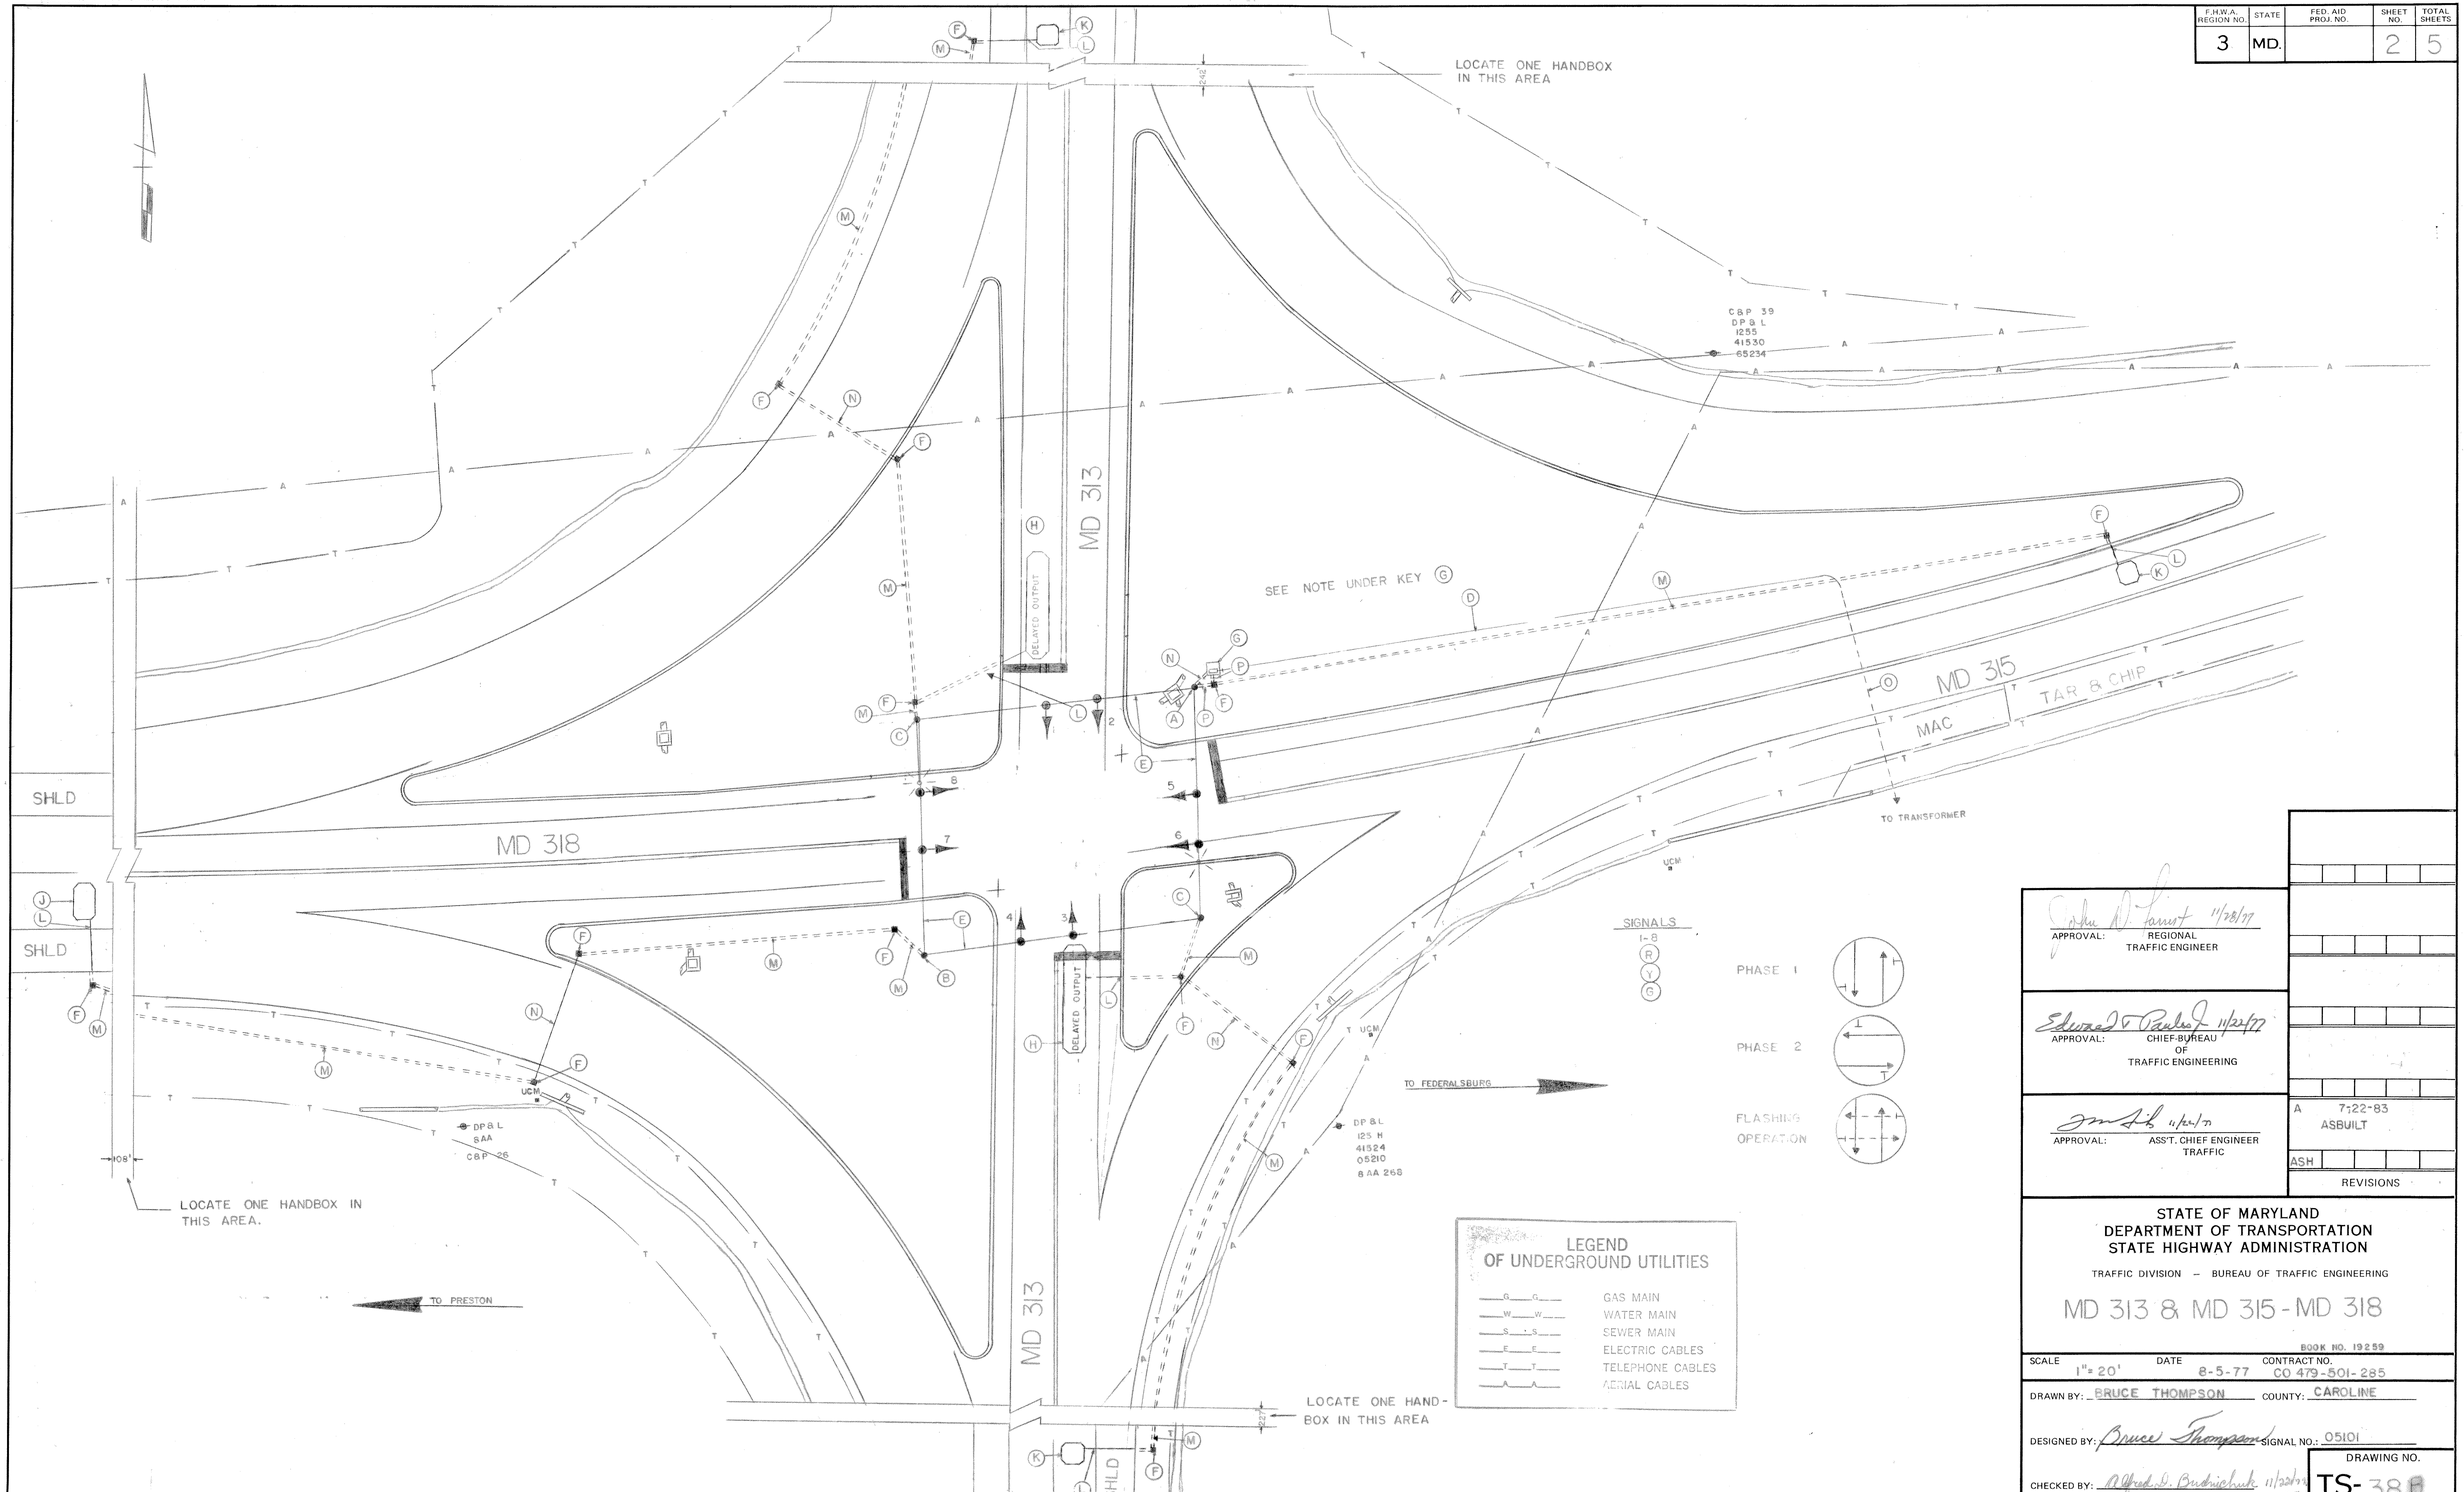

APPROVAL: REGIONAL TRAFFIC ENGINEER — 11/28/77

APPROVAL: CHIEF-BUREAU OF TRAFFIC ENGINEERING — 11/28/77

APPROVAL: ASS'T. CHIEF ENGINEER TRAFFIC — 11/28/77

A	7-22-83 ASBUILT
ASH	

REVISIONS

STATE OF MARYLAND
DEPARTMENT OF TRANSPORTATION
STATE HIGHWAY ADMINISTRATION

TRAFFIC DIVISION – BUREAU OF TRAFFIC ENGINEERING

MD 313 & MD 315 - MD 318

BOOK NO. 19259

SCALE 1" = 20' | DATE 8-5-77 | CONTRACT NO. CO 479-501-285

DRAWN BY: BRUCE THOMPSON | COUNTY: CAROLINE

DESIGNED BY: Bruce Thompson | SIGNAL NO.: 05101

CHECKED BY: Alfred D. Budnichuk 11/28/77

DRAWING NO. TS-38B