
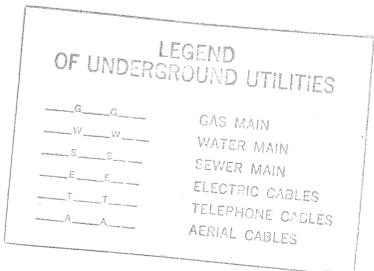
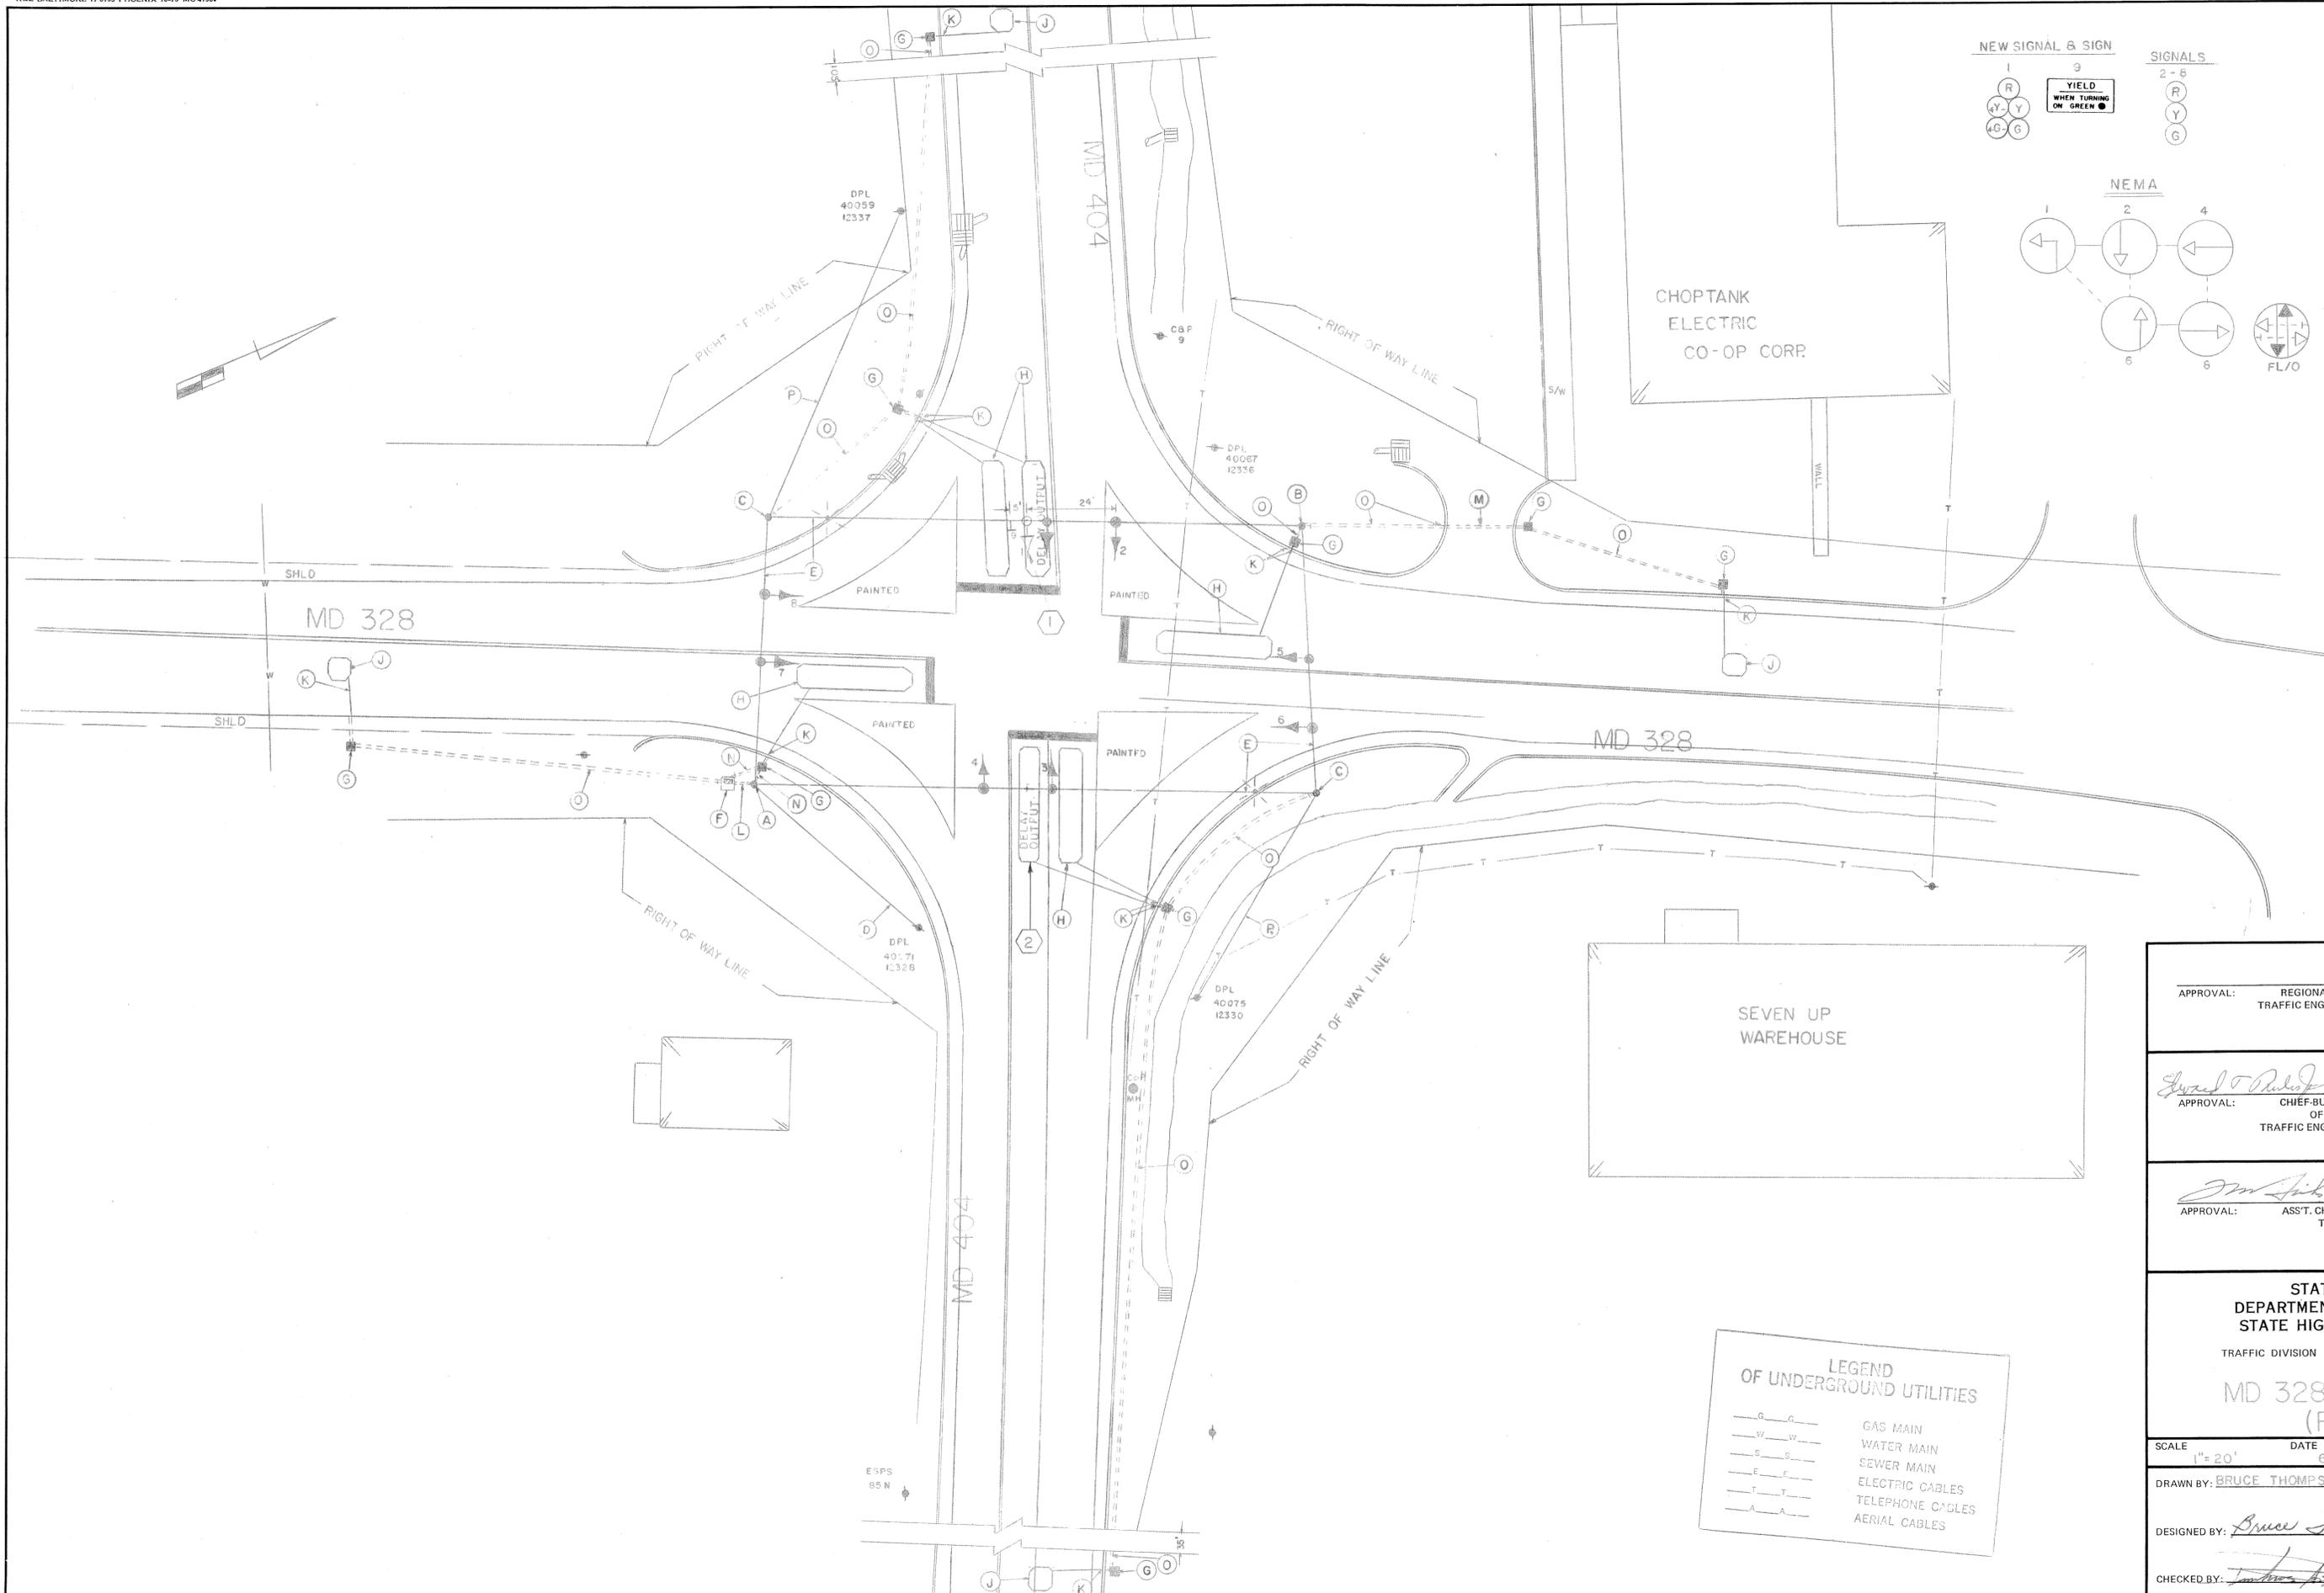


F.H.W.A. REGION NO.	STATE	FED. AID PROJ. NO.	SHEET NO.	TOTAL SHEETS
3	MD.		2	5

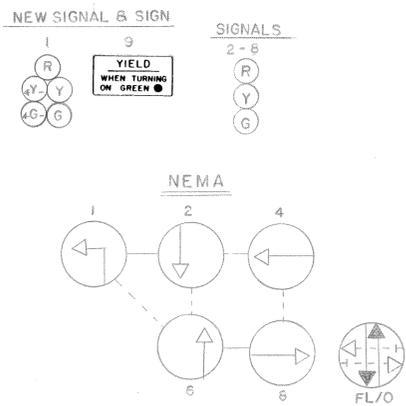

APPROVAL: REGIONAL TRAFFIC ENGINEER	
APPROVAL: CHIEF-BUREAU OF TRAFFIC ENGINEERING <i>Edward P. DeLoach 12/3/79</i>	(B) 6/84 ADDED E/P LEFT TURN SHA 855-26000 DCD [initials]
APPROVAL: ASS'T. CHIEF ENGINEER TRAFFIC <i>Tom [initials] 12/5/79</i>	A. 7-13-81 ASBULT CO 503-501-285 G.T. [initials]
REVISIONS	

STATE OF MARYLAND
 DEPARTMENT OF TRANSPORTATION
 STATE HIGHWAY ADMINISTRATION
 TRAFFIC DIVISION - BUREAU OF TRAFFIC ENGINEERING

MD 328 & MD 404
 (RELOCATED)

SCALE: 1" = 20' DATE: 6-20-79 CONTRACT NO.

DRAWN BY: BRUCE THOMPSON COUNTY: CAROLINE

DESIGNED BY: Bruce Thompson SIGNAL NO.: 05110

CHECKED BY: [initials] 12/19/79 DRAWING NO.: TS-1718 B