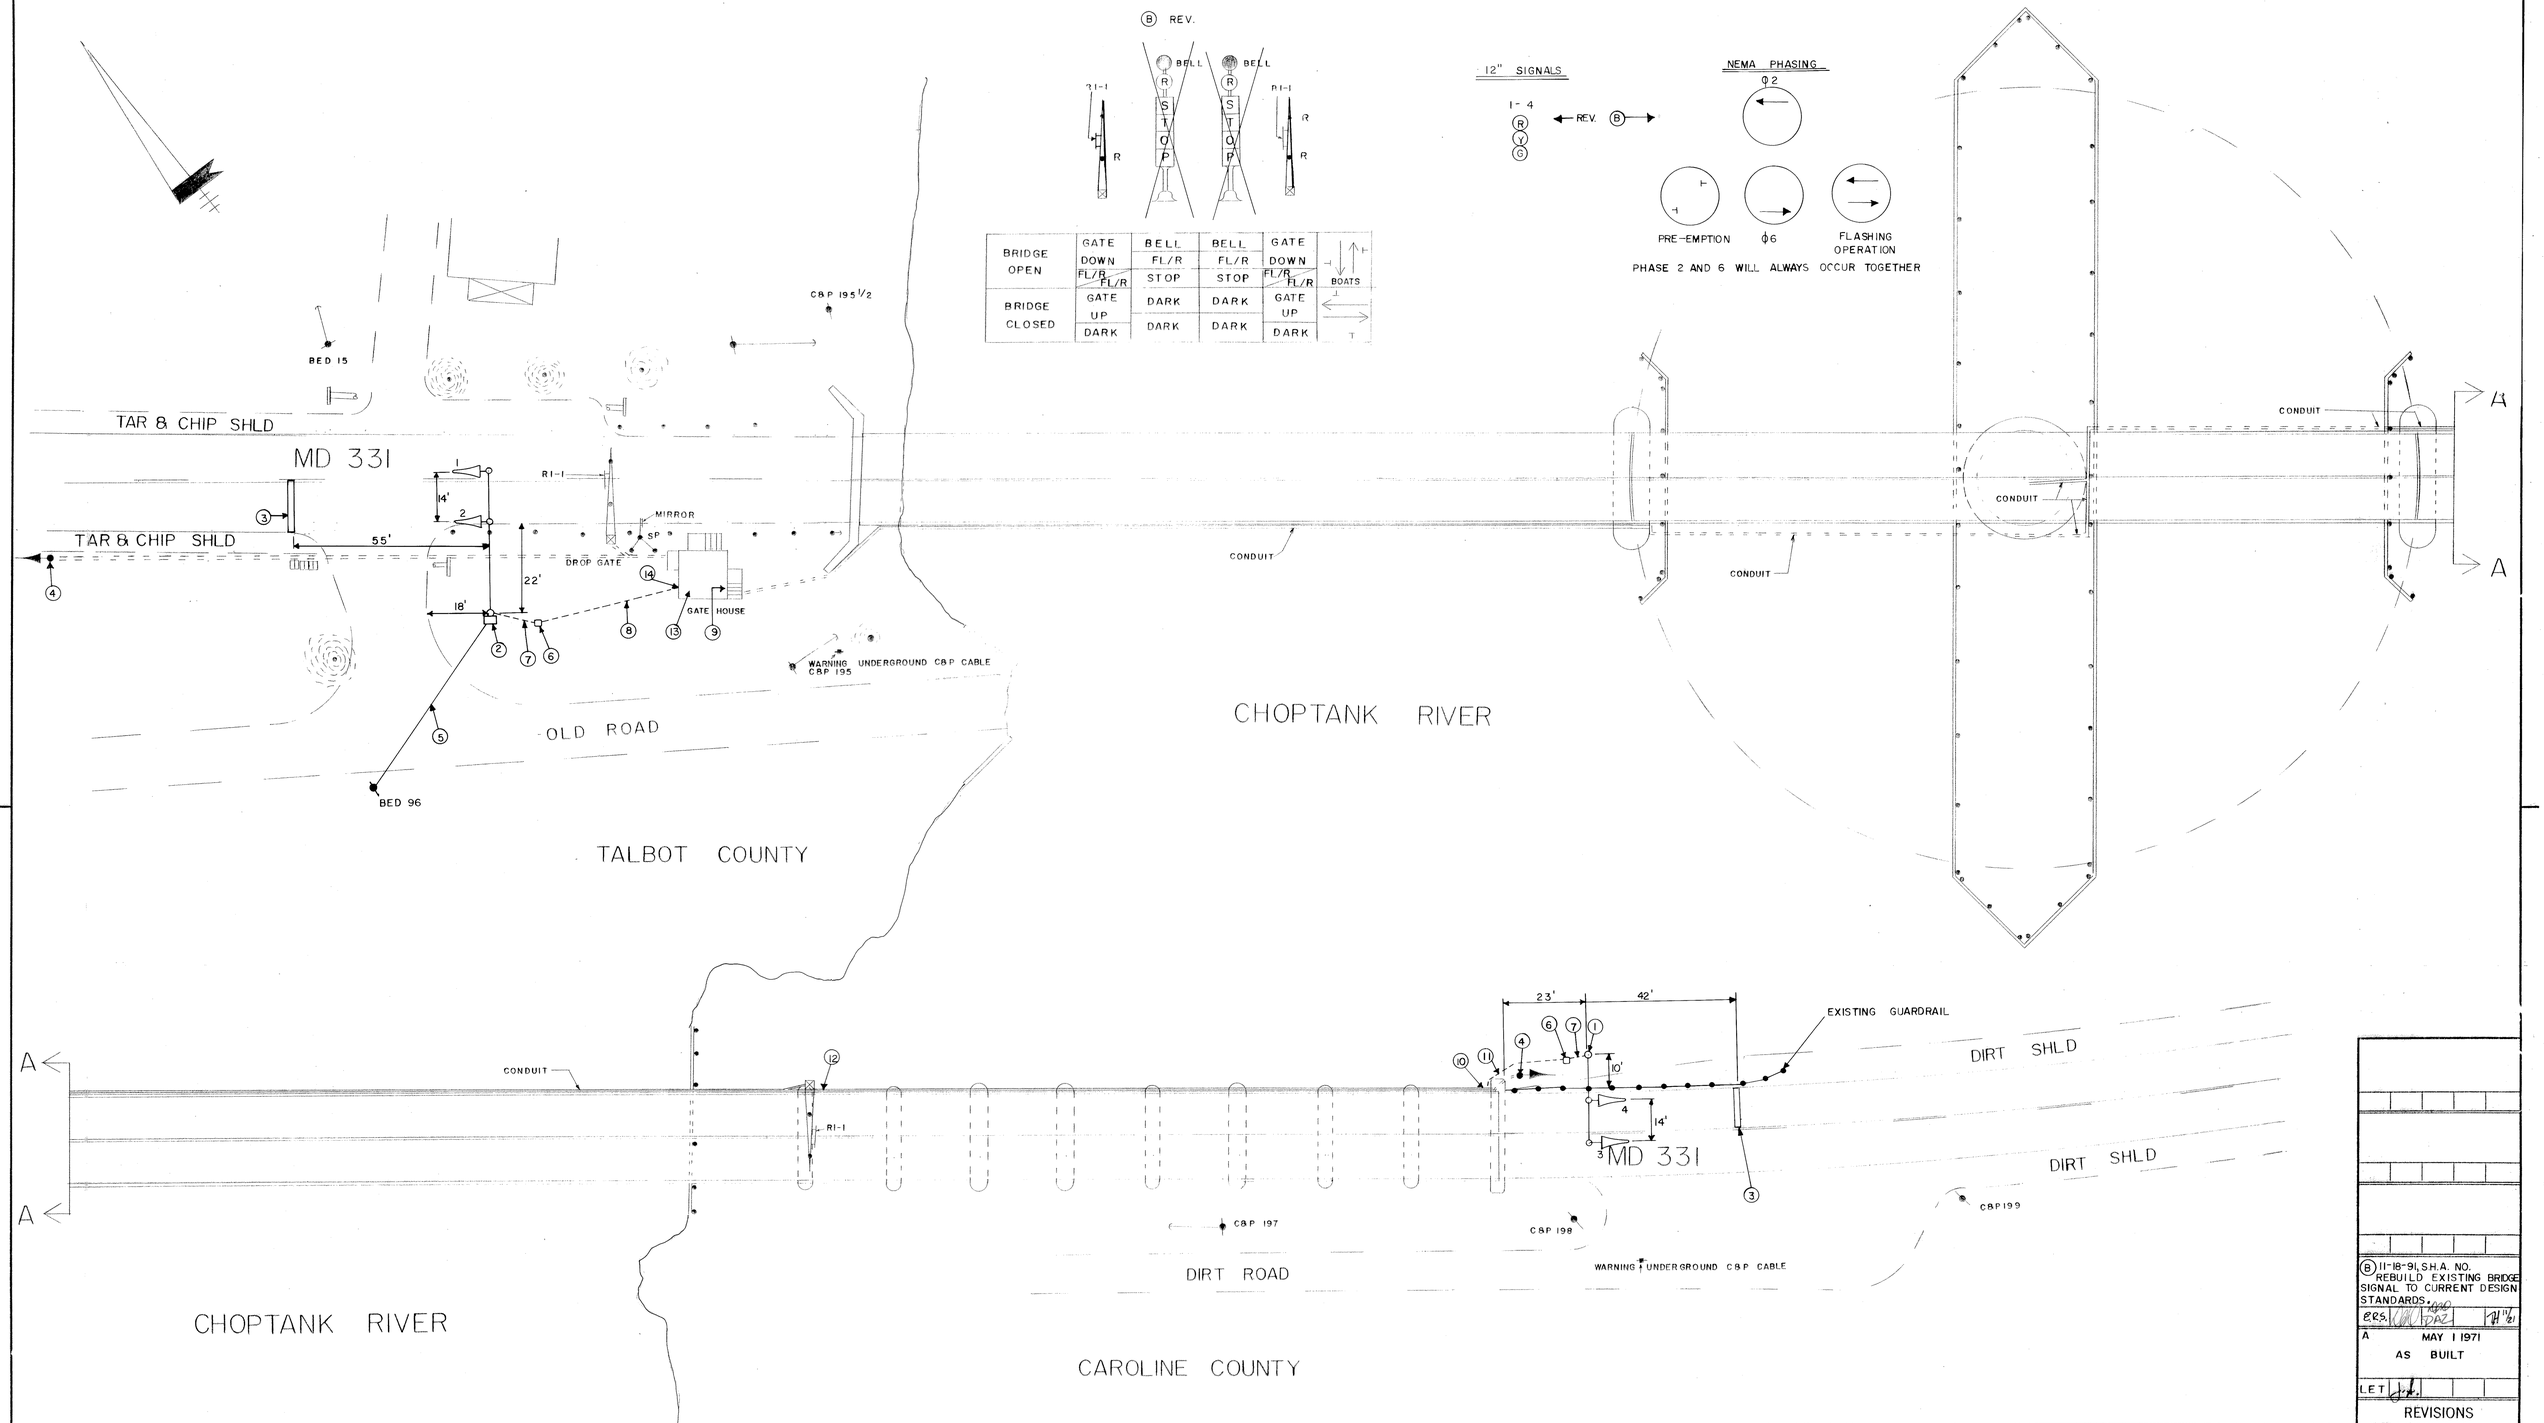

(B)	11-18-91, S.H.A. NO. REBUILD EXISTING BRIDGE SIGNAL TO CURRENT DESIGN STANDARDS.
E.R.S.	
A	MAY 1 1971 AS BUILT
L.E.T.	

REVISIONS

APPROVAL: CHIEF - BUREAU OF TRAFFIC ENGINEERING

APPROVAL: ASS'T CHIEF ENGINEER TRAFFIC SAFETY

MARYLAND DEPARTMENT OF TRANSPORTATION
STATE HIGHWAY ADMINISTRATION - OFFICE OF TRAFFIC & SAFETY
TRAFFIC ENGINEERING DESIGN DIVISION

MD 331 & DOVER BRIDGE OVER CHOPTANK

DATE: MAY 1, 1971
SCALE: 1" = 20'
DRAWN BY: LES TOWNSEND
CONTRACT NO.
COUNTY: TALBOT & CAROLINE
CHECKED BY:

DRAWING NO. TS 345 (B)