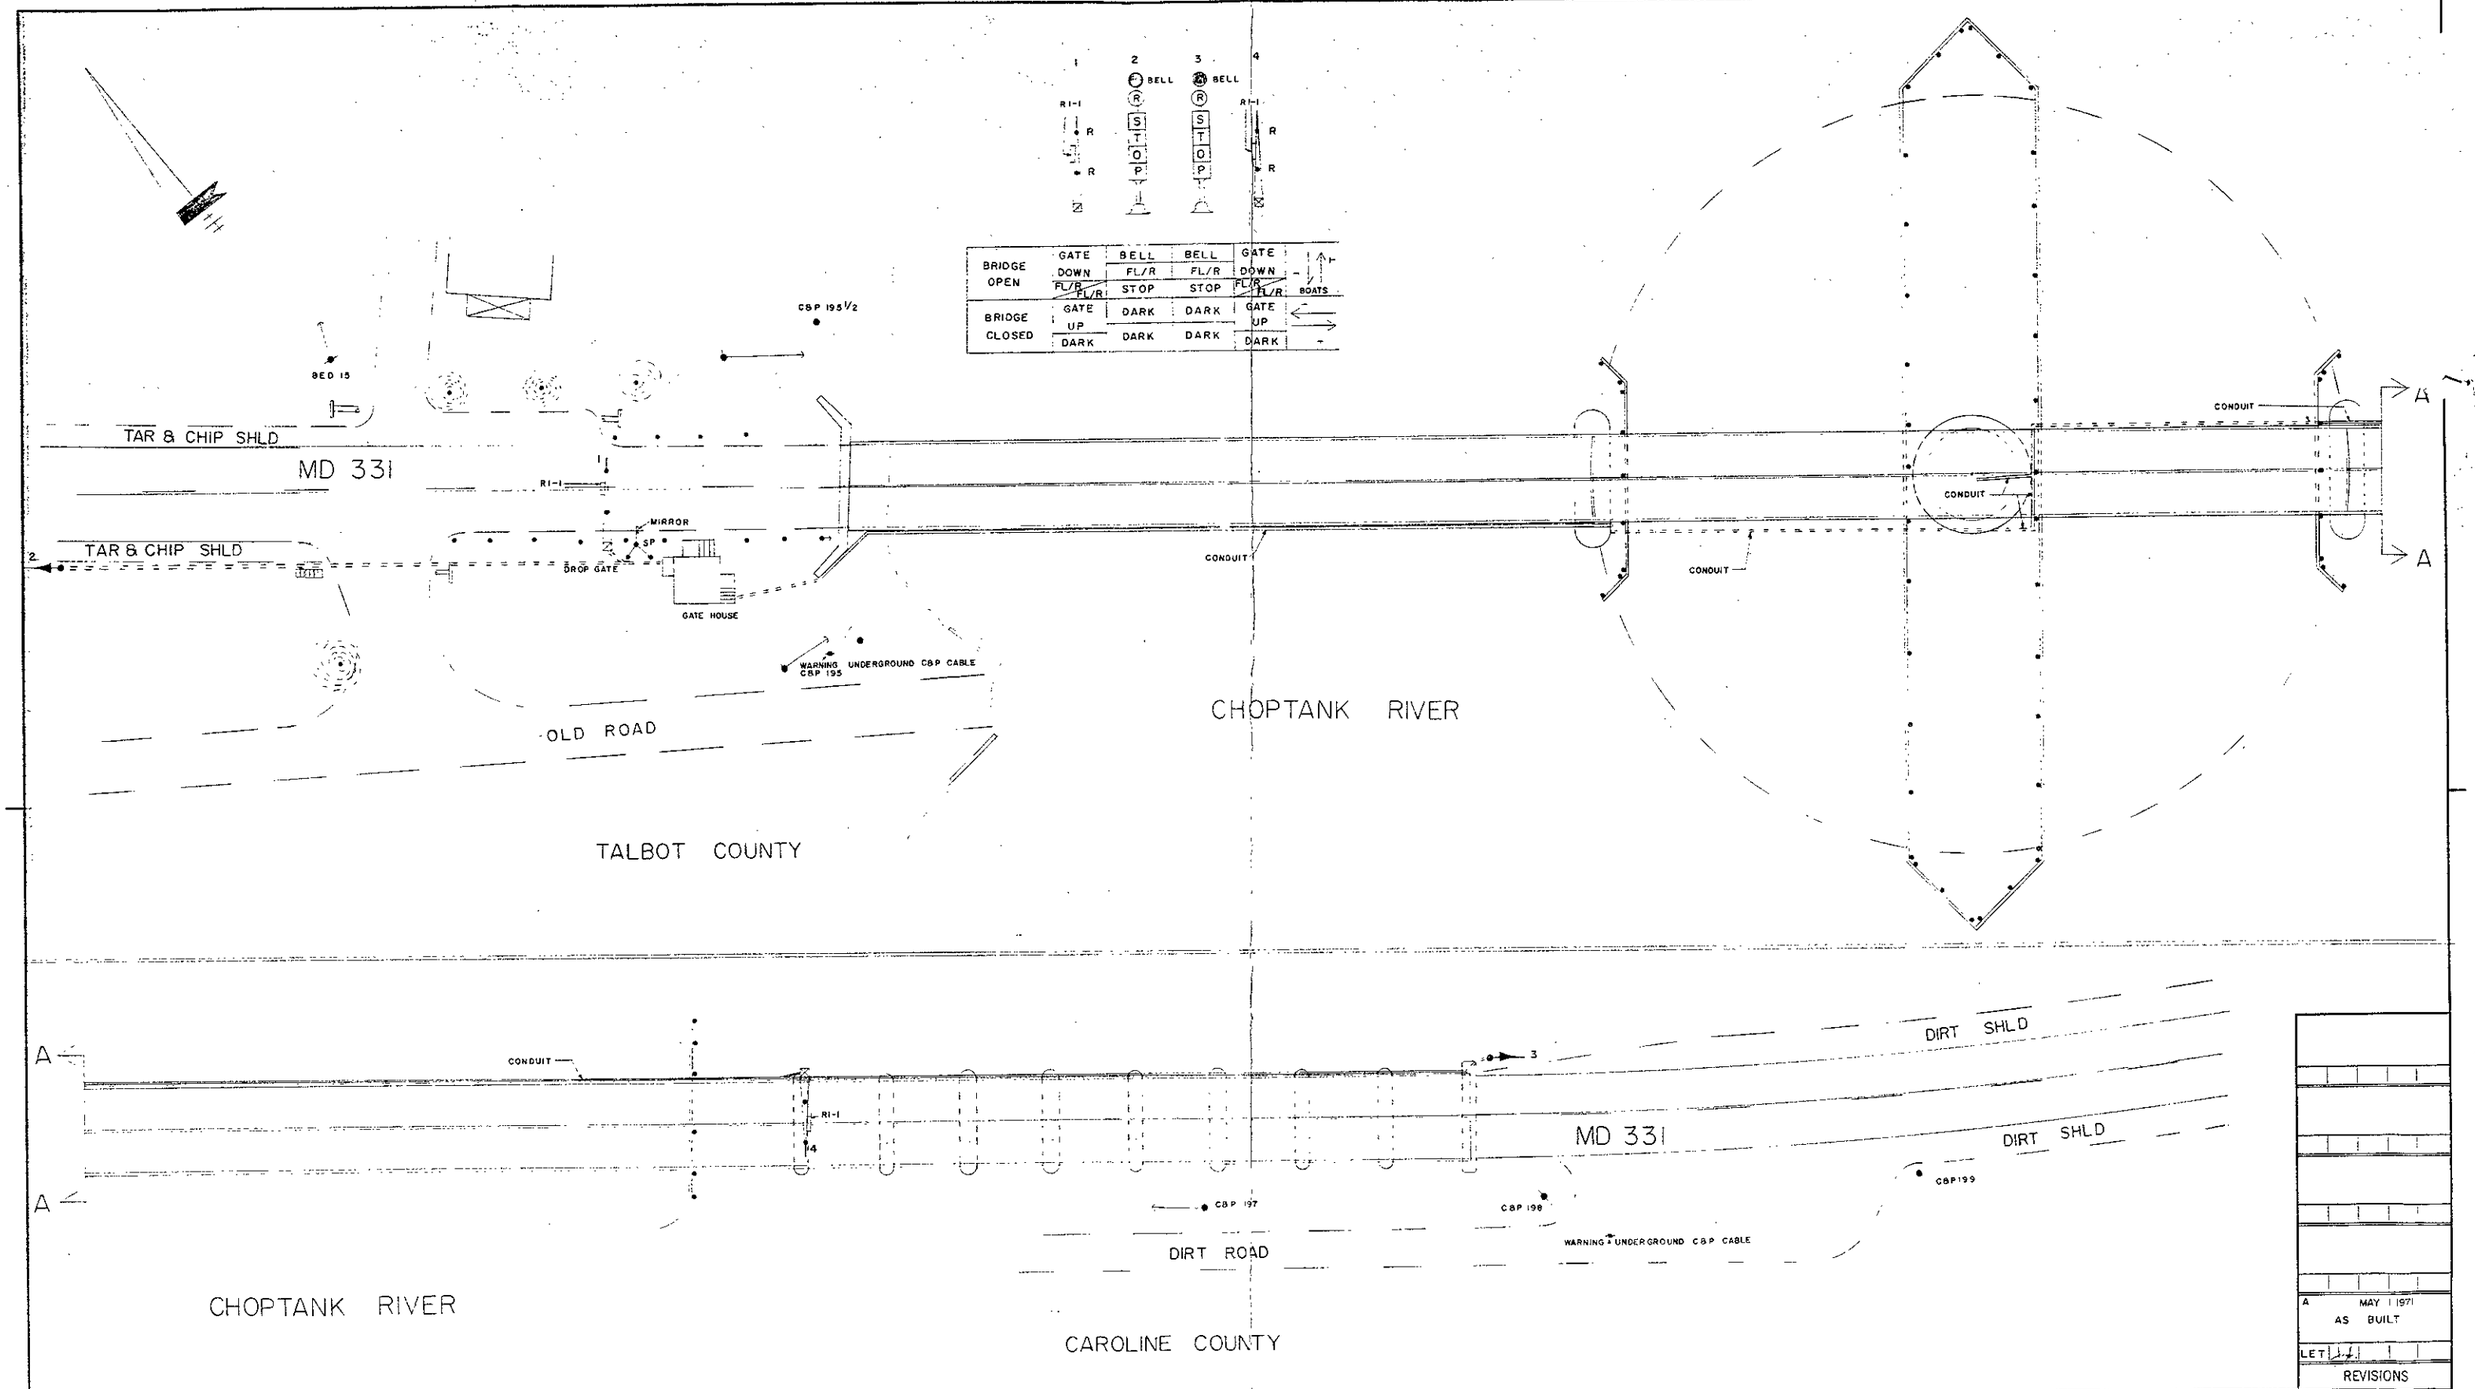

BRIDGE OPEN	GATE DOWN FL/R FL/R	BELL FL/R STOP	BELL FL/R STOP	GATE DOWN FL/R FL/R	BOATS
BRIDGE CLOSED	GATE UP DARK	DARK DARK	DARK DARK	GATE UP DARK	

A MAY 1 1971 AS BUILT

LET

REVISIONS

APPROVAL: CHIEF - BUREAU OF TRAFFIC ENGINEERING

APPROVAL: ASS'T CHIEF ENGINEER TRAFFIC SAFETY

MARYLAND STATE ROADS COMMISSION
DIVISION OF TRAFFIC SAFETY
BUREAU OF TRAFFIC ENGINEERING

MD 331 & DOVER BRIDGE OVER CHOPTANK

DATE MAY 1, 1971
SCALE 1" = 20'
DRAWN BY: LES TOWNSEND
CONTRACT NO
COUNTY TALBOT & CAROLINE
CHECKED BY:

DRAWING NO. TS 345 A

05033107.55