OFFICE OF TRAFFIC
TRAFFIC CONTROL DEVICE
STAR PROJECT

DATE: 2-10-92

LOCATION: MD 404 @ MD 313 (WEST) COUNTY: CAROLINE

CONTRACT NO: ~~OT-143-92~~ 855-2504005 PHASING: ICB

PEDESTRIANS: N/A ACTUATION: N/A

SIGNING: N/A LIGHTING: YES

R/W STAKEOUT: DISTRICT #2 UTILITY STAKEOUT: YES

ATTENDEES:

T.E.D.	T.O.D.
S. RENZI	S. BROWN

DIST.	UTILITY REP.
R. KIEL	CHOPTANK
	BOB SUMP

CONTRACTOR: HAWKINS

AWARD DATE:

N.T.P.

WORKING DAYS:

EXPECTED COMPLETION DATE:

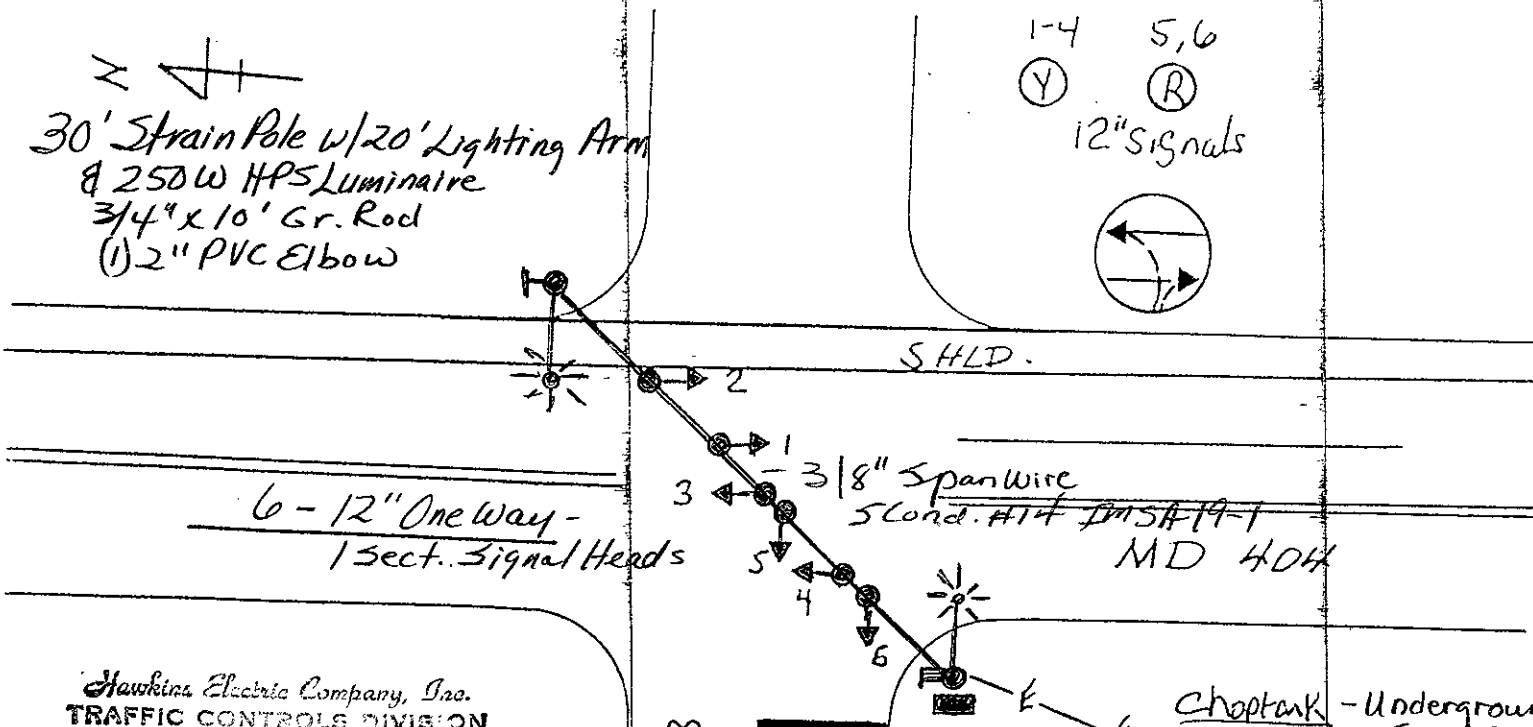

Hawkins Electric Company, Inc.
TRAFFIC CONTROLS DIVISION

CC:		
	T.E.D.	White
	CONTRACTOR	Yellow
	T.O.D.	Pink
	DISTRICT	Gold

FOR ADDITIONAL REMARKS SEE ATTS. ☒

APPROVALS:

T.E.D.

T.O.D.