F.H.WA. REGION NO.	STATE	FED. AID PROJ. NO.	SHEET NO.	TOTAL SHEETS
3	MD.		1	1

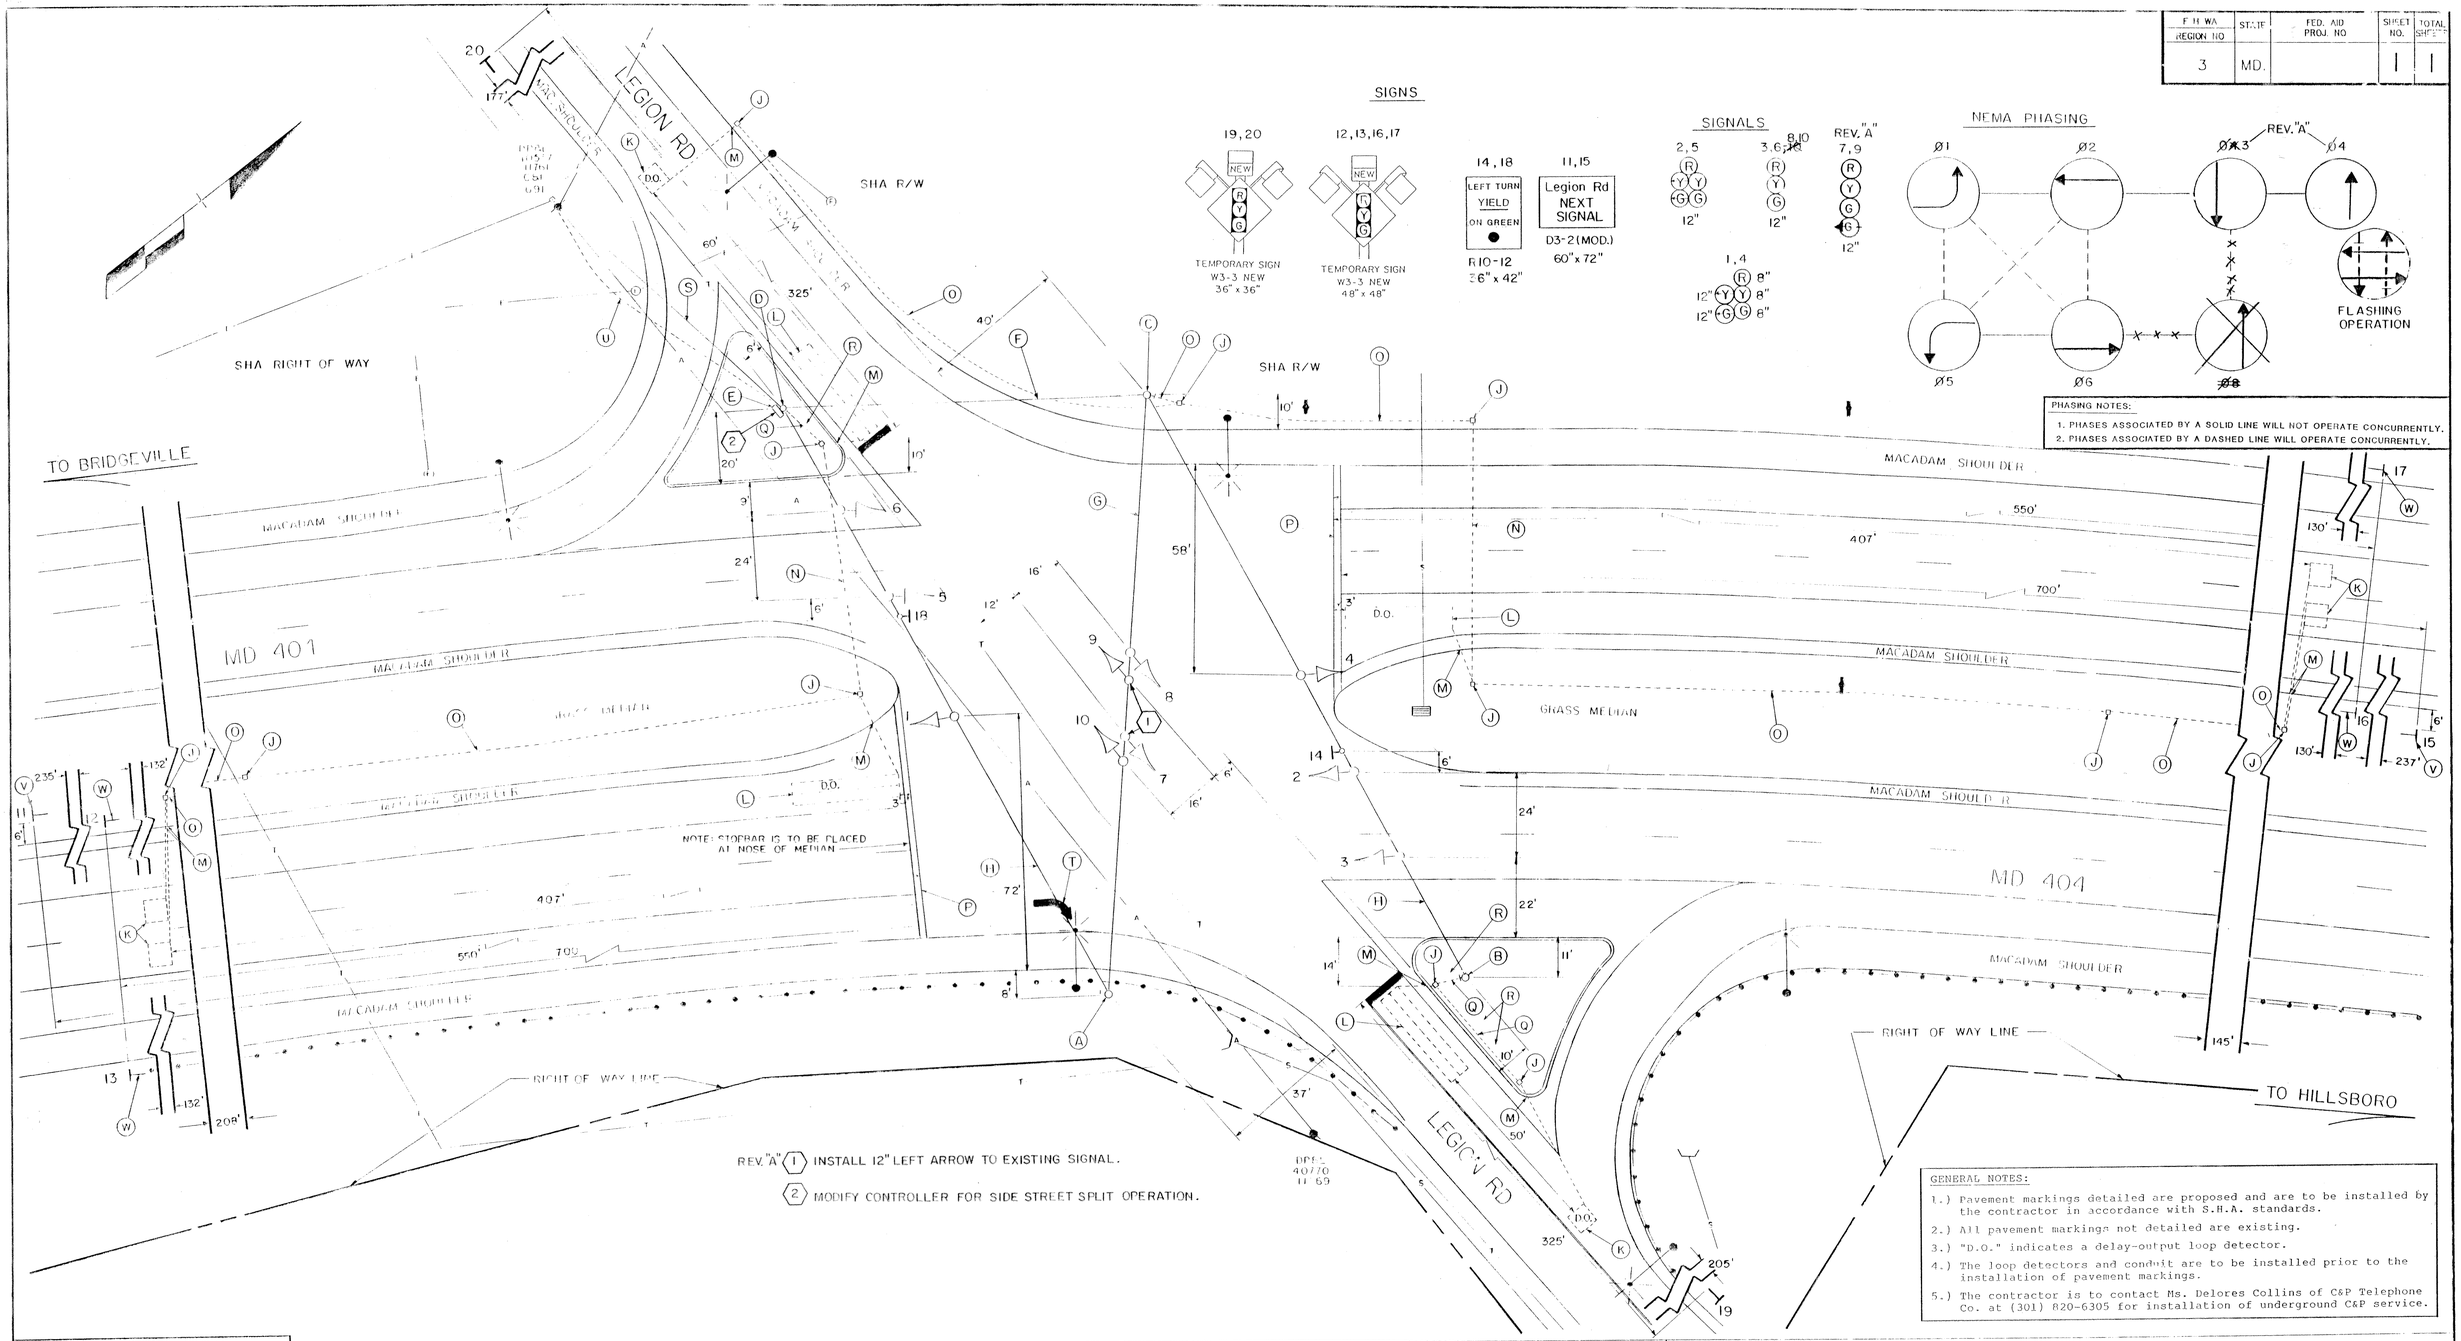

LEGEND OF UNDERGROUND AND OVERHEAD UTILITIES

AERIAL CABLE
ELECTRIC
TELEPHONE
GAS
SEWER
WATER
CATV

STREET TRAFFIC STUDIES, LTD.
Suite 295, Commercentre East
1777 Reisterstown Road
Baltimore, Maryland 21208

REVISIONS	APPROVALS
(A) 1-19-93 SPLIT SIDE STREET DJD	CHIEF, SIGNAL DESIGN SECTION 1/20/88
	ASST. DIST. ENGINEER, TRAFFIC 1/26/88
	CHIEF, BUREAU OF TRAFFIC ENGINEERING 1-27-88
	DEPUTY CHIEF ENGINEER, OFFICE OF TRAFFIC 1/27/88

MARYLAND DEPARTMENT OF TRANSPORTATION
STATE HIGHWAY ADMINISTRATION – OFFICE OF TRAFFIC
BUREAU OF TRAFFIC ENGINEERING

DRAWN BY: W. JAMES (FOR STS)
DES. BY: R.R. ZACHERL (FOR STS)
CHK. BY:
DATE: 9-23-87
SCALE: 1" = 20'
F.A.P. NO.
S.H.A. NO. CO-321-505-270

MD 404 AND LEGION RD (md 619B)

COUNTY: CAROLINE

TS/FILE NO. 2400A

SHEET NO. 1 OF 1

05040409.30

F#19