F H WA REGION NO	STATE	FED. AID PROJ. NO	SHEET NO.	TOTAL SHEETS
3	MD.			

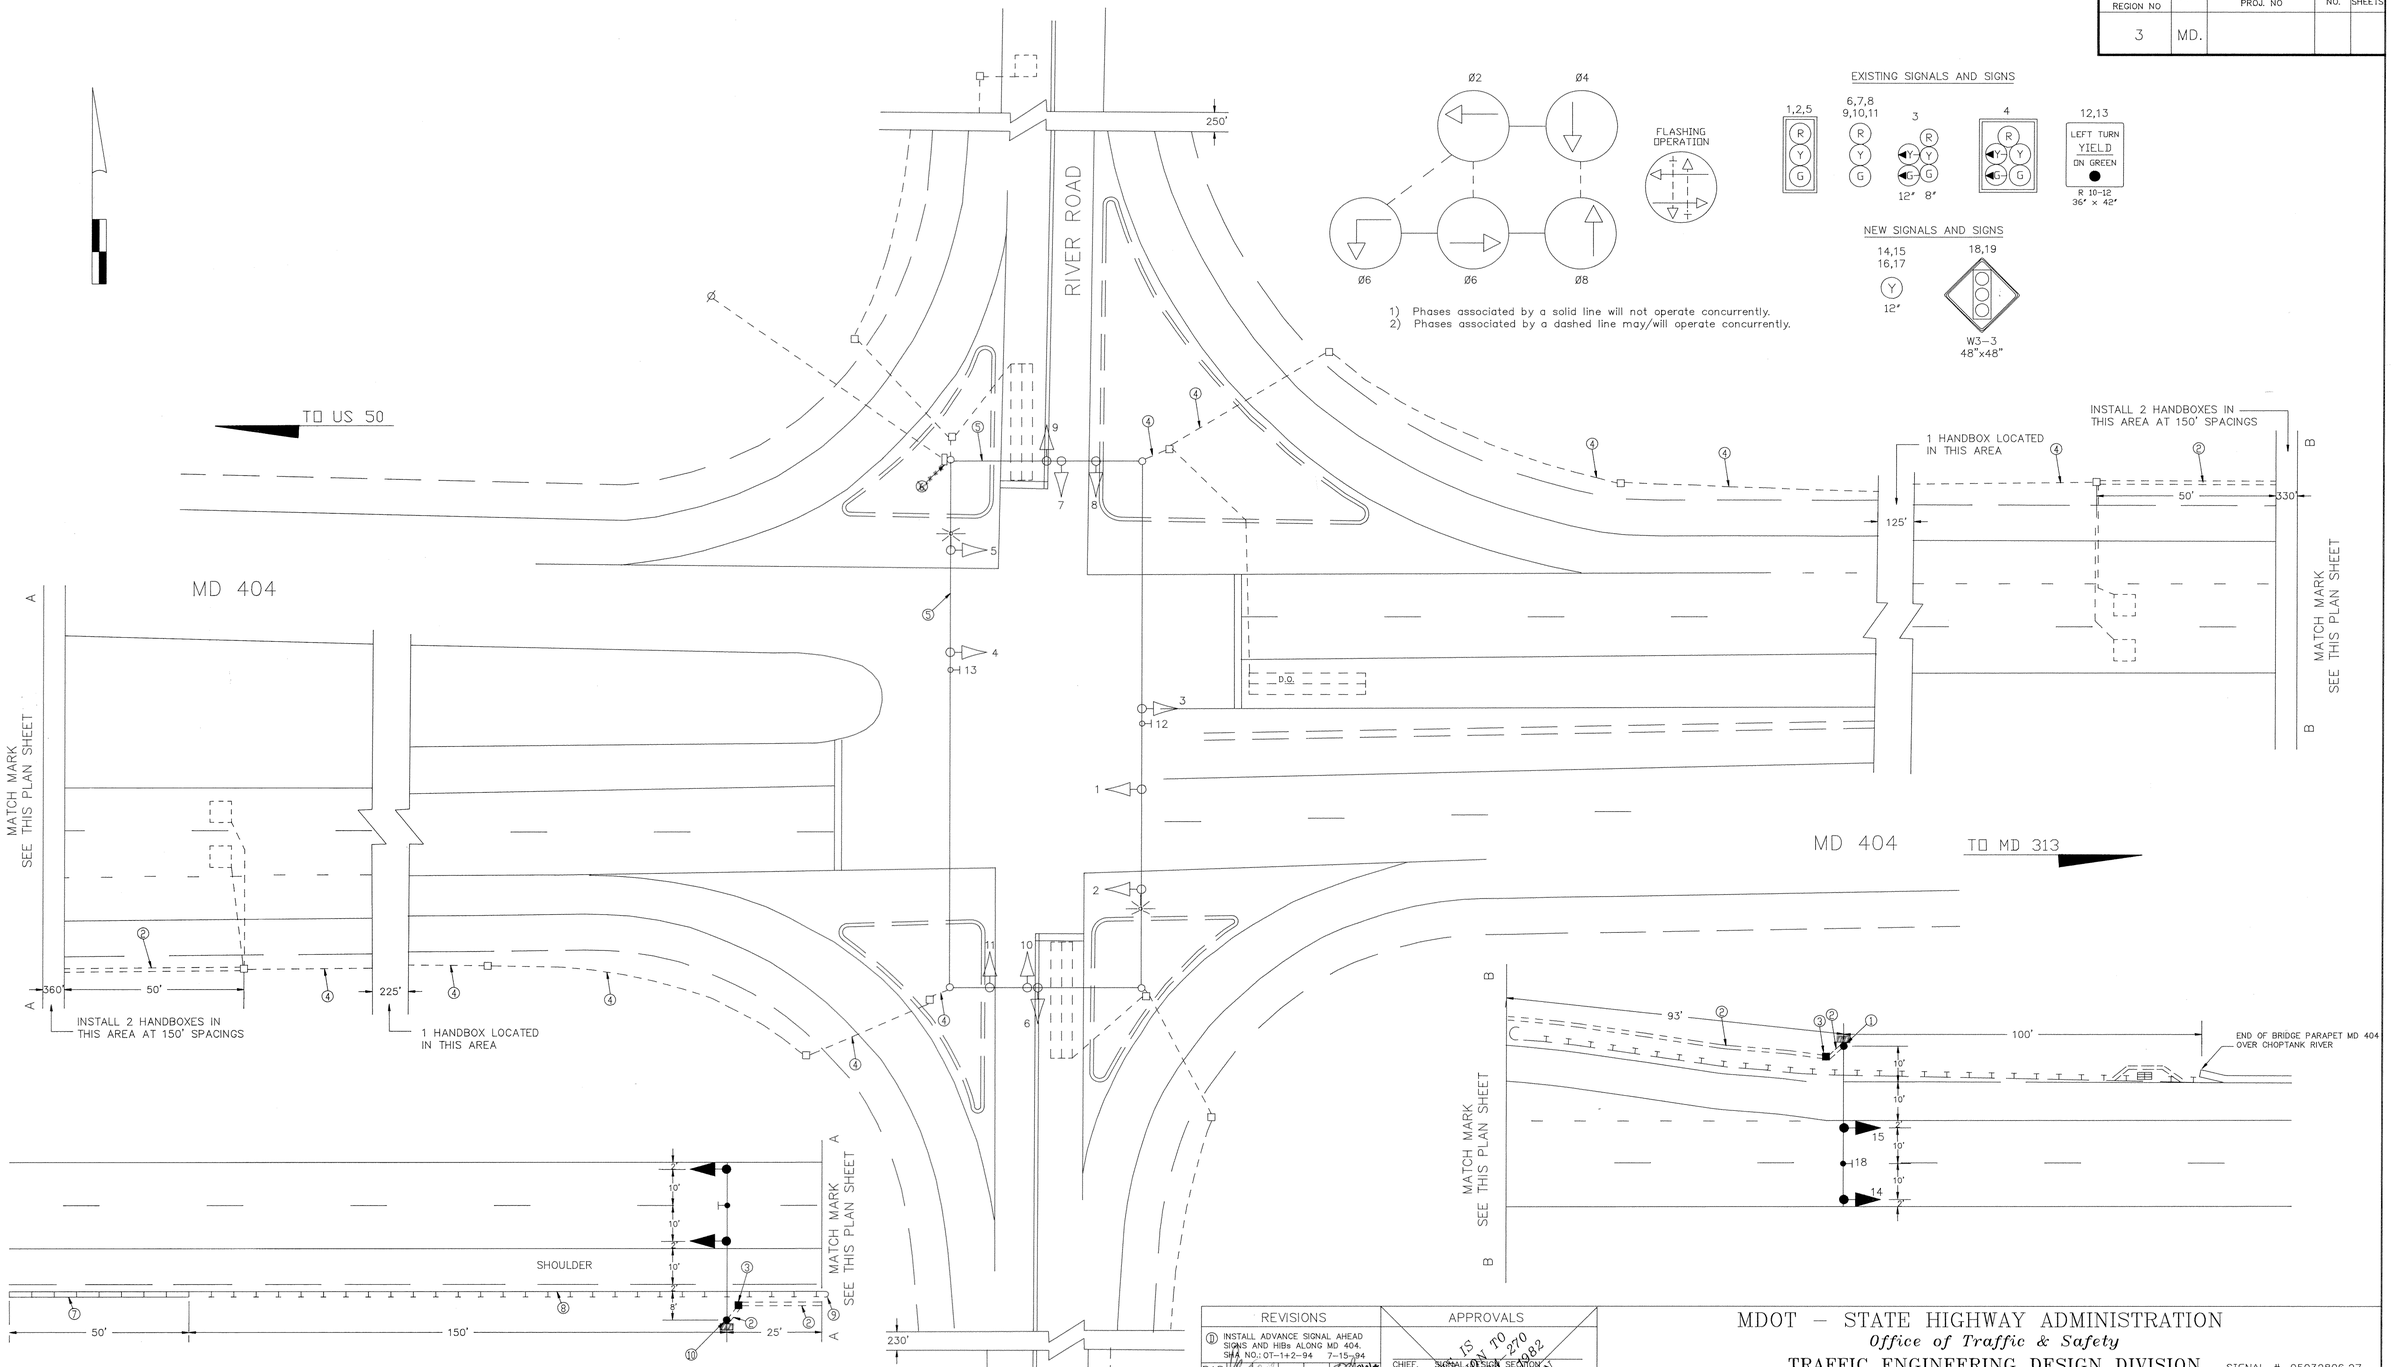

REVISIONS	APPROVALS
ⓘ INSTALL ADVANCE SIGNAL AHEAD SIGNS AND HIBs ALONG MD 404. SHA NO.: OT-1+2-94 7-15-94 RAP	CHIEF, SIGNAL DESIGN SECTION
1 REDLINE REV. NO. 1 ADD POLE MOUNTED AUX. CAB. 10-23-94 RAP	ASST. DISTRICT ENGINEER, TRAFFIC
	CHIEF, TRAFFIC ENGINEERING DESIGN DIVISION
	DIRECTOR, OFFICE OF TRAFFIC & SAFETY

THIS IS TO REVISION TO CO 321-504-270 DATED 2-10-92 ORIGINAL PLAN ON FILE

MDOT – STATE HIGHWAY ADMINISTRATION
Office of Traffic & Safety
TRAFFIC ENGINEERING DESIGN DIVISION SIGNAL # 05032806.27

DRAWN BY: R. PATEL
DES. BY:
CHK. BY:

MD 404 AND MD 328/RIVER ROAD

COUNTY: CAROLINE

DATE: JULY 12, 1994
SCALE: 1"=20'
F.A.P. NO.
S.H.A. NO. CO-321-504-270

TS/STD. NO. TS-1854D

SHEET NO. ___ OF ___

F# 19

05032806.27