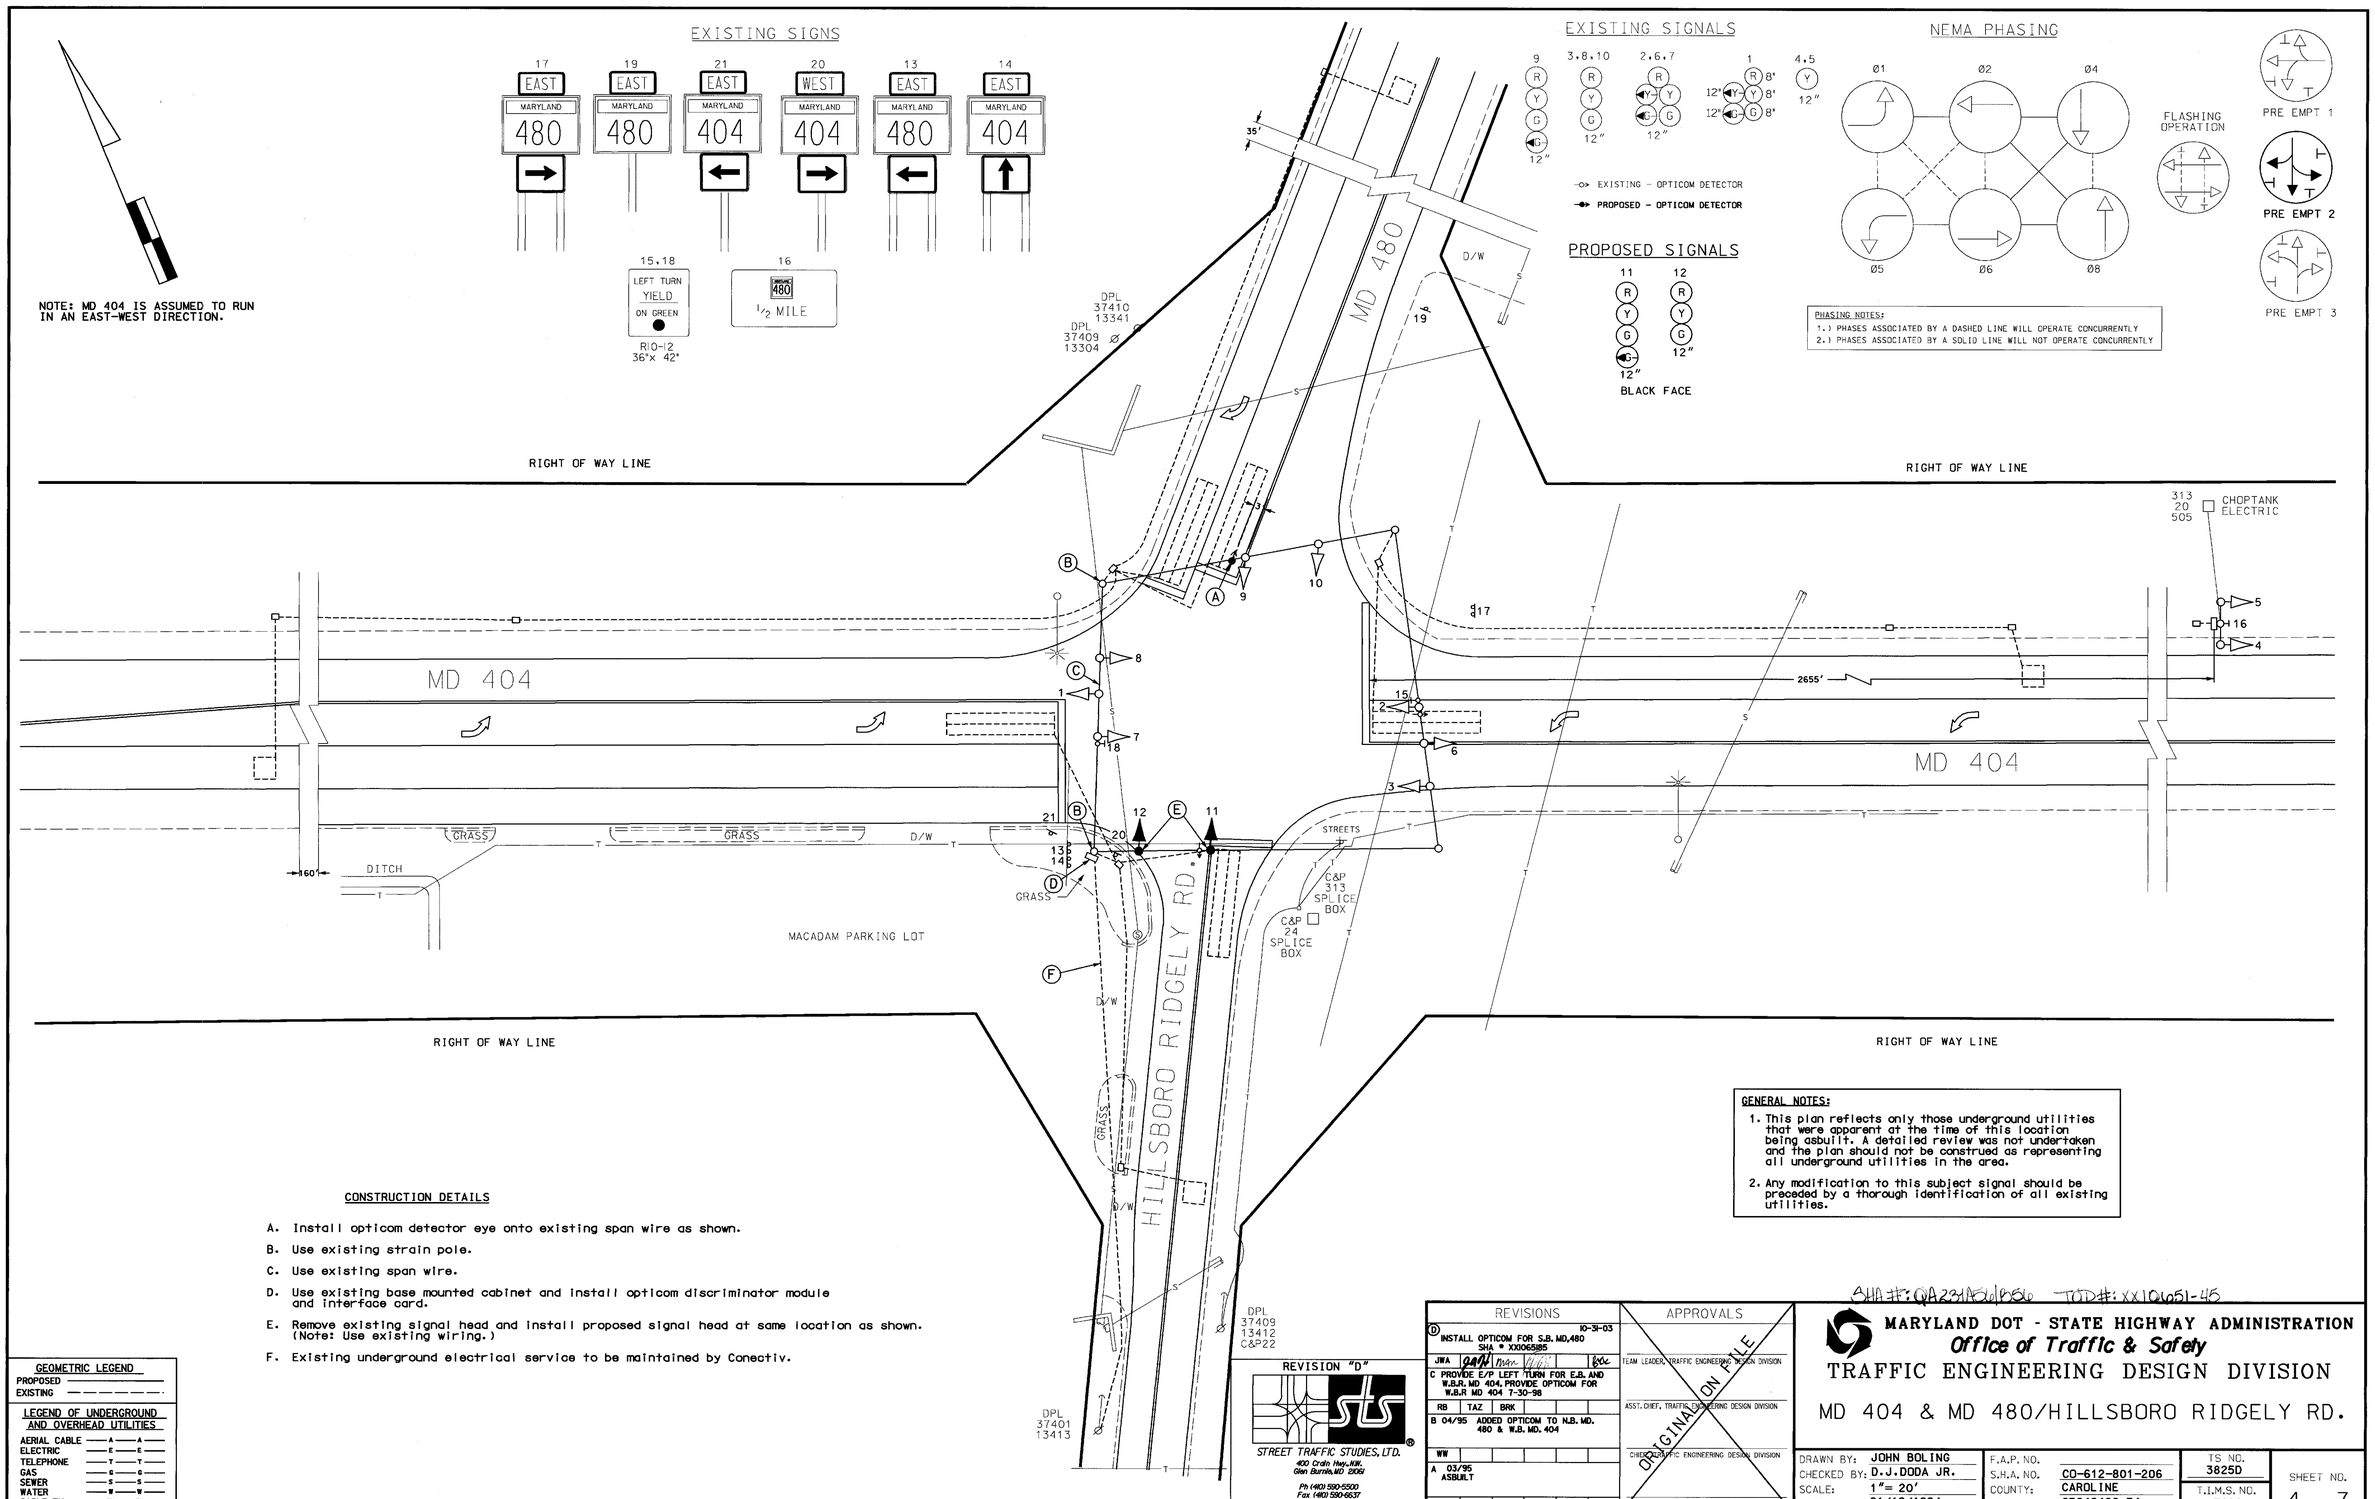

...\4421\4421d\4421d.dgn Oct. 31, 2003 15:33:26