F H W A REGION NO.	STATE	FED. AID PROJ. NO.	SHEET NO.	TOTAL SHEETS
3	MD		1	1

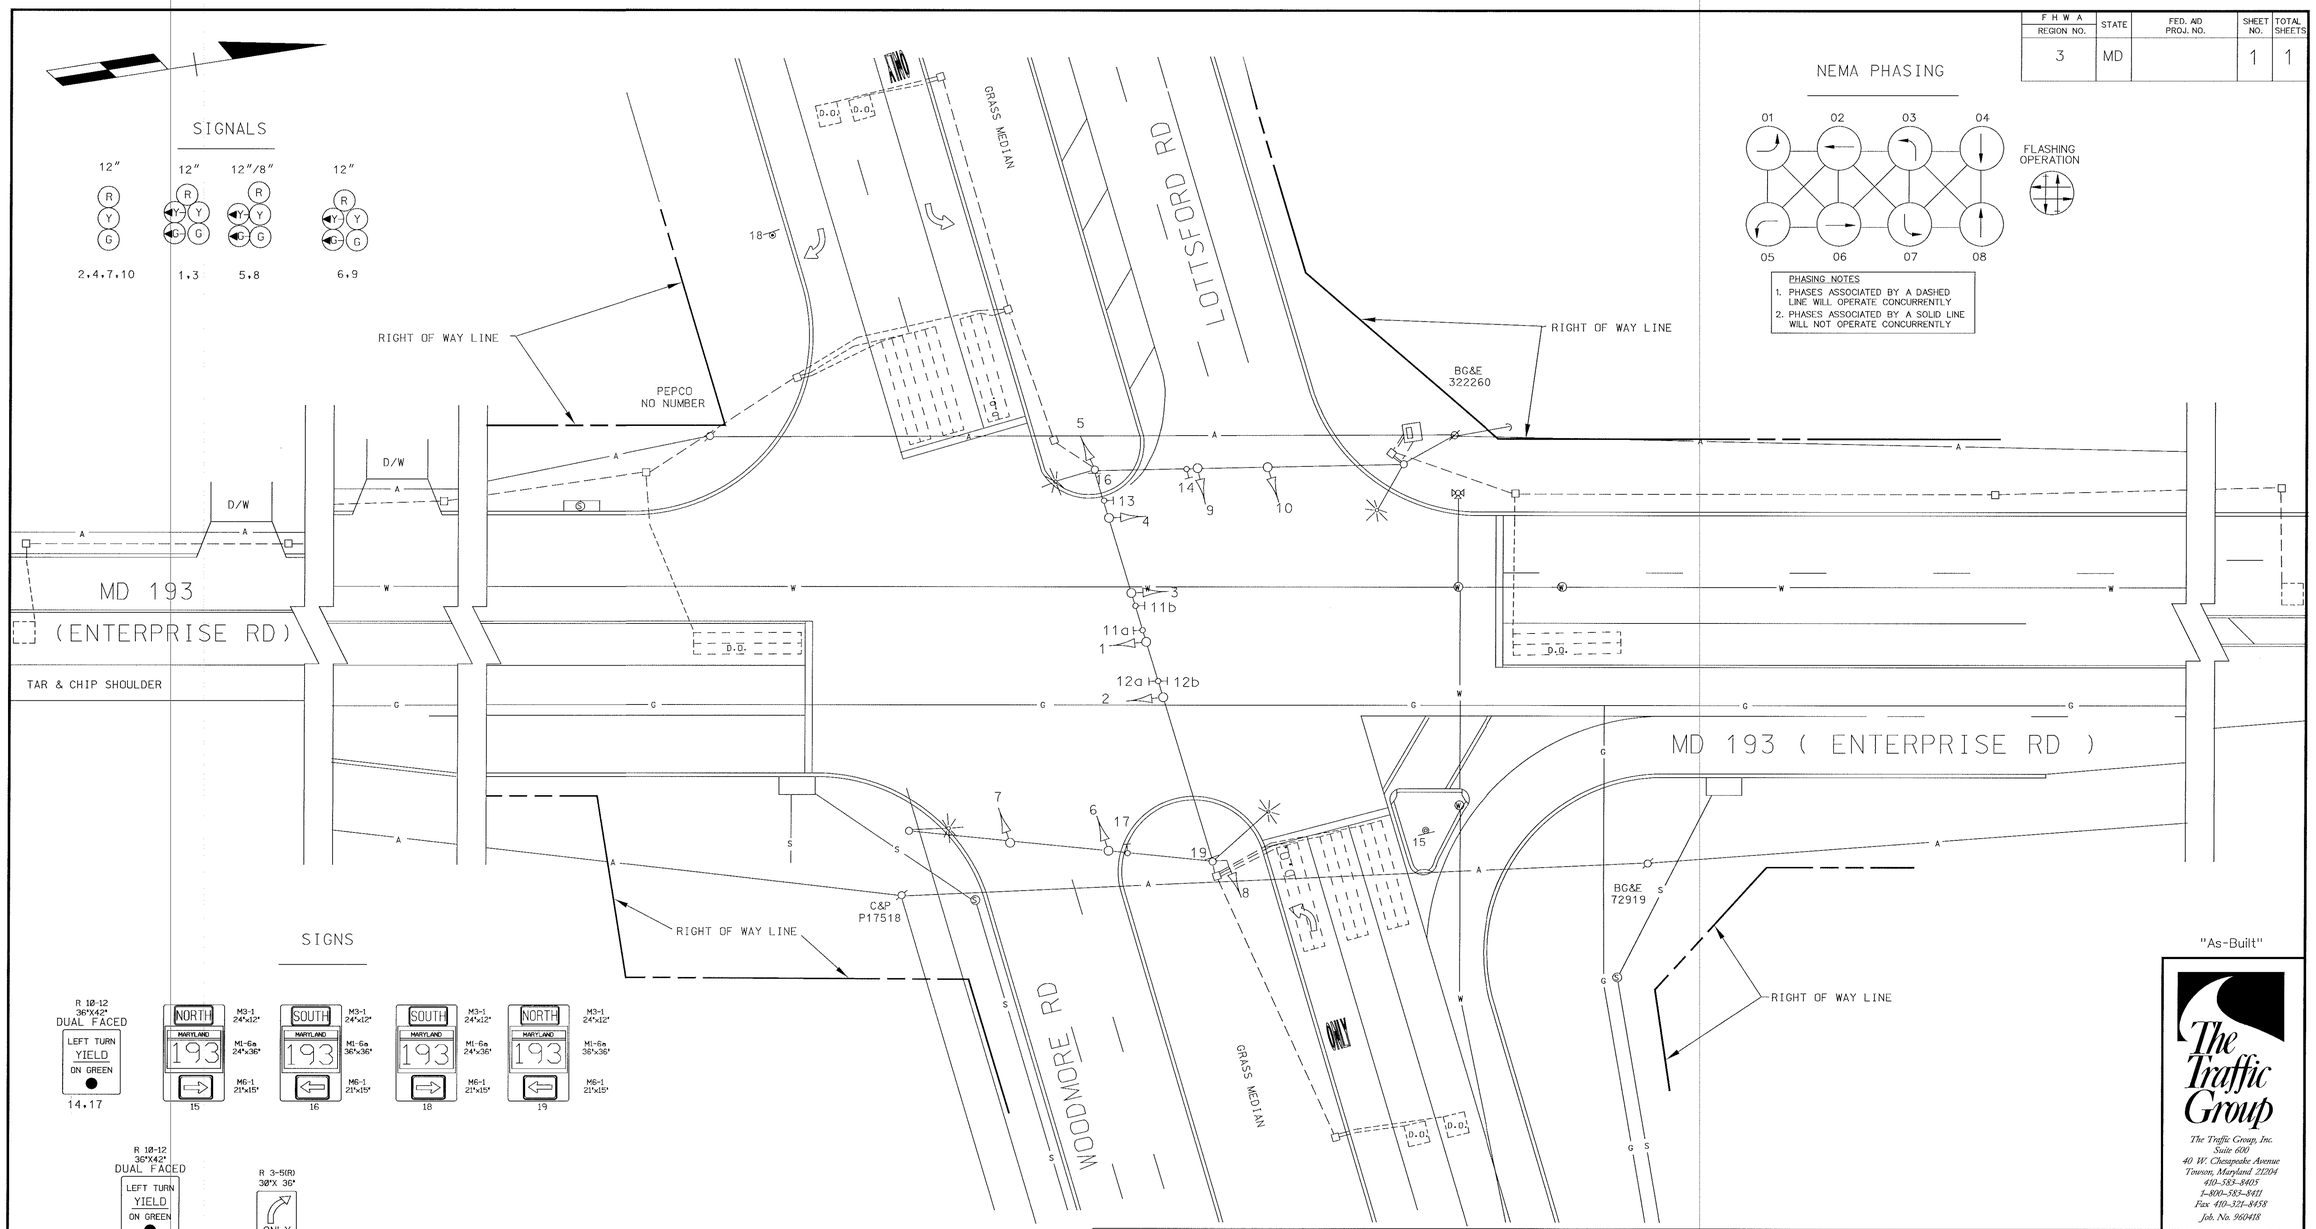

"As-Built"

The Traffic Group

The Traffic Group, Inc.
Suite 600
40 W. Chesapeake Avenue
Towson, Maryland 21204
410-583-8405
1-800-583-8411
Fax 410-321-8458
Job. No. 960418

LEGEND OF UNDERGROUND AND OVERHEAD UTILITIES

AERIAL CABLE	A	A	A
ELECTRIC	E	E	E
TELEPHONE	T	T	T
GAS	G	G	G
SEWER	S	S	S
WATER	W	W	W
CABLE TV	TV	TV	TV

DCL
CONSULTING ENGINEERS
COLUMBIA, MARYLAND

REVISIONS	APPROVALS
© As-Built May 7, 1996 S.H.A. NO. 855-250742	CHIEF, DESIGN SECTION
FJH	ASST. DISTRICT ENGINEER, TRAFFIC
Ⓑ ADD EB & WB E/P LEFT TURN PHASE.	CHIEF, TRAFFIC ENGINEERING DIVISION
DMP	DEPUTY CHIEF ENGINEER, TRAFFIC
Ⓐ 9-12-90 MODIFY SIGNAL FOR ULTIMATE GEOMETRICS	
R.R.Z.	

ORIGINAL ON FILE

MDOT - STATE HIGHWAY ADMINISTRATION
Office of Traffic
TRAFFIC ENGINEERING DIVISION

LOG # 16019316.58

DRAWN BY: W J NIES(FOR STS)
DES. BY: R R ZACHERL(FOR STS)
CHK. BY:

MD 193 AND LOTTSFORD RD/WOODMORE RD
COUNTY PRINCE GEORGE'S

DATE: 8-1-90
SCALE: 1"=20'
F.A.P. NO.
S.H.A. NO. BW-328-802-312
TS/STD. NO. 2672C-P
SHEET NO. 1 OF 1