FHWA REGION NO.	STATE	FED. AID PROJ. NO.	SHEET NO.	TOTAL SHEETS
3	MD			

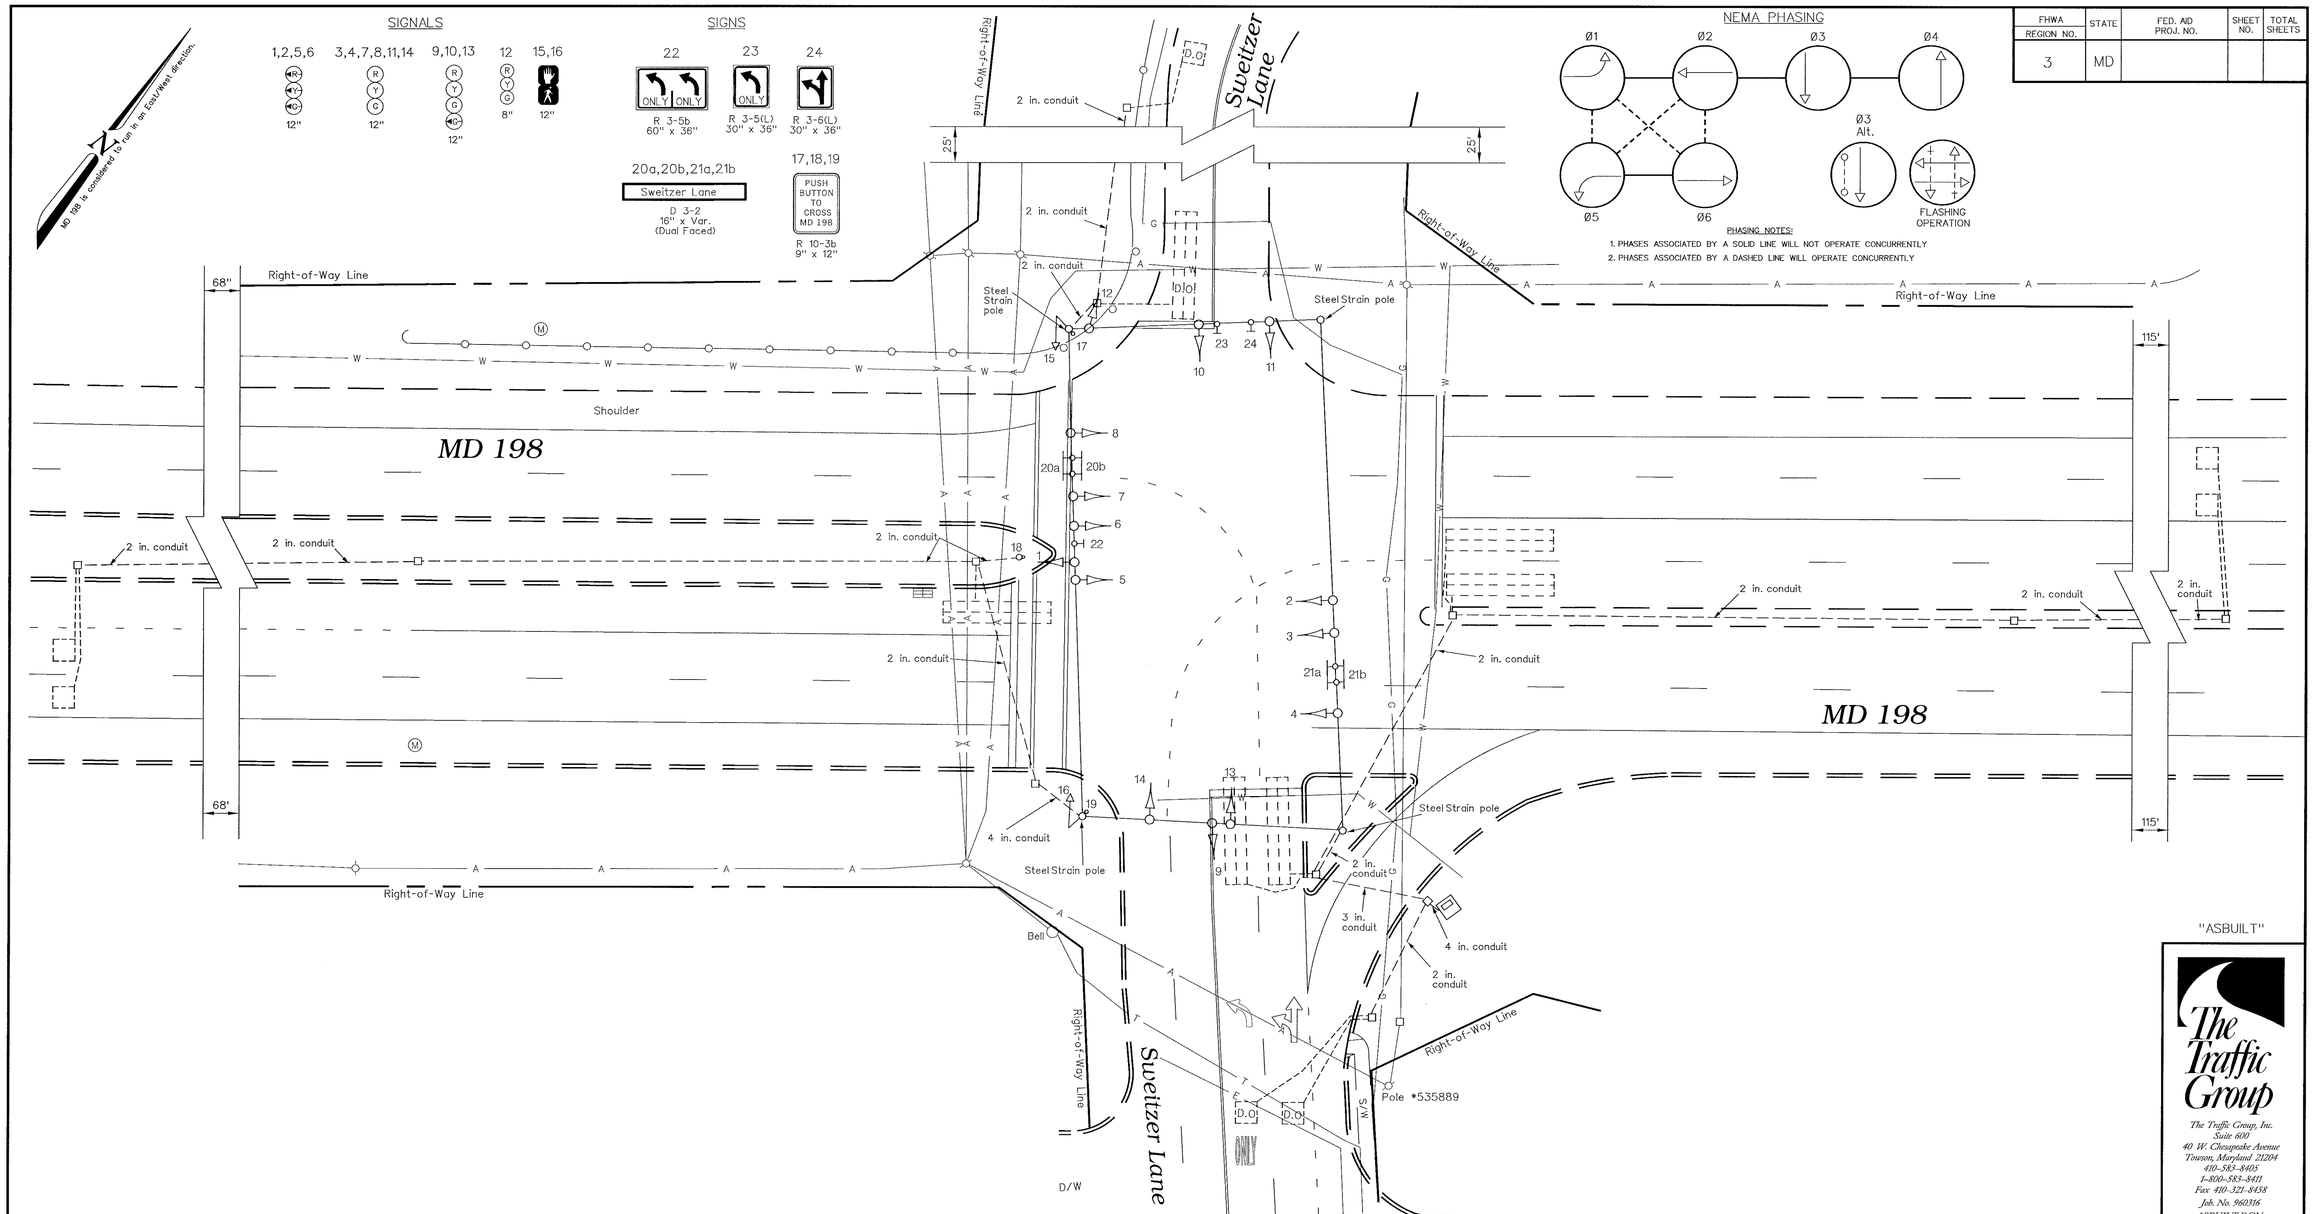

"ASBUILT"

The Traffic Group

The Traffic Group, Inc.
Suite 600
40 W. Chesapeake Avenue
Towson, Maryland 21204
410-583-8605
1-800-583-8411
Fax 410-321-8458
Job. No. 960316
ASBUILT.DGN

GEOMETRIC LEGEND

EXISTING GEOMETRICS
PROPOSED GEOMETRICS

UTILITY LEGEND

G	GAS MAIN
W	WATER MAIN
S	SEWER MAIN
E	ELECTRIC CABLES
D	STORM DRAIN
A	AERIAL CABLES
T	TELEPHONE CABLES

REVISIONS

(B) November 4, 1997
ASBUILT
S.H.A. No.: BW-85516001
FJH

APPROVALS

ASST. DIVISION CHIEF TRAFFIC ENGINEERING DESIGN DIVISION
CHIEF, TRAFFIC ENGINEERING DESIGN DIVISION
ASST. DISTRICT ENGINEER - TRAFFIC
DIRECTOR, OFFICE OF TRAFFIC & SAFETY

ORIGINAL ON FILE

MDOT – STATE HIGHWAY ADMINISTRATION
Office of Traffic & Safety
TRAFFIC ENGINEERING DESIGN DIVISION

DRAWN BY: M. Binder
DES. BY: Dave Andrews
CHK. BY: Steve Renzi

(Traffic Signal Plan)

MD 198 at Sweitzer Lane

COUNTY: PRINCE GEORGE'S
LOG MILE *

DATE: August 22, 1985
SCALE: 1" = 20'
F.A.P. NO. N/A
S.H.A. NO. 855-16001
TS/STD. NO. 2110B
SHEET NO. 1 of 1