F H WA REGION NO	STATE	FED. AID PROJ. NO	SHEET NO.	TOTAL SHEETS
3	MD.	CMG-5019(6)E	19	26

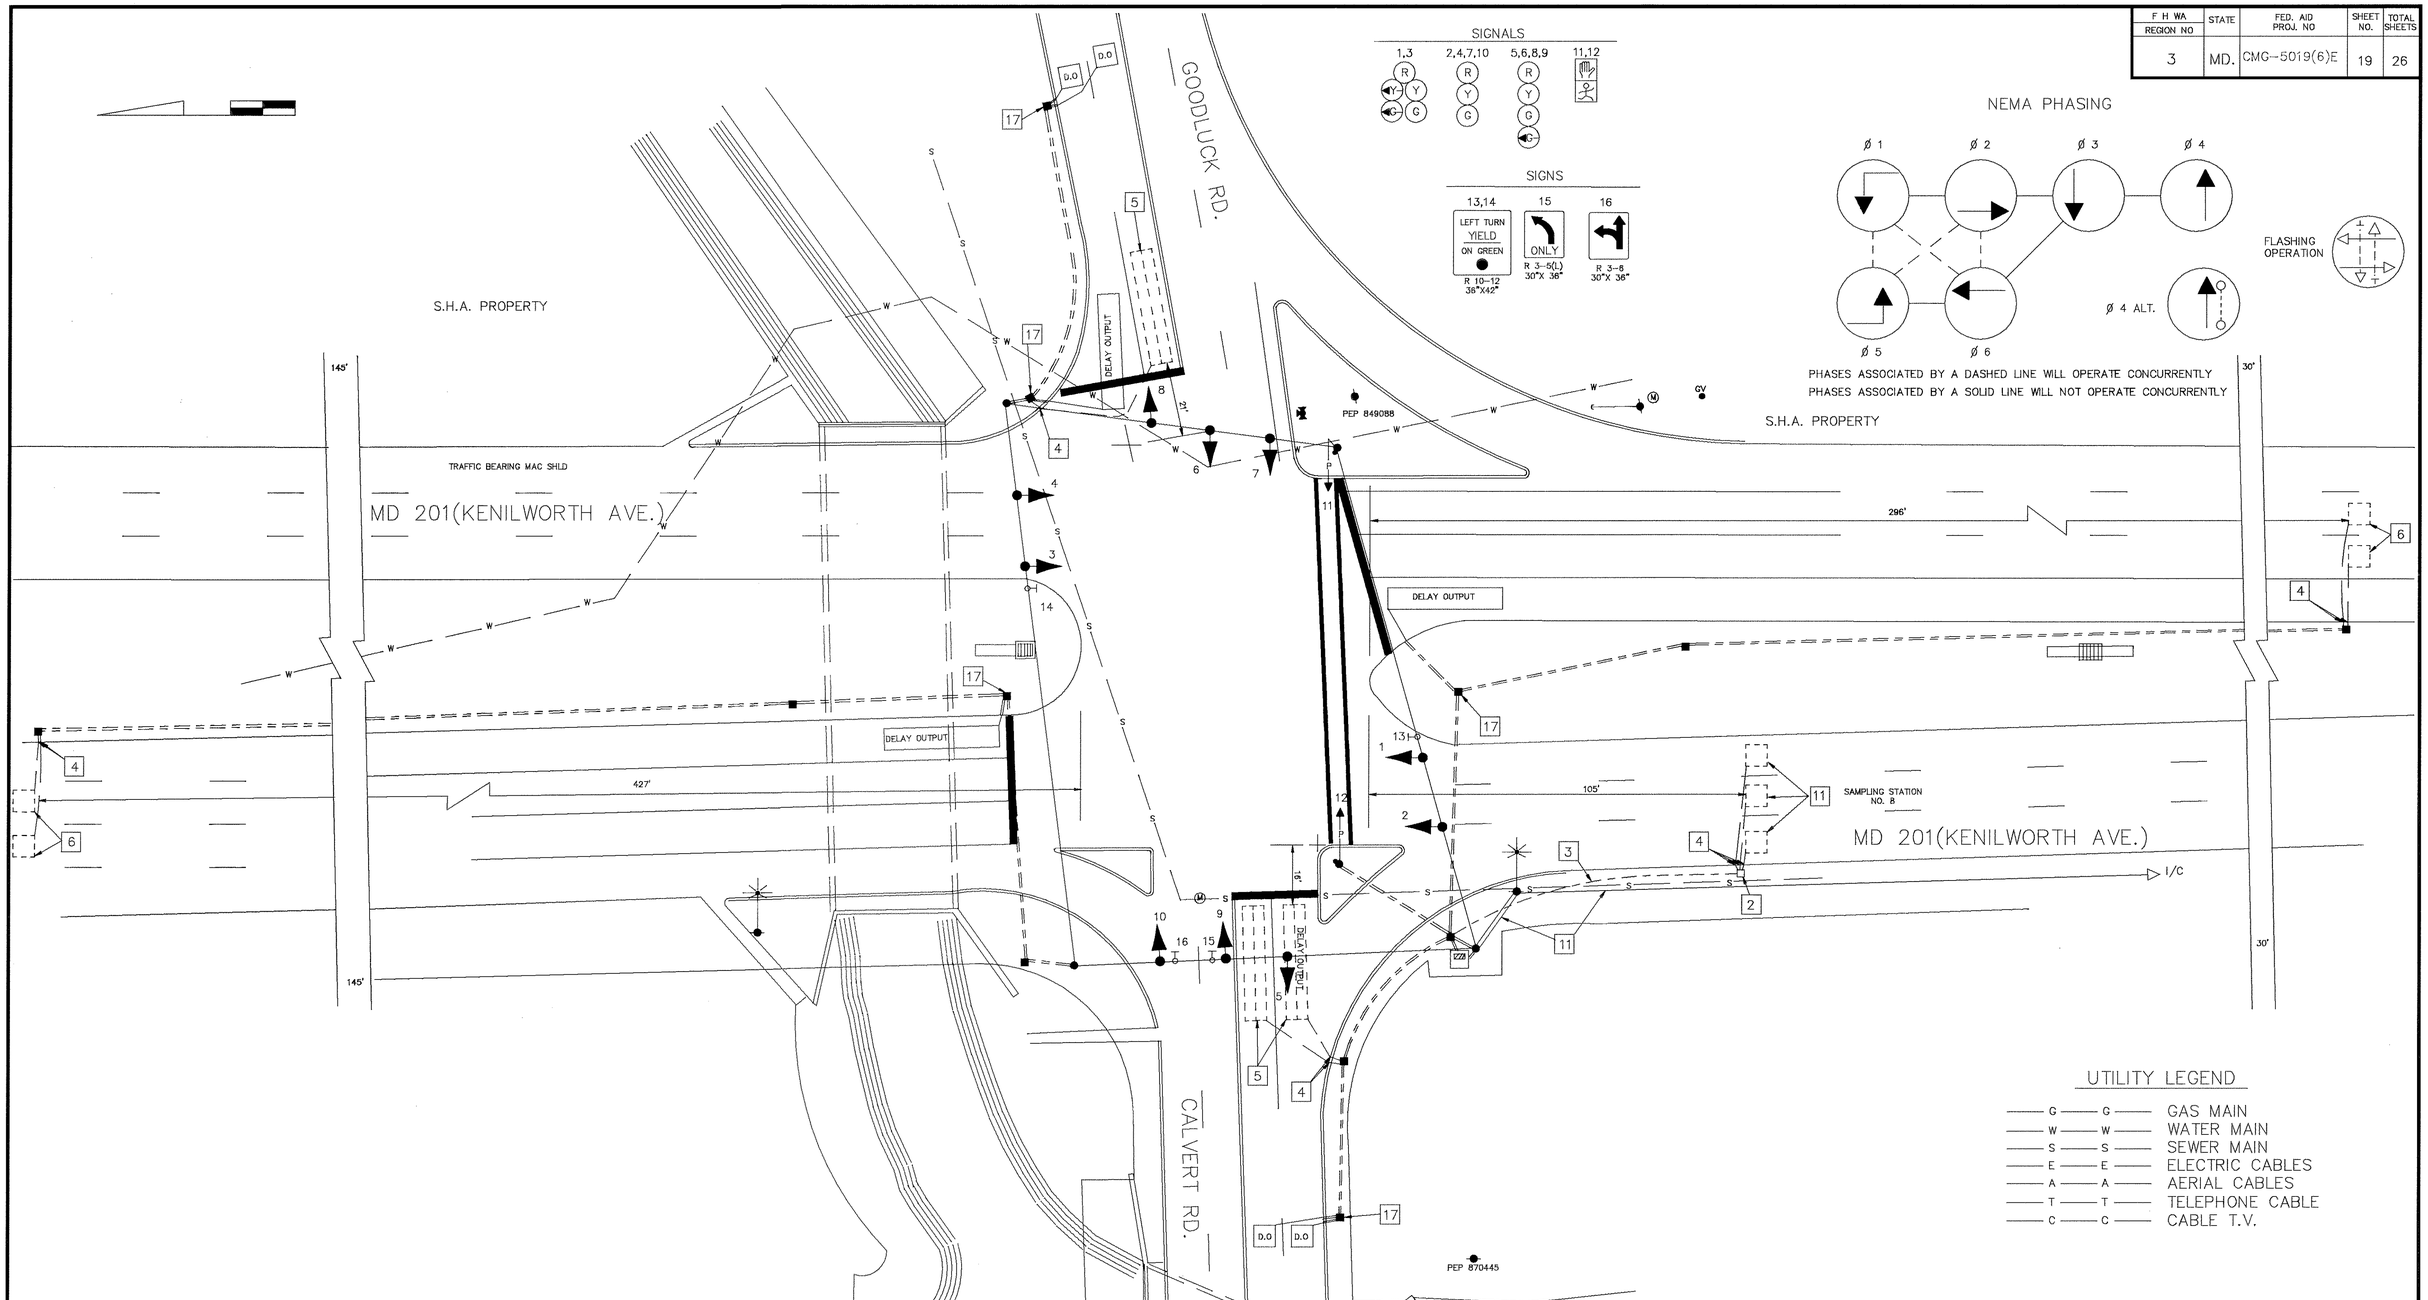

REVISIONS	APPROVALS
B ASBUILT 7/93 REPLACE DAMAGED LOOP DETECTORS AND INSTALL TELEMETRY SYSTEM. P-125-501-385 CMG-5019(6)E	CHIEF, SIGNAL DESIGN SECTION
	ASST. DISTRICT ENGINEER, TRAFFIC
	CHIEF, TRAFFIC ENGINEERING DESIGN DIVISION
	DIRECTOR, OFFICE OF TRAFFIC AND SAFETY

THE ORIGINAL IS ON FILE

MARYLAND DEPARTMENT OF TRANSPORTATION
STATE HIGHWAY ADMINISTRATION – OFFICE OF TRAFFIC AND SAFETY
TRAFFIC ENGINEERING DESIGN DIVISION

DRAWN BY BRUCE THOMPSON BP
DES. BY: STEVE RENZI
CHK. BY:

MD 201 and CALVERT/GOODLUCK RDS.

16020104.81

COUNTY: PRINCE GEORGE'S

DATE: REDRAWN 2-23-93
SCALE: 1"=20'
F.A.P. NO. MG-5019(1)
S.H.A. NO. P-386-001-385
TS/FILE NO. 682 B
SHEET NO. 19 OF 26

16020104.81 F# 4