REG.	STATE	PROJECT	SHEET NO	TOTAL SHEETS
NC	MD.	BW IA24, B15	131	468

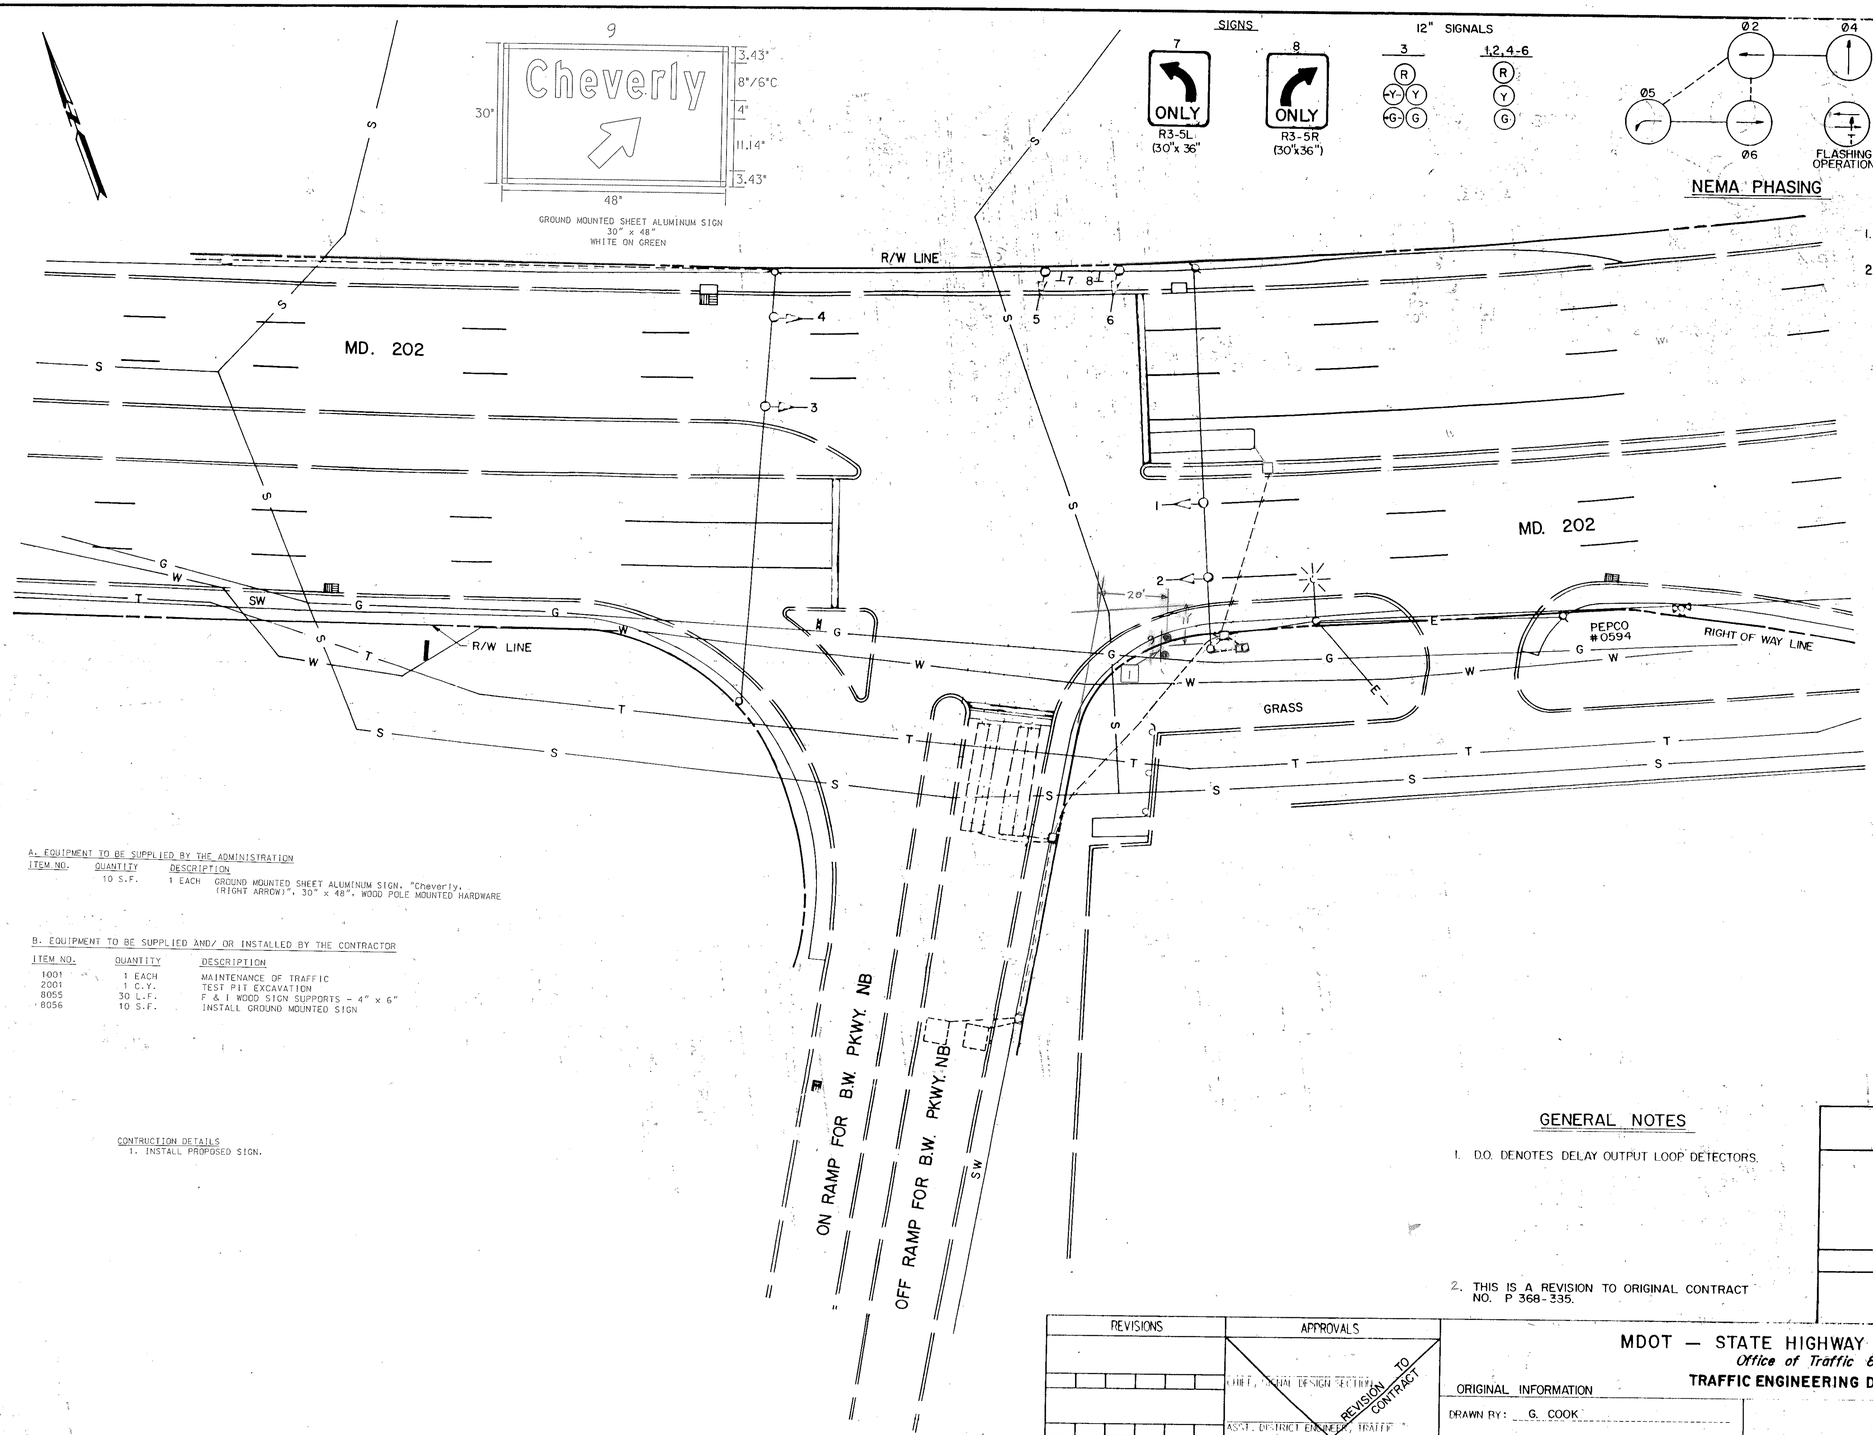

NEMA PHASING NOTES

1. PHASES ASSOCIATED WITH A DASHED LINE WILL OPERATE CONCURRENTLY.
2. PHASES ASSOCIATED WITH A SOLID LINE WILL NOT OPERATE CONCURRENTLY.

A. EQUIPMENT TO BE SUPPLIED BY THE ADMINISTRATION

ITEM NO.	QUANTITY	DESCRIPTION
	10 S.F.	1 EACH GROUND MOUNTED SHEET ALUMINUM SIGN. "Cheverly, (RIGHT ARROW)", 30" x 48". WOOD POLE MOUNTED HARDWARE

B. EQUIPMENT TO BE SUPPLIED AND/ OR INSTALLED BY THE CONTRACTOR

ITEM NO.	QUANTITY	DESCRIPTION
1001	1 EACH	MAINTENANCE OF TRAFFIC
2001	1 C.Y.	TEST PIT EXCAVATION
8055	30 L.F.	F.A.I WOOD SIGN SUPPORTS - 4" x 6"
8056	10 S.F.	INSTALL GROUND MOUNTED SIGN

CONTRUCTION DETAILS
1. INSTALL PROPOSED SIGN.

GENERAL NOTES

1. D.O. DENOTES DELAY OUTPUT LOOP DETECTORS.
2. THIS IS A REVISION TO ORIGINAL CONTRACT NO. P 368-335.

LEGND OF UNDERGROUND AND OVERHEAD UTILITIES

AERIAL CABLE	A	A	A
ELECTRIC	E	E	E
TELEPHONE	T	T	T
GAS	G	G	G
SEWER	S	S	S
WATER	W	W	W
CABLE TV	TV	TV	TV

REVISIONS

B. 03-97 - INSTALL SIGN E.B. MD. 202

A. 11/8/92 BW IA 24, B15
REPLACEMENT OF LOOP DETECTORS DUE TO GEOMETRIC CONSTRUCTION

APPROVALS

CHIEF, ROAD DESIGN SECTION

ASST. DISTRICT ENGINEER, TRAFFIC

CHIEF, BUREAU OF TRAFFIC ENGINEERING

DIRECTOR, OFFICE OF TRAFFIC

THIS IS A REVISION TO ORIGINAL CONTRACT

MDOT — STATE HIGHWAY ADMINISTRATION
Office of Traffic & Safety
TRAFFIC ENGINEERING DESIGN DIVISION

ORIGINAL INFORMATION
DRAWN BY: G. COOK
DES. BY:
CHK. BY:
DATE: 11/1/72
SCALE: 1"= 20'
F.A.P. NO.
S.H.A. NO.

MD. 202 & N.B.
RAMP FOR B.W. PKWY.

COUNTY: PRINCE GEORGE'S

TS/FILE NO. TS 787 A

SHEET NO. 131 OF 468