F H WA REGION NO	STATE	FED. AID PROJ. NO	SHEET NO.	TOTAL SHEETS
3	MD.			

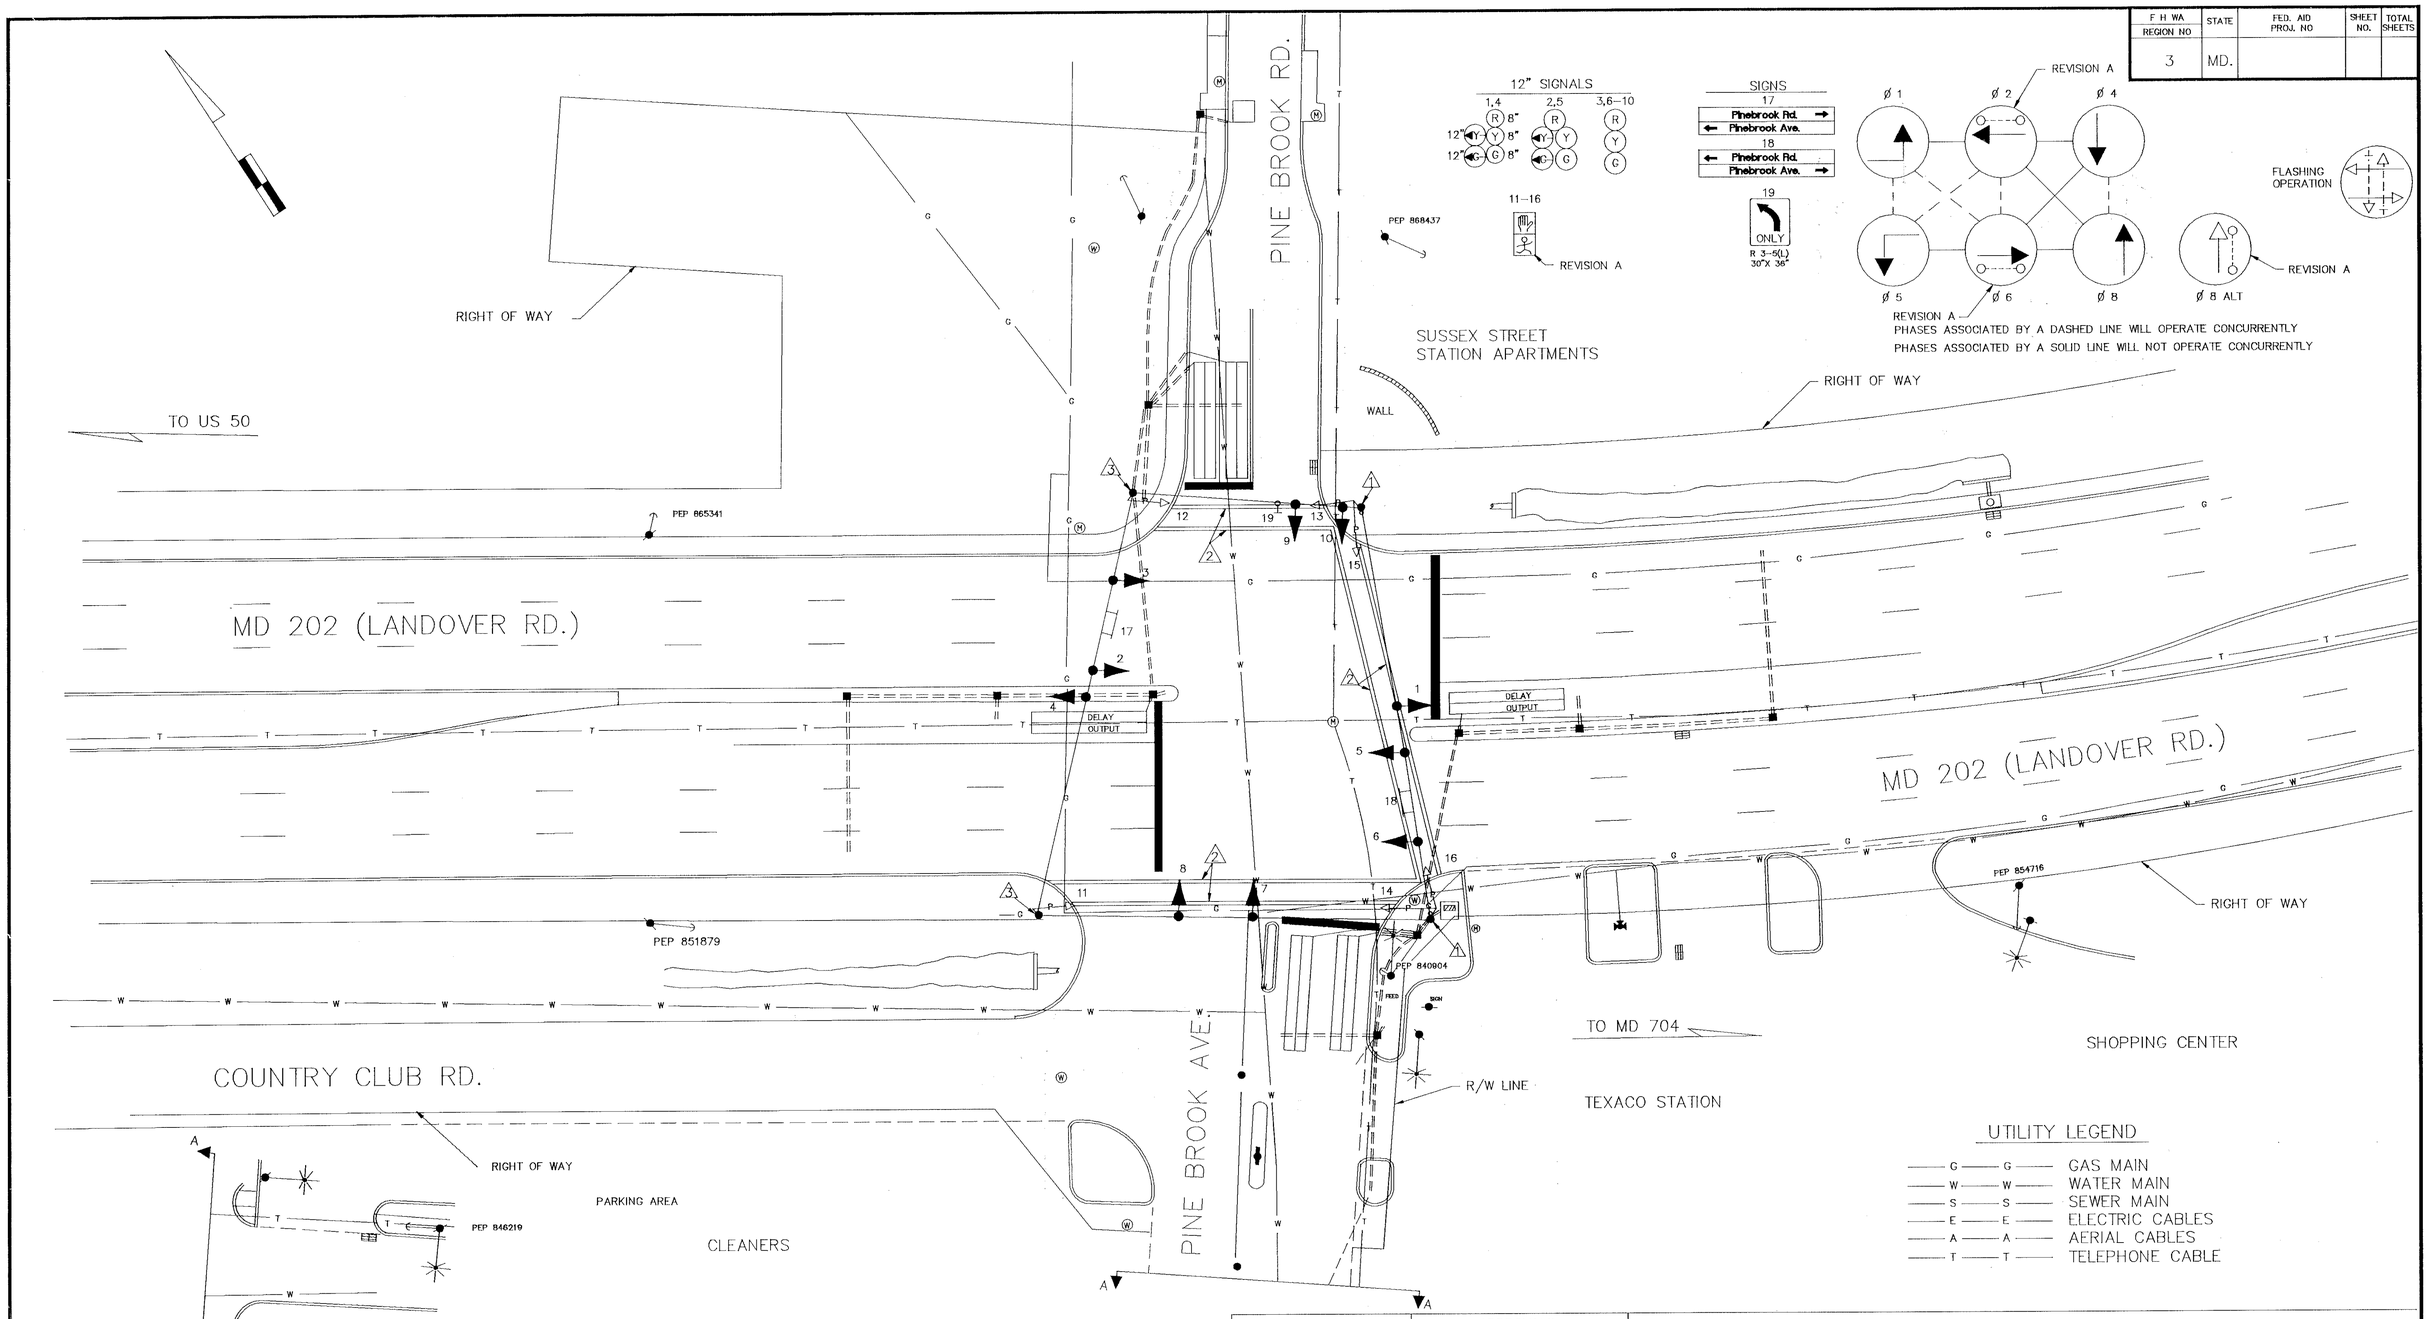

REVISIONS	APPROVALS
10/91 INSTALL CROSSWALKS AND PED. PUSHBUTTONS, SIGNALS AND SIGNS.	CHIEF, SIGNAL DESIGN SECTION ASST. DISTRICT ENGINEER, TRAFFIC CHIEF, TRAFFIC ENGINEERING DIVISION DEPUTY CHIEF ENGINEER, OFFICE OF TRAFFIC

THIS IS A REVISION TO S.H.A. CONTRACT NO. P-346-1-385 THE ORIGINAL IS ON FILE

MARYLAND DEPARTMENT OF TRANSPORTATION
STATE HIGHWAY ADMINISTRATION – OFFICE OF TRAFFIC
TRAFFIC ENGINEERING DIVISION

DRAWN BY BRUCE THOMPSON
DES. BY:
CHK. BY:
DATE: REDRAWN 7-29-91
SCALE: 1"=20'

MD 202 and PINEBROOK AVE.

160202XX.XX

COUNTY: PRINCE GEORGES

F.A.P. NO. T-8006(26)
S.H.A. NO. P-346-1-385

TS/FILE NO. 662 A

SHEET NO. 7 OF 14

I-#47