K&E BALTIMORE 17-0153 PHOENIX 10-75 MC 4156+

F.H.W.A. REGION NO.	STATE	FED. AID PROJ. NO.	SHEET NO.	TOTAL SHEETS
3	MD.	U-158-1(1)	12	15

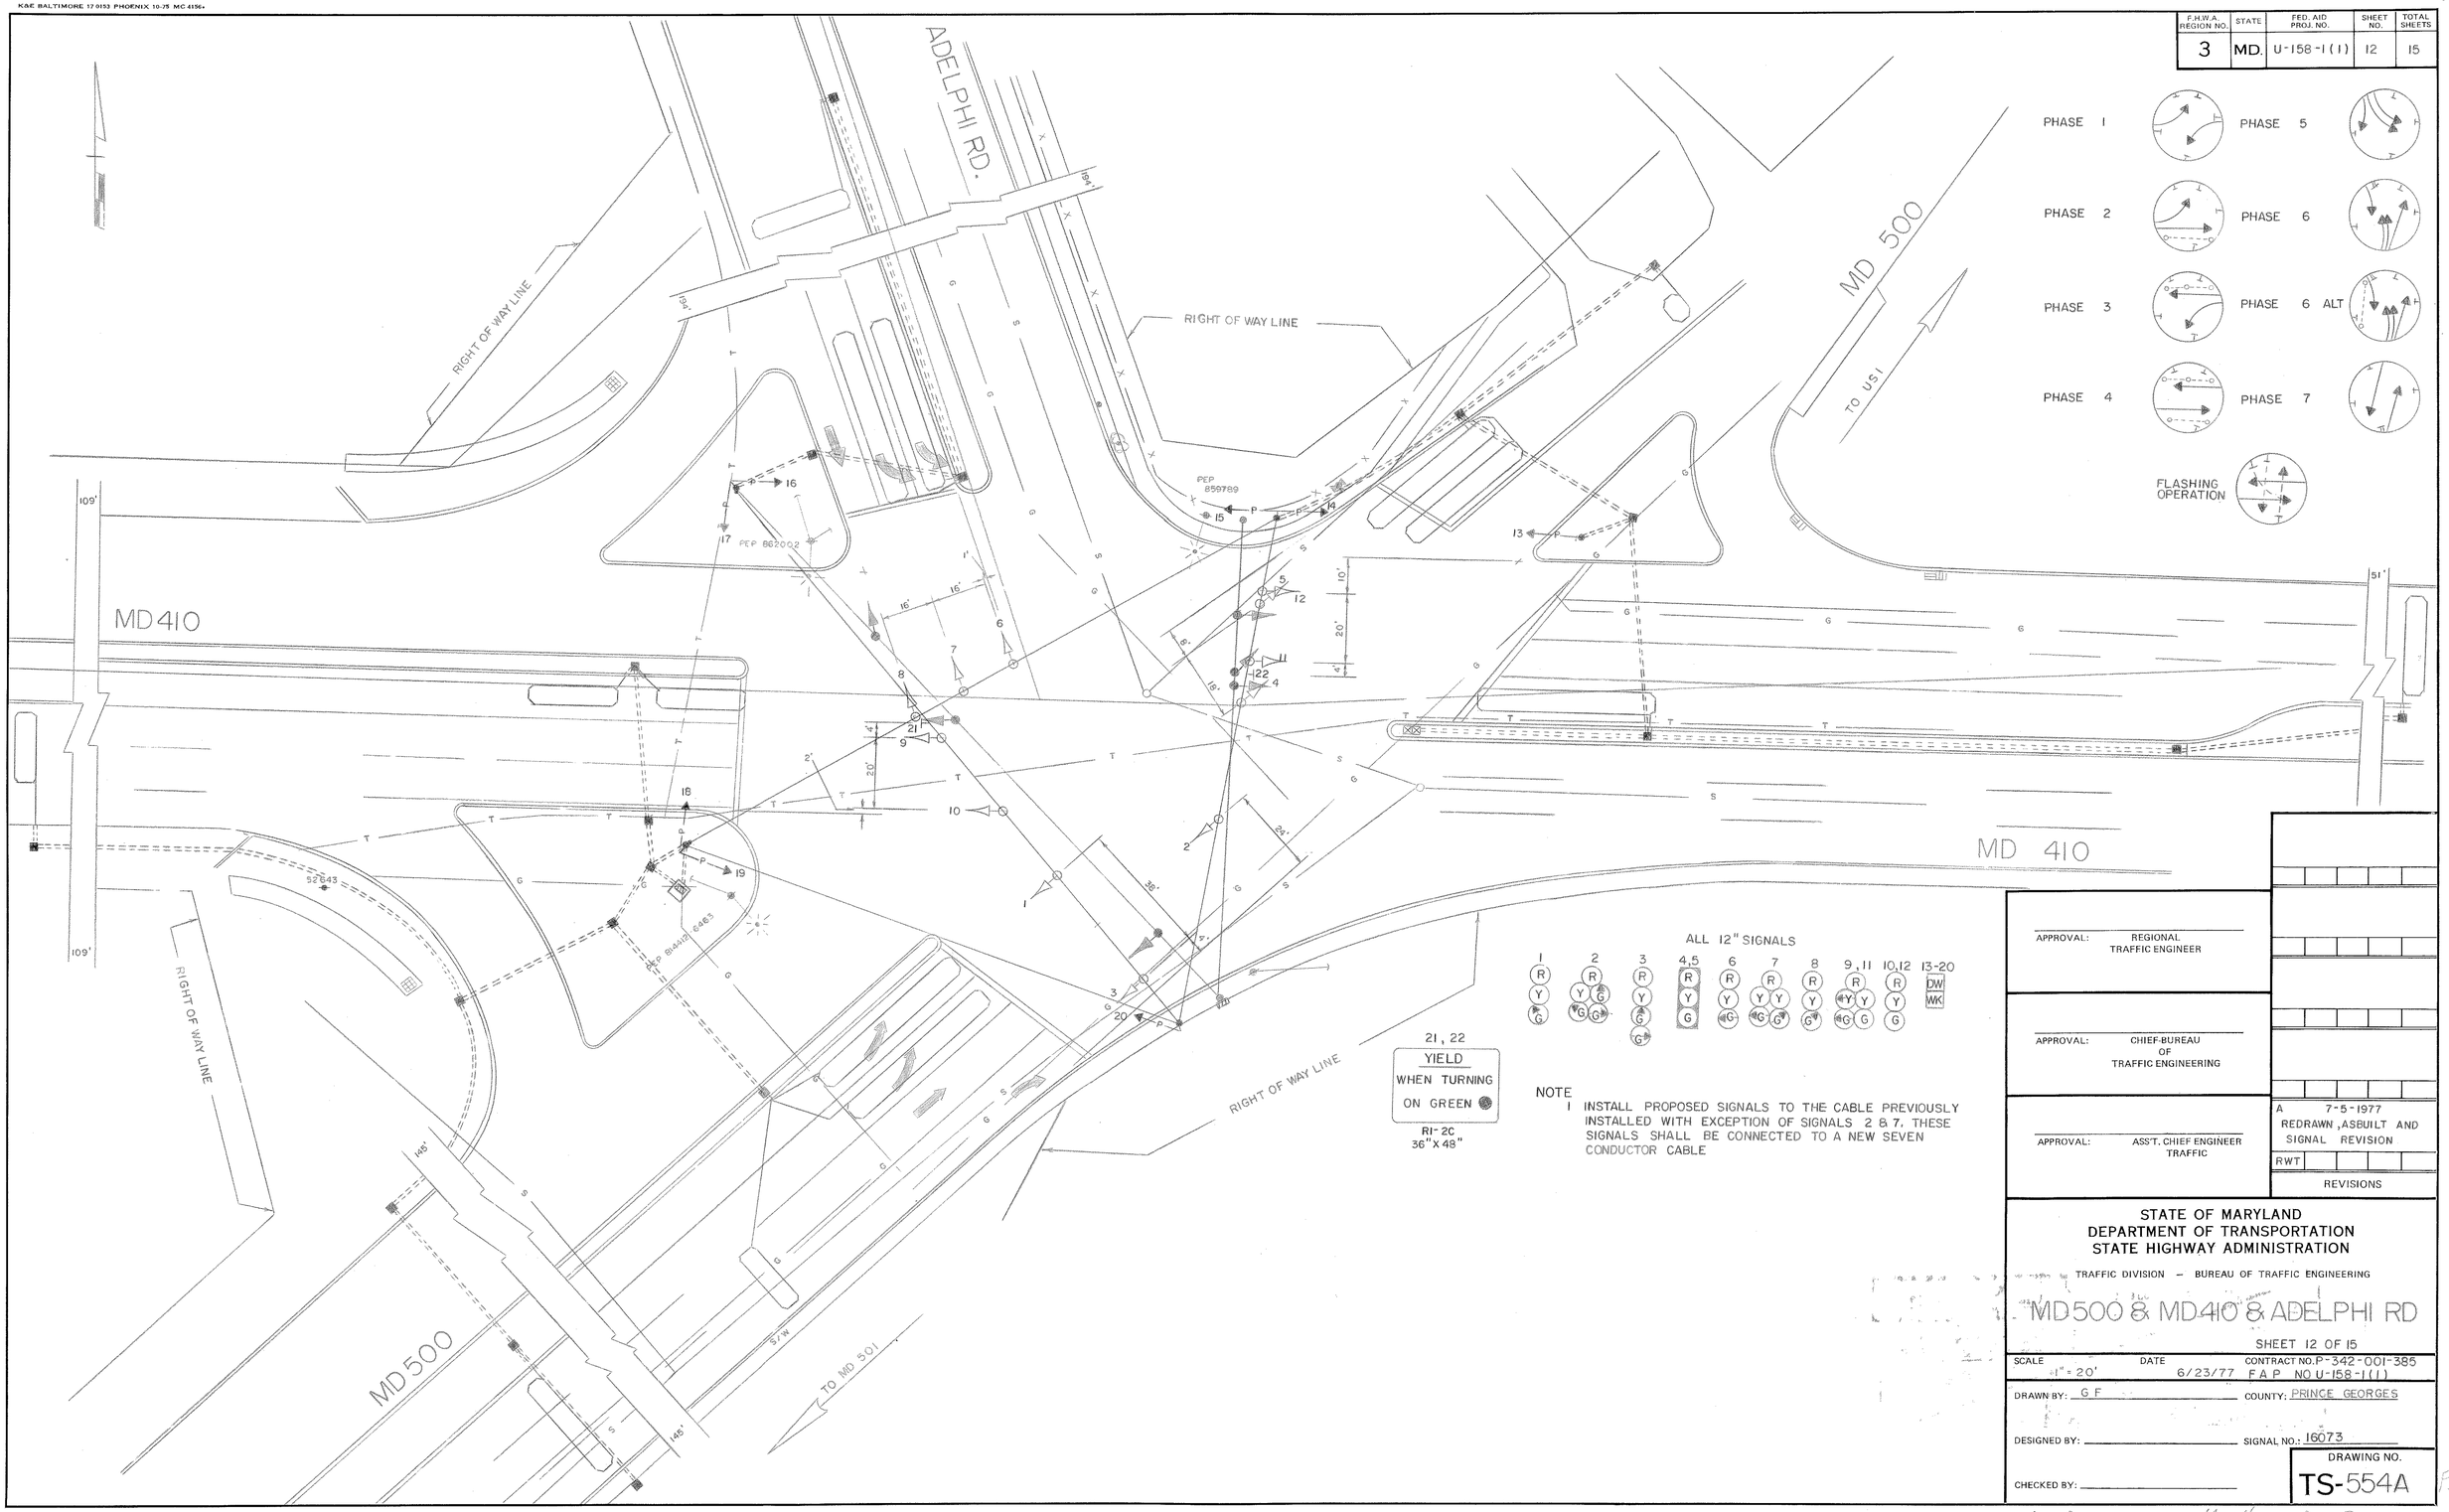

NOTE

1 INSTALL PROPOSED SIGNALS TO THE CABLE PREVIOUSLY INSTALLED WITH EXCEPTION OF SIGNALS 2 & 7. THESE SIGNALS SHALL BE CONNECTED TO A NEW SEVEN CONDUCTOR CABLE

APPROVAL: REGIONAL TRAFFIC ENGINEER

APPROVAL: CHIEF-BUREAU OF TRAFFIC ENGINEERING

APPROVAL: ASS'T. CHIEF ENGINEER TRAFFIC

A	7-5-1977	REDRAWN, ASBUILT AND SIGNAL REVISION	
RWT			

REVISIONS

STATE OF MARYLAND
DEPARTMENT OF TRANSPORTATION
STATE HIGHWAY ADMINISTRATION

TRAFFIC DIVISION – BUREAU OF TRAFFIC ENGINEERING

MD 500 & MD 410 & ADELPHI RD

SHEET 12 OF 15

SCALE 1" = 20' DATE 6/23/77 CONTRACT NO. P-342-001-385 F.A.P. NO. U-158-1(1)

DRAWN BY: G F COUNTY: PRINCE GEORGES

DESIGNED BY: SIGNAL NO.: 16073

CHECKED BY:

DRAWING NO. TS-554A