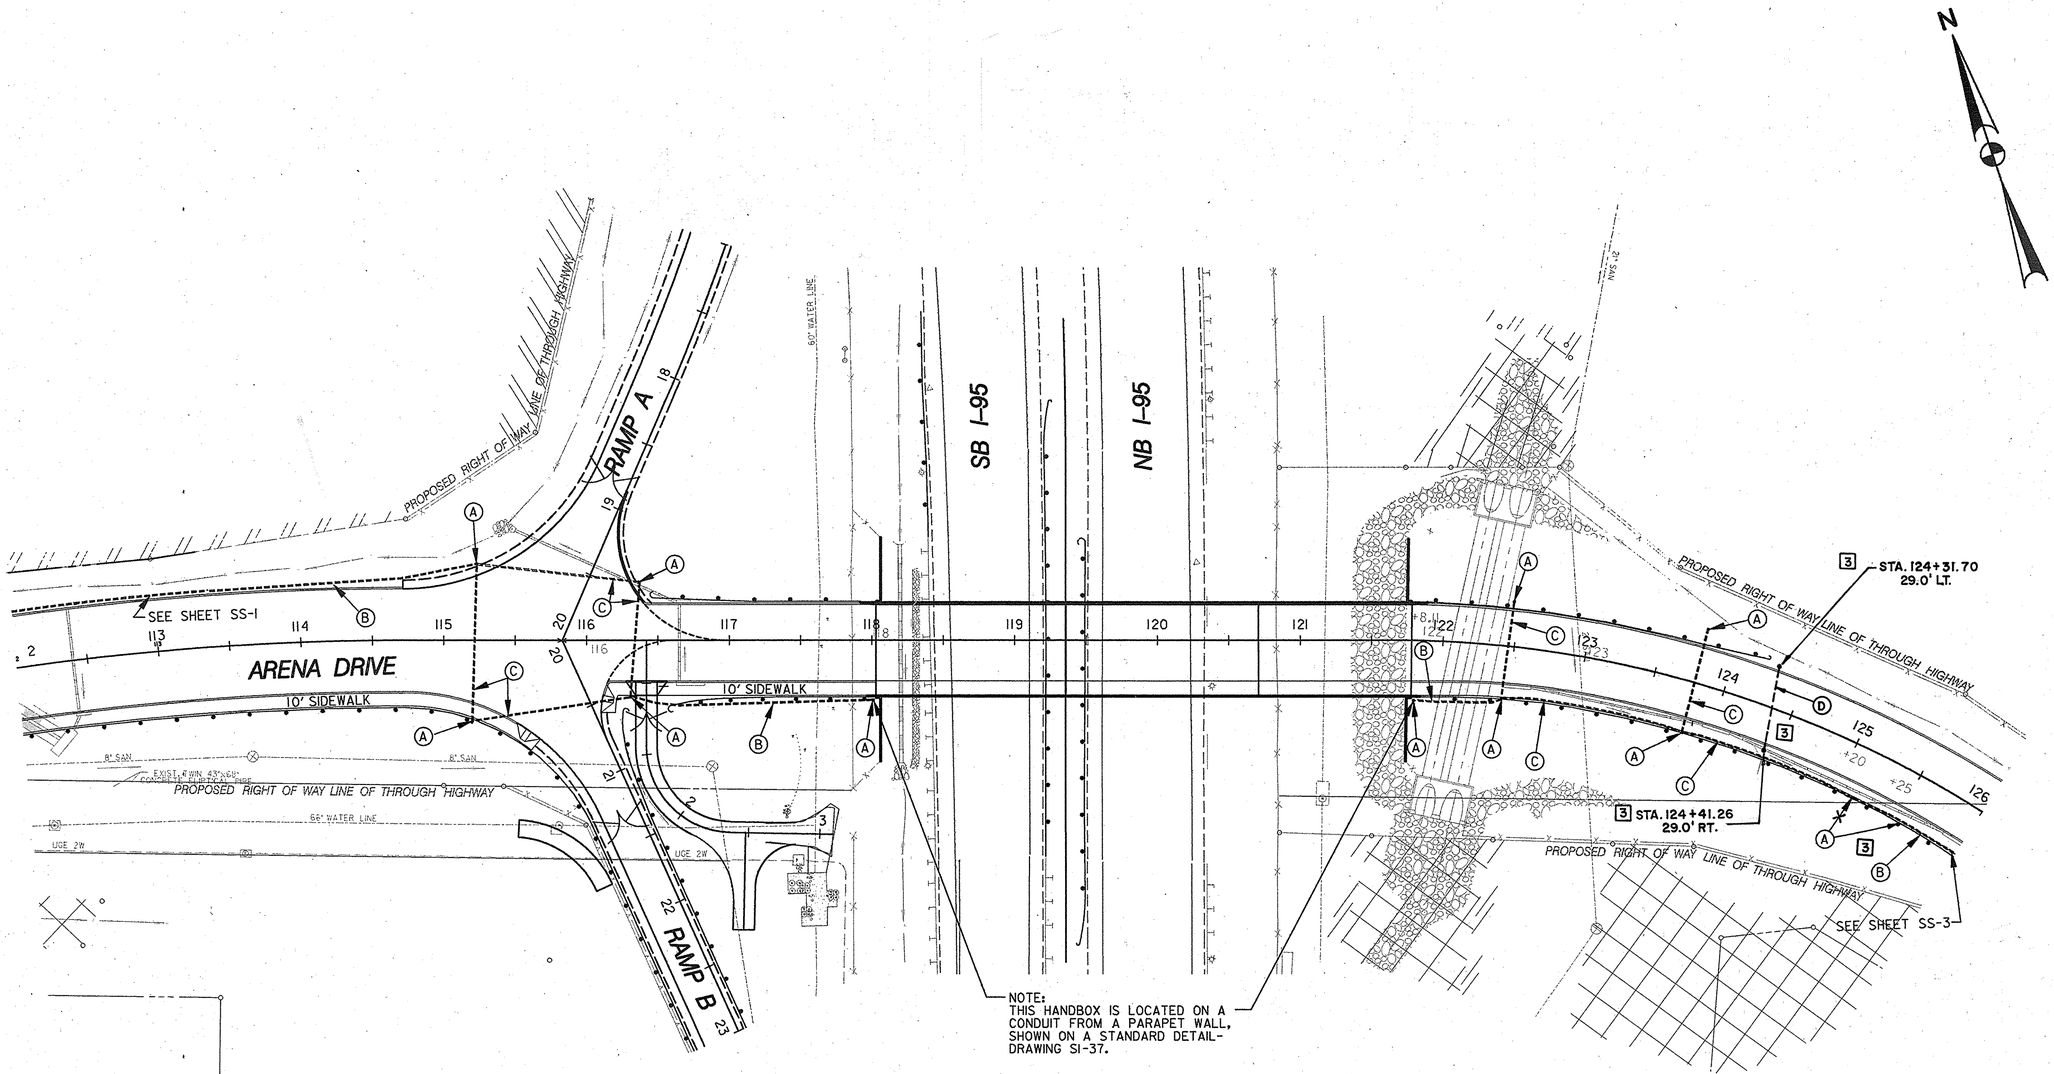

SS-5

CONSTRUCTION NOTES:

A. INSTALL HANDBOX.
B. INSTALL 2" SCHEDULE 40 PVC ELECTRICAL CONDUIT-TRENCHED.
C. INSTALL 3" SCHEDULE 80 PVC ELECTRICAL CONDUIT-TRENCHED.
[3] **D. INSTALL 4" SCHEDULE 80 RIGID POLYVINAL CHLORIDE ELECTRICAL CONDUIT - TRENCH 3' DEEP AND PLUG BOTH ENDS.**

NOTE:
INTERCONNECT WIRING ALONG THE BRIDGE IS LOCATED IN A CONDUIT SITUATED IN A PARAPET WALL.

RKK&K
RUMMEL, KLEPPER & KAHL
CONSULTING ENGINEERS
81 MOSHER STREET
BALTIMORE, MARYLAND 21217
TELE:(410)728-2900 FAX:(410)728-2992

REVISIONS:
[3] REV. 5/1/97

DEPARTMENT OF PUBLIC WORKS AND TRANSPORTATION
PRINCE GEORGE'S COUNTY, MARYLAND

INTERCONNECT PLAN
ARENA DR. @ USAIR ARENA ENTRANCE

SCALE: 1"=20'
DWG. 145 OF 188
APPROVED 8/21/96 DATE
FOR BETTY HAGER FRANCIS, DIRECTOR
DESIGNED: Z.A.J.
DRAWN: Z.A.J.
CHECKED: 8/19/96 MPR
APPRVED:
CHIEF, HIGHWAYS AND BRIDGES 8/20/96 DATE
PROJECT NO. P-189-Z-172
ROAD NO.
JOB NO.
FILE NO.

08/14/96 08:53:08
g:\redskins\ardr\dgn\ss03ardr.dgn (ss03ardr.prf)