F H WA REGION NO	STATE	FED. AID PROJ. NO	SHEET NO.	TOTAL SHEETS
3	MD.			

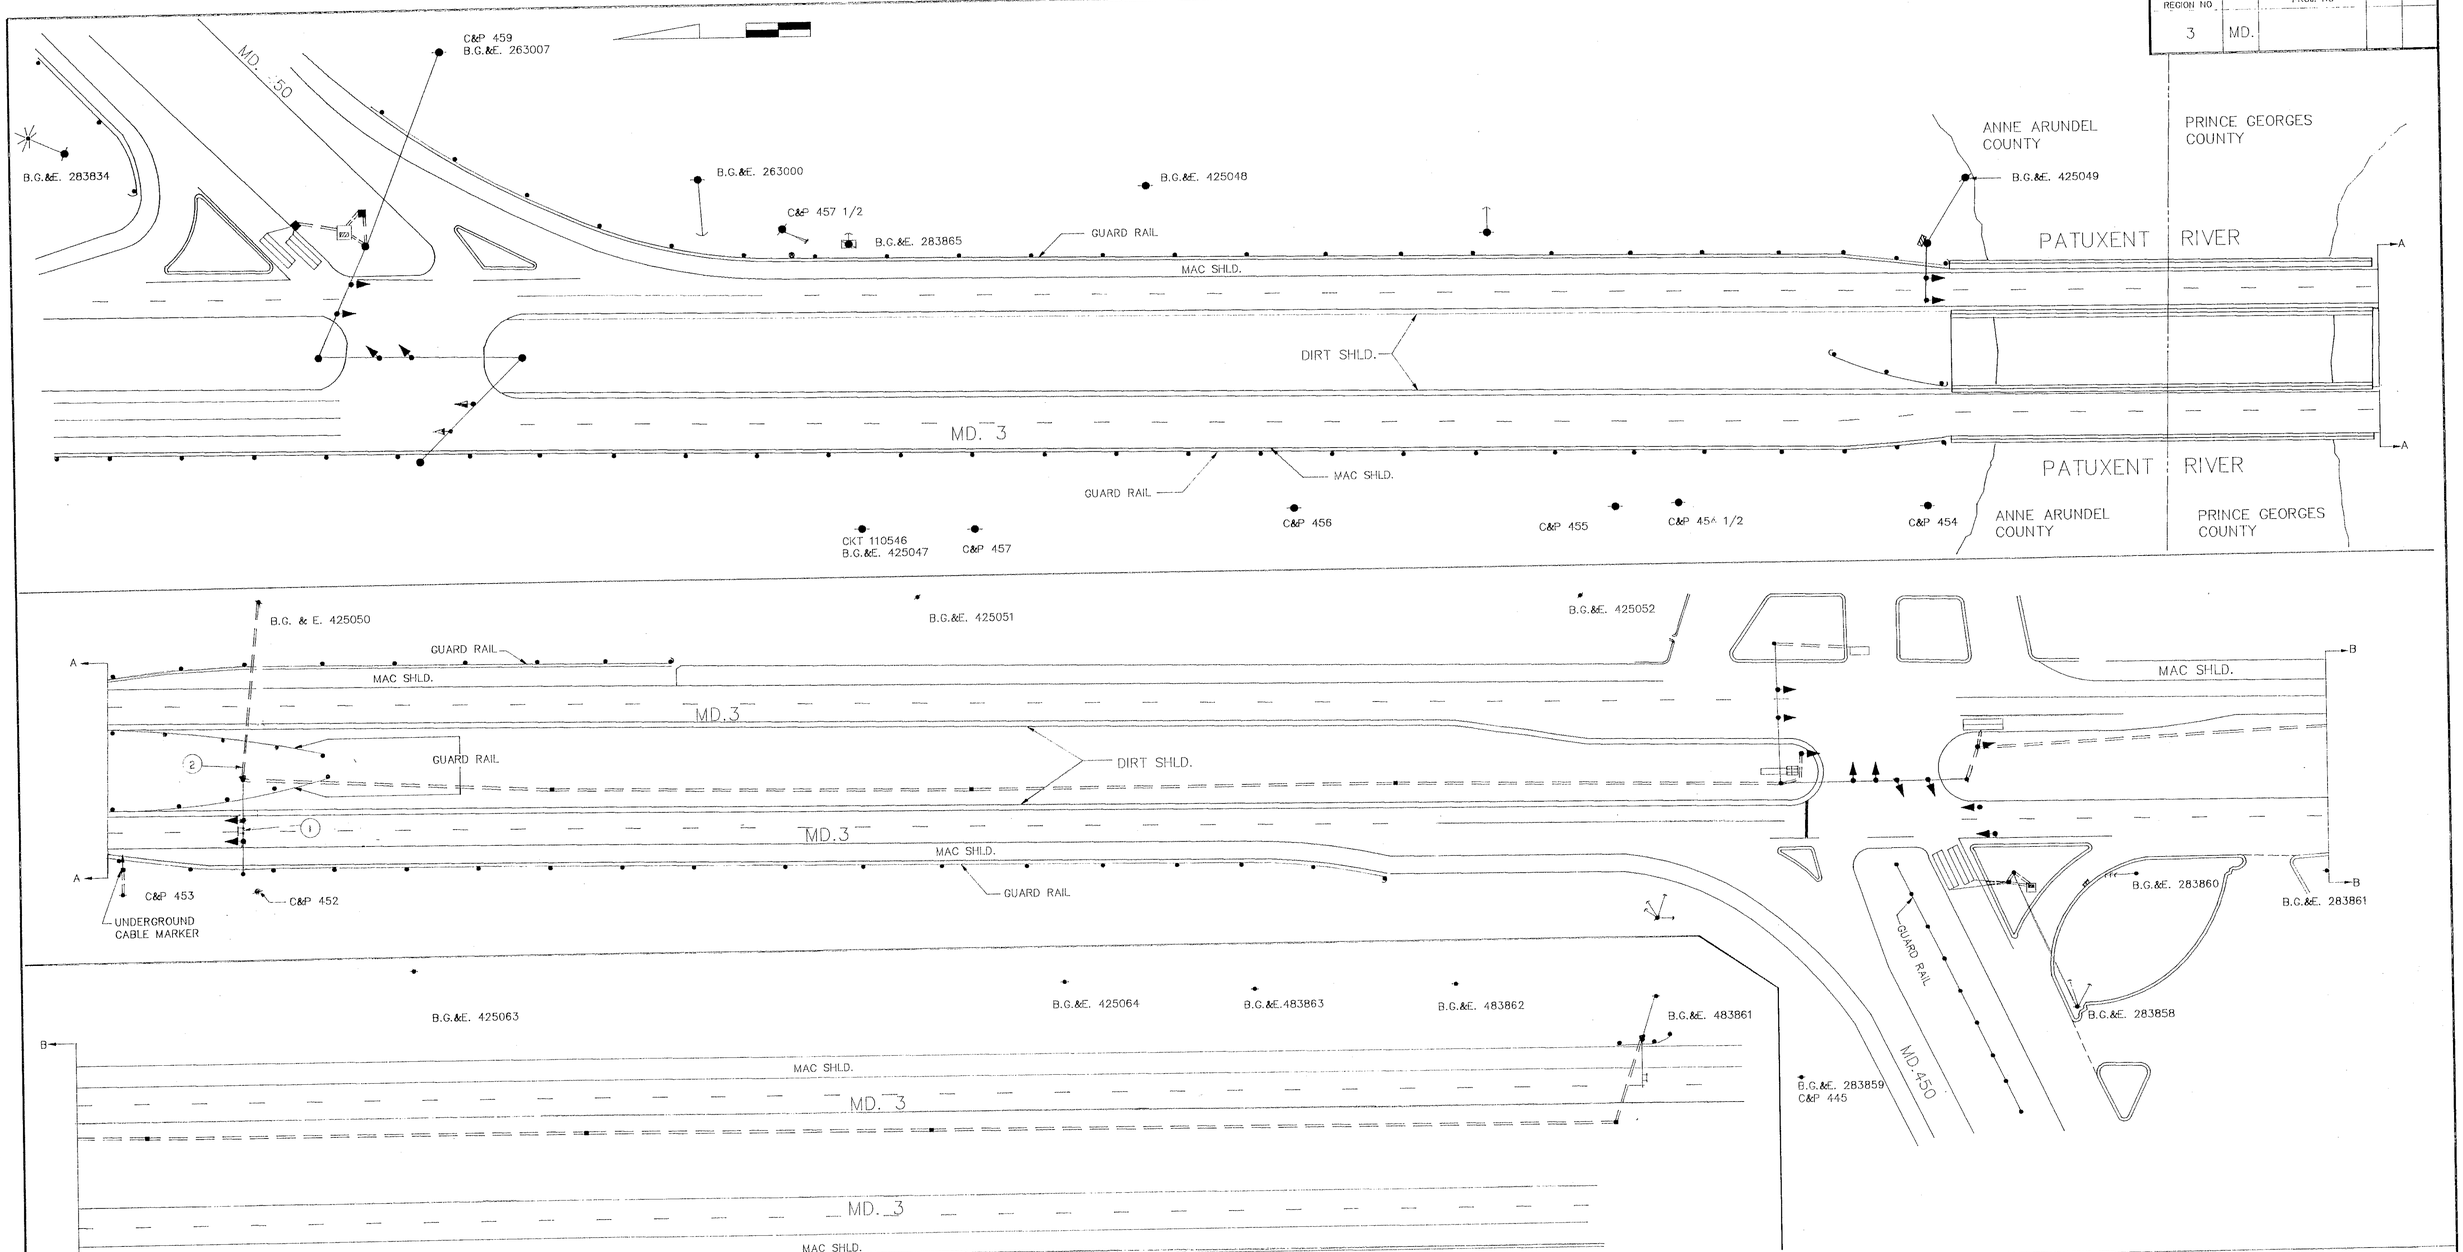

GENERAL NOTES:
1. REVISION "D" IS A MODIFICATION TO WORK COMPLETED UNDER CONTRACT AA-866X-575/P-306X-375, DATED APRIL 24, 1973.
2. THE ORIGINAL TS-834 IS ON FILE.

UTILITY LEGEND

G	G	GAS MAIN
W	W	WATER MAIN
S	S	SEWER MAIN
E	E	ELECTRIC CABLES
A	A	AERIAL CABLES

REVISIONS

D. 11/89 – REMOVAL OF SP MD. 3 HIB. B.G.&E. W.M. 5/22/91 BY RRW
C. JUNE 13,1978 ADD ADVANCE SIGNAL AHEAD FLASHER – AW-359-506-085
B.R.K. | E.P. | T.E.E. | T.H. | B.T.
B. 8/7/73 AS BUILT
PM
A. APRIL 24,1973 – REVISED MAST ARM FOR RED SIGNAL AHEAD SIGN TO OVERHEAD BOOM
JB

APPROVALS

ORIGINAL ON FILE

CHIEF, DESIGN SECTION
ASST. DISTRICT ENGINEER, TRAFFIC
CHIEF, TRAFFIC ENGINEERING DIVISION
DEPUTY CHIEF ENGINEER, OFFICE OF TRAFFIC

MDOT – STATE HIGHWAY ADMINISTRATION
Office of Traffic
TRAFFIC ENGINEERING DIVISION

REDRAWN BY: W. MALCOLM/ACAD
~~DRAWN BY:~~
REDES. BY: W. MALCOLM
~~DES. BY:~~
CHK. BY:

MD. 3 & MD. 450 INTERCONNECT

SIGNAL NO. 16318 (S. OF MD. 450 WEST) &
SIGNAL NO. 16317 (S. OF PATUXENT)

ANNE ARUNDEL–
COUNTY: PRINCE GEORGES

DATE: 12/89
SCALE: 1" = 50'
F.A.P. NO.
S.H.A. NO. AA-866X-575/P-306X-375

TS/STD. NO. TS-834 (D)

SHEET NO. 1 OF 1

16000302.00