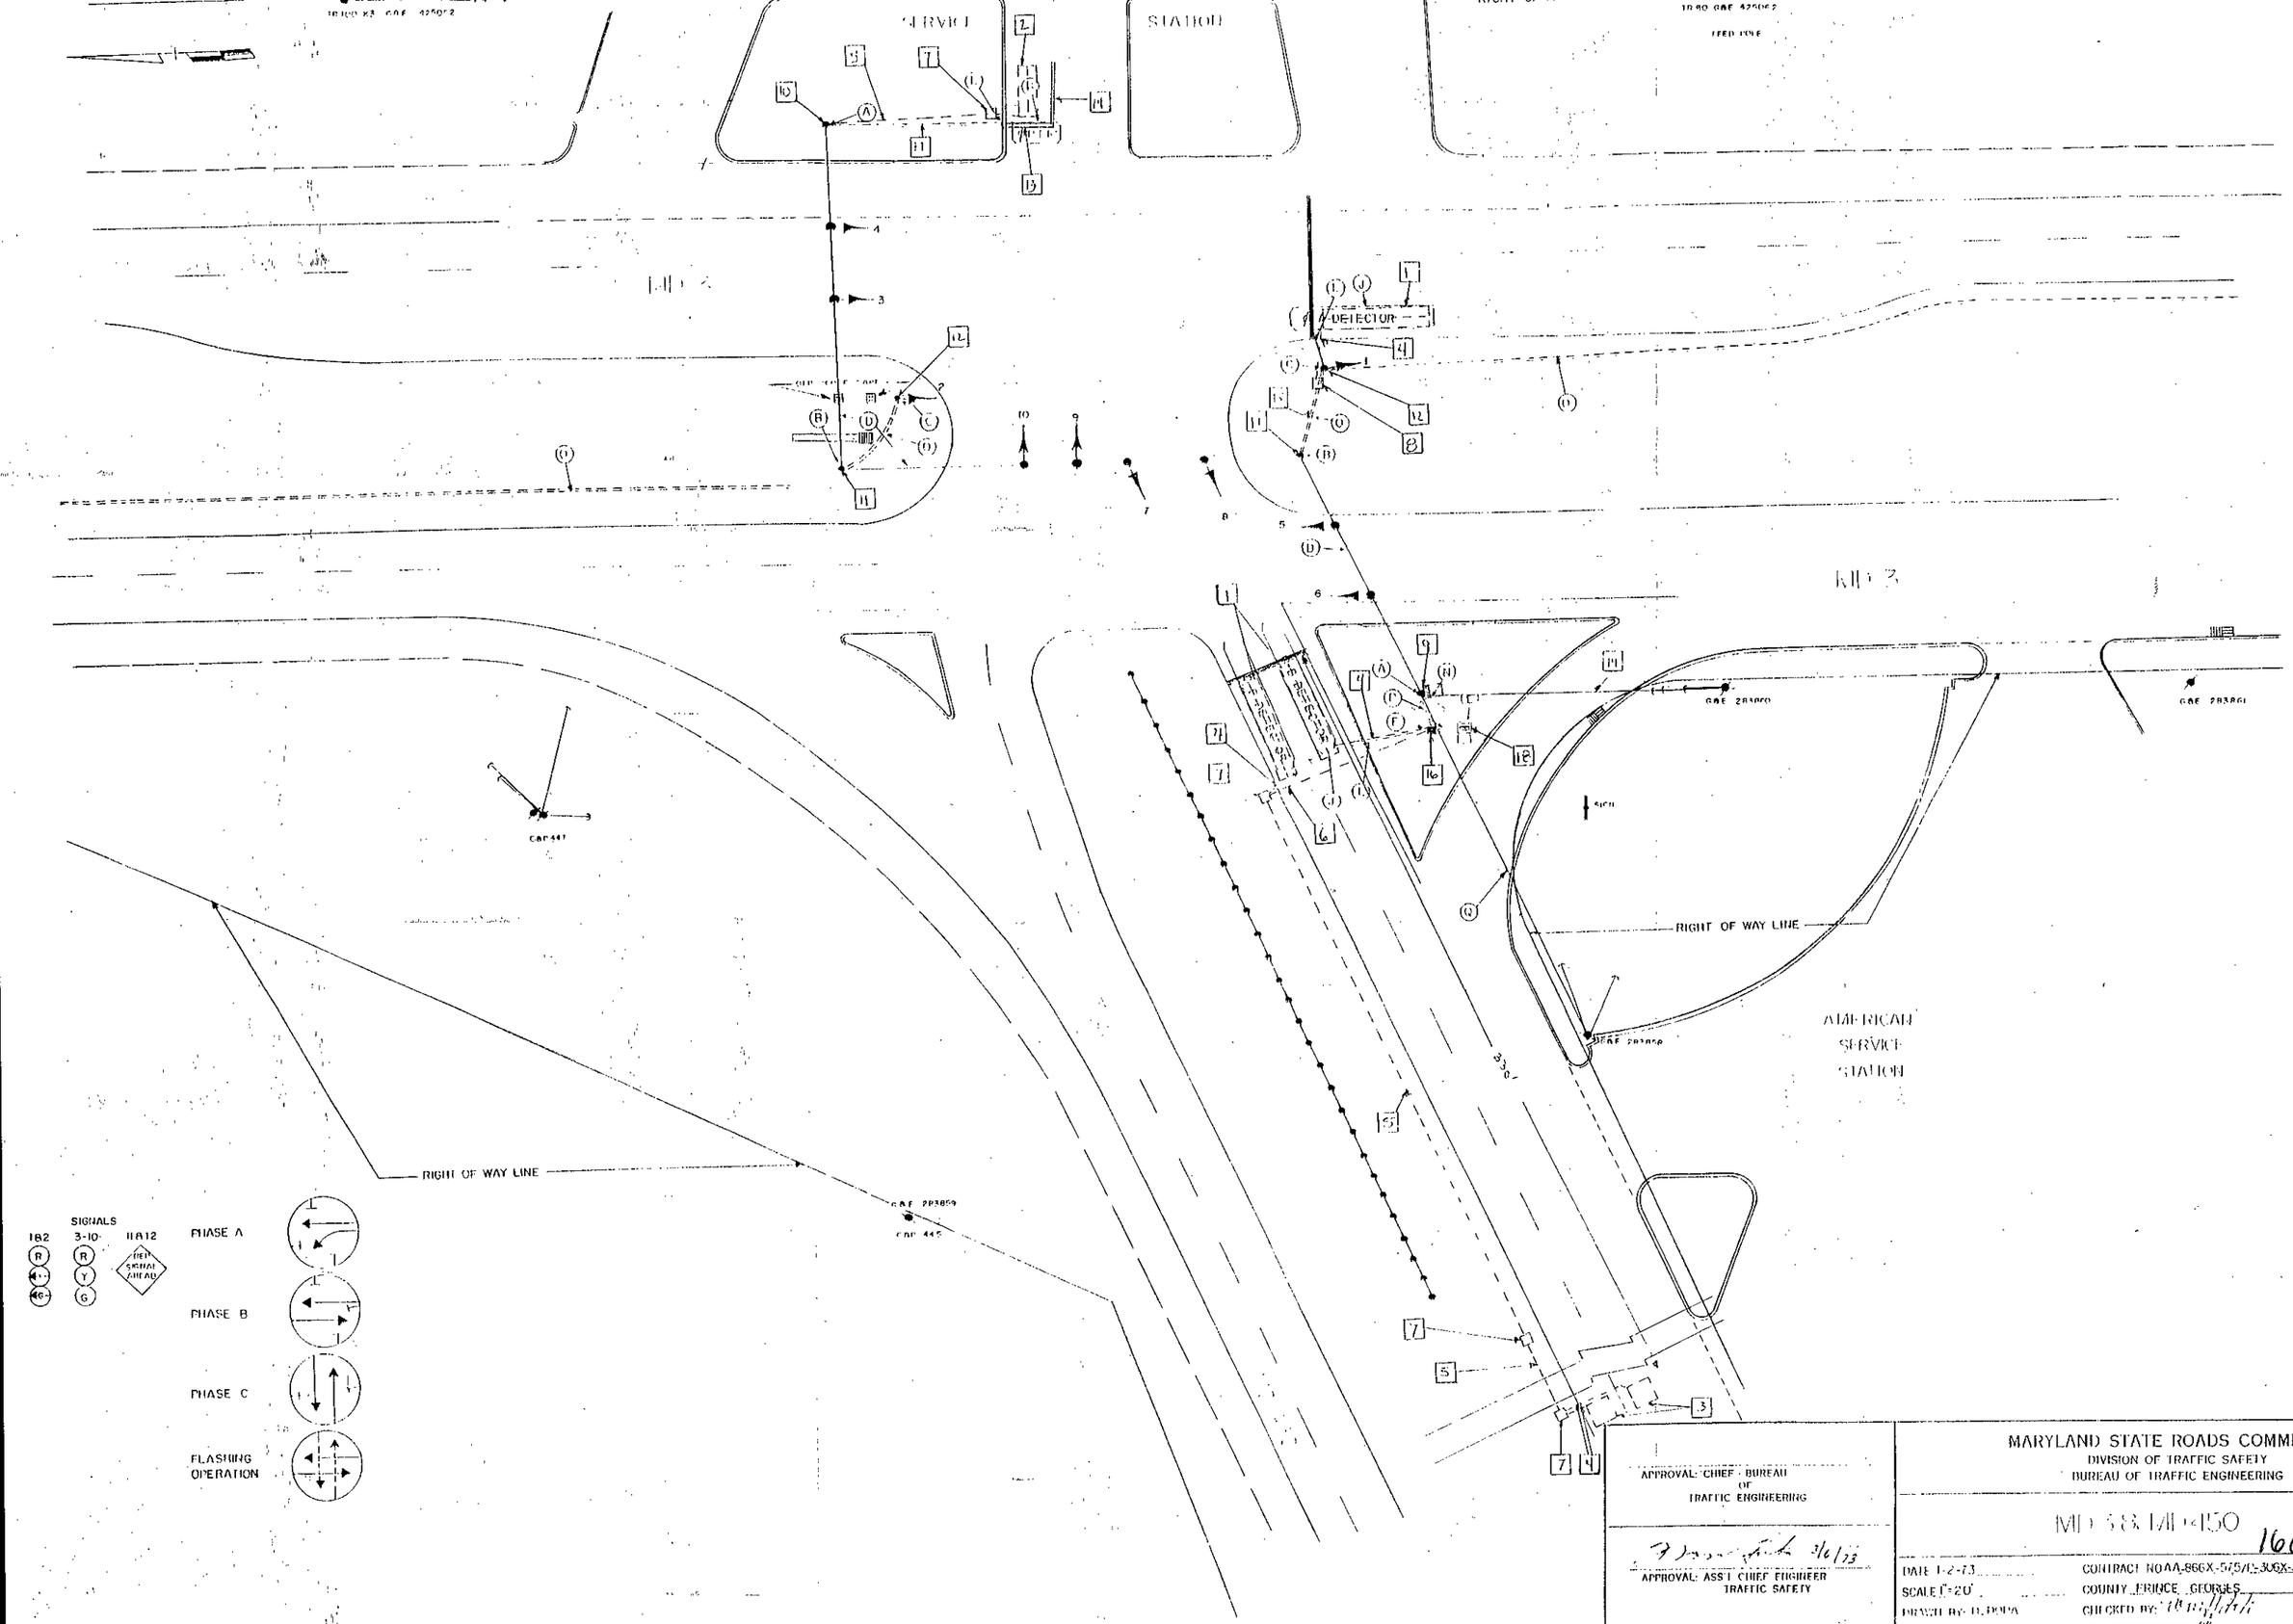

B	REPLACE FAILED LOOP DETECTOR
S.H.A. NO.	
A	8-1-73 ASBUILT
JG	

REVISIONS

APPROVAL: CHIEF - BUREAU OF TRAFFIC ENGINEERING

APPROVAL: ASS'T CHIEF ENGINEER TRAFFIC SAFETY

3/6/73

MARYLAND STATE ROADS COMMISSION
DIVISION OF TRAFFIC SAFETY
BUREAU OF TRAFFIC ENGINEERING

MD 3 & MD 450

16000302.25

DATE 1-2-73
SCALE 1"=20'
DRAWN BY: D. DORA

CONTRACT NO AA-866X-575/D-306X-375
COUNTY PRINCE GEORGES
CHECKED BY:

DRAWING NO. TS 512 A