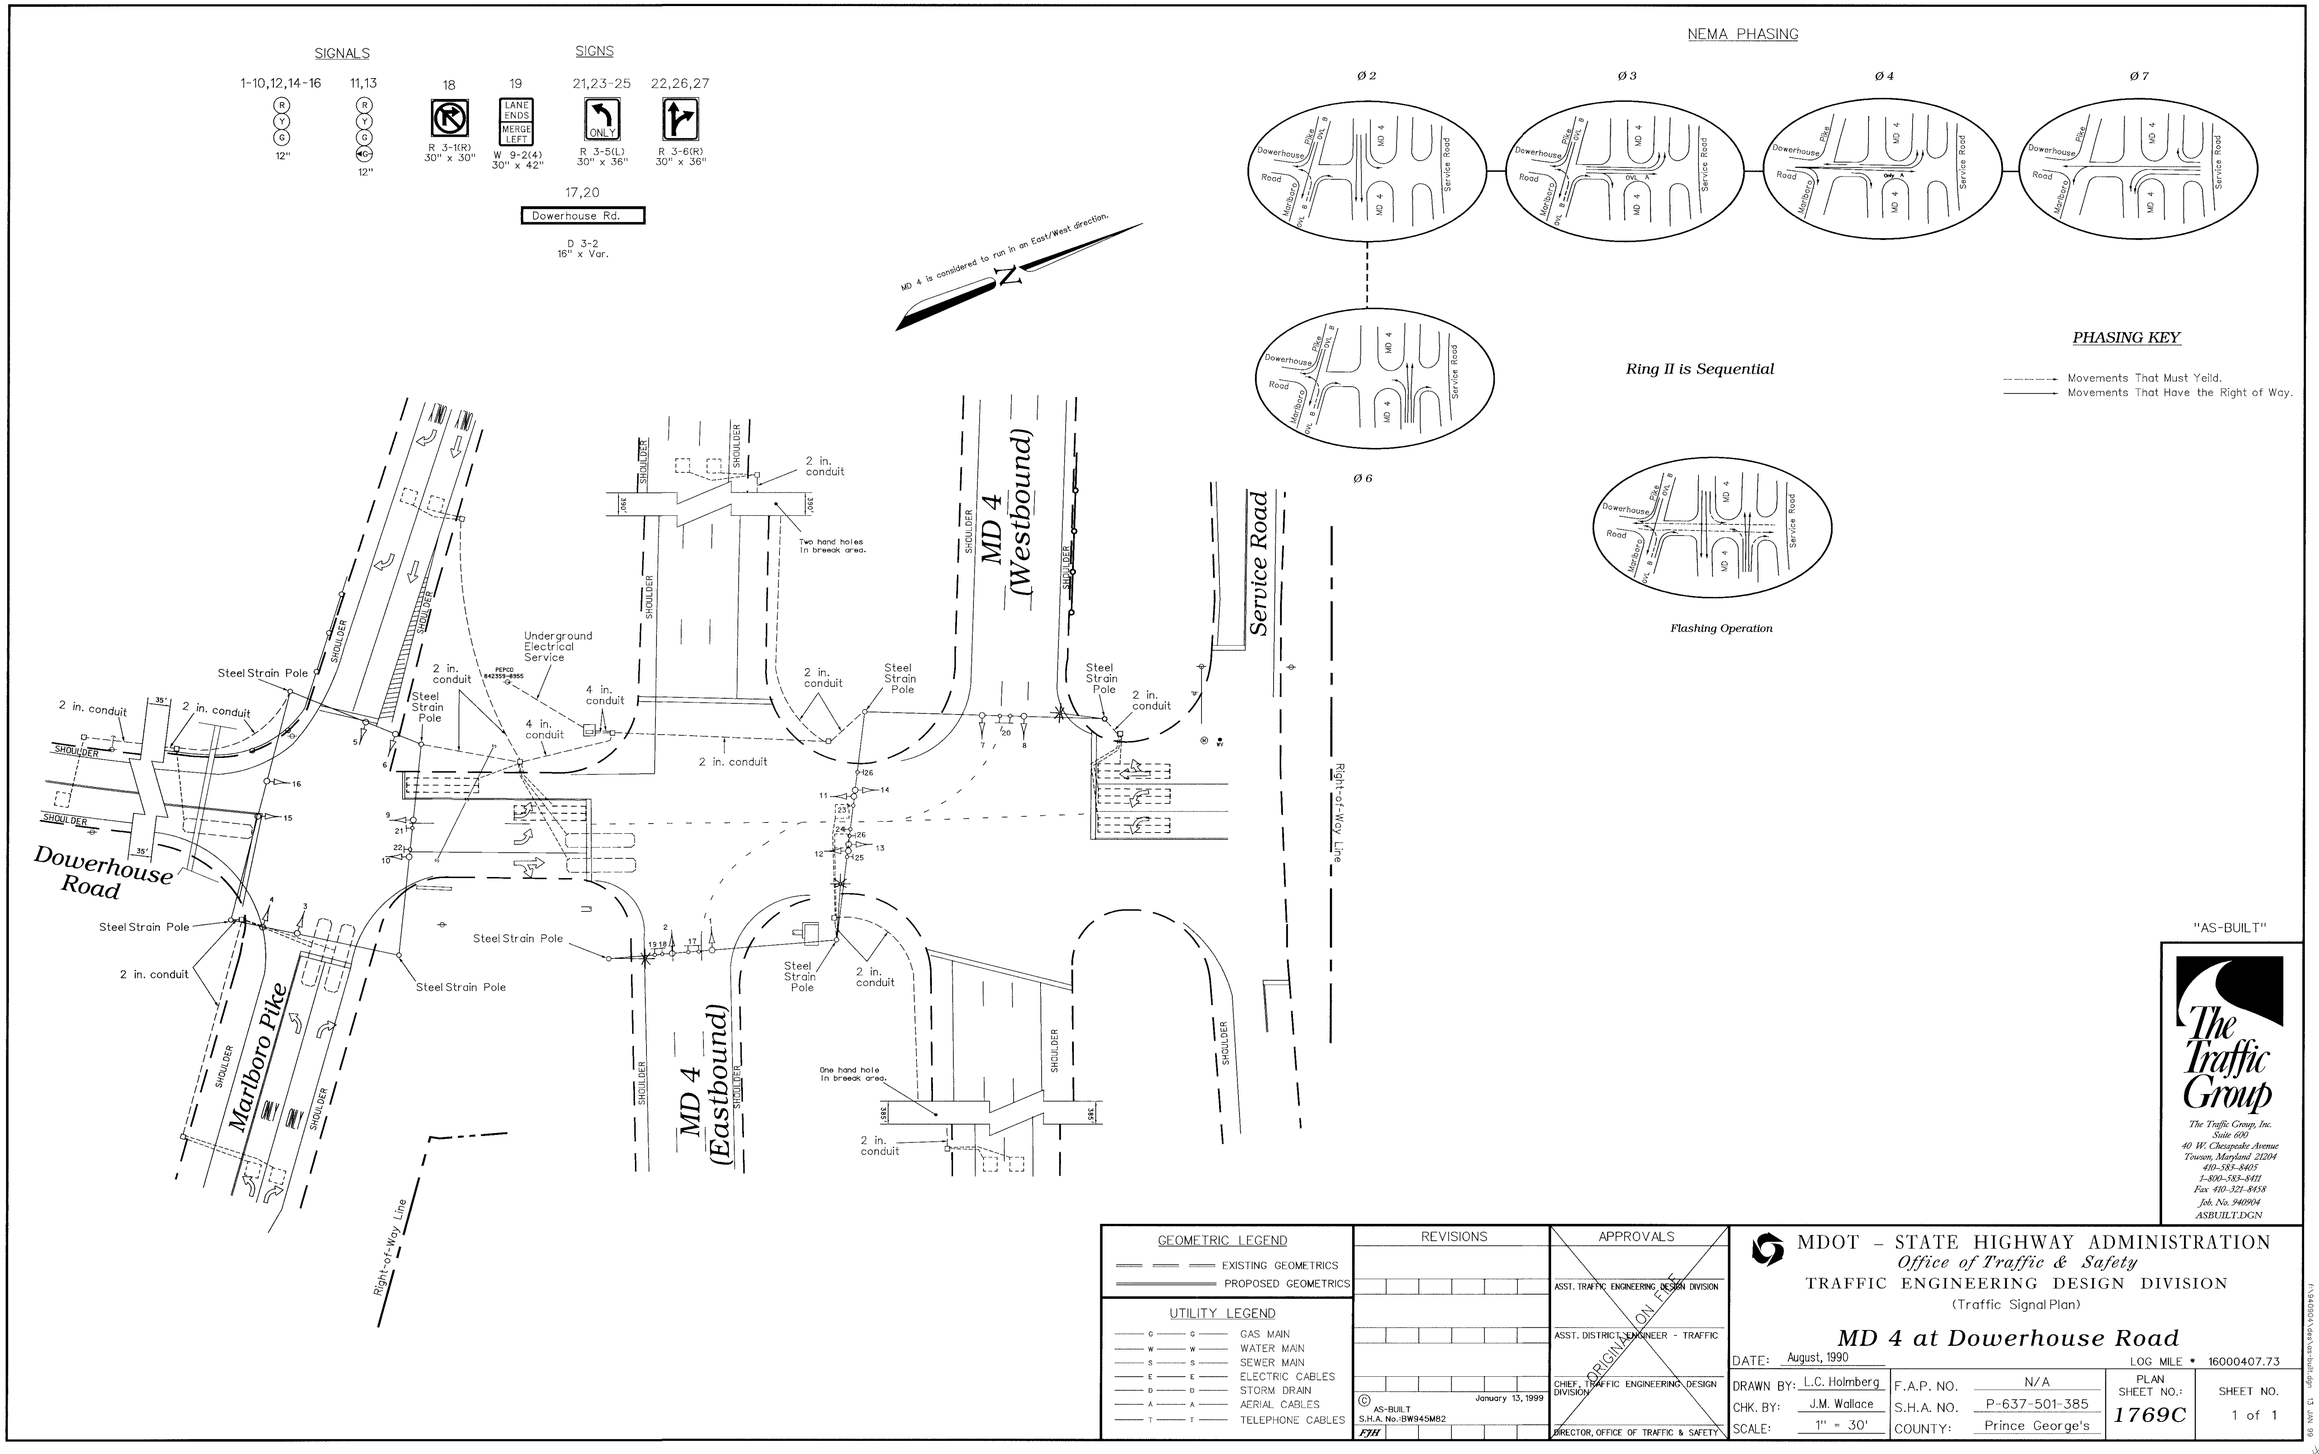

SIGNALS
1-10,12,14-16
11,13
12"
12"
SIGNS
18
R 3-1(R)
30" x 30"
19
LANE ENDS
MERGE LEFT
W 9-2(4)
30" x 42"
21,23-25
ONLY
R 3-5(L)
30" x 36"
22,26,27
R 3-6(R)
30" x 36"
17,20
Dowerhouse Rd.
D 3-2
16" x Var.
MD 4 is considered to run in an East/West direction.
N
NEMA PHASING
Ø 2
Ø 3
Ø 4
Ø 7
Ø 6
Dowerhouse Road
Marlboro Pike
MD 4
Service Road
Ring II is Sequential
Flashing Operation
PHASING KEY
Movements That Must Yeild.
Movements That Have the Right of Way.
Steel Strain Pole
2 in. conduit
Underground Electrical Service
4 in. conduit
Two hand holes in breeck area.
One hand hole in breeck area.
SHOULDER
Dowerhouse Road
Marlboro Pike
MD 4 (Westbound)
MD 4 (Eastbound)
Service Road
Right-of-Way Line
"AS-BUILT"
The Traffic Group
The Traffic Group, Inc.
Suite 600
40 W. Chesapeake Avenue
Towson, Maryland 21204
410-583-8405
1-800-583-8411
Fax 410-321-8458
Job. No. 940904
ASBUILT.DGN
GEOMETRIC LEGEND
EXISTING GEOMETRICS
PROPOSED GEOMETRICS
UTILITY LEGEND
GAS MAIN
WATER MAIN
SEWER MAIN
ELECTRIC CABLES
STORM DRAIN
AERIAL CABLES
TELEPHONE CABLES
REVISIONS
APPROVALS
ASST. TRAFFIC ENGINEERING DESIGN DIVISION
ASST. DISTRICT ENGINEER - TRAFFIC
CHIEF, TRAFFIC ENGINEERING DESIGN DIVISION
DIRECTOR, OFFICE OF TRAFFIC & SAFETY
ORIGINAL ON FILE
© AS-BUILT
January 13, 1999
S.H.A. No.:BW945M82
FJH
MDOT - STATE HIGHWAY ADMINISTRATION
Office of Traffic & Safety
TRAFFIC ENGINEERING DESIGN DIVISION
(Traffic Signal Plan)
MD 4 at Dowerhouse Road
DATE: August, 1990
LOG MILE • 16000407.73
DRAWN BY: L.C. Holmberg
CHK. BY: J.M. Wallace
SCALE: 1" = 30'
F.A.P. NO. N/A
S.H.A. NO. P-637-501-385
COUNTY: Prince George's
PLAN SHEET NO.: 1769C
SHEET NO. 1 of 1