FHWA REGION NO.	STATE	FED. AID PROJ. NO.	SHEET NO.	TOTAL SHEETS
3	MD			

SIGNALS

1,2,6,7,11,15 — 12"

3-5,8-10,12-14,16-18 — 12"

19-24 — 12"

SIGNS

26-28 — R 3-5(L) 30" x 36"

25a,29a — Silver Hill Road

25b,29b — Silver Hill Road

D 3-2 16" x Var. (Duale Faced)

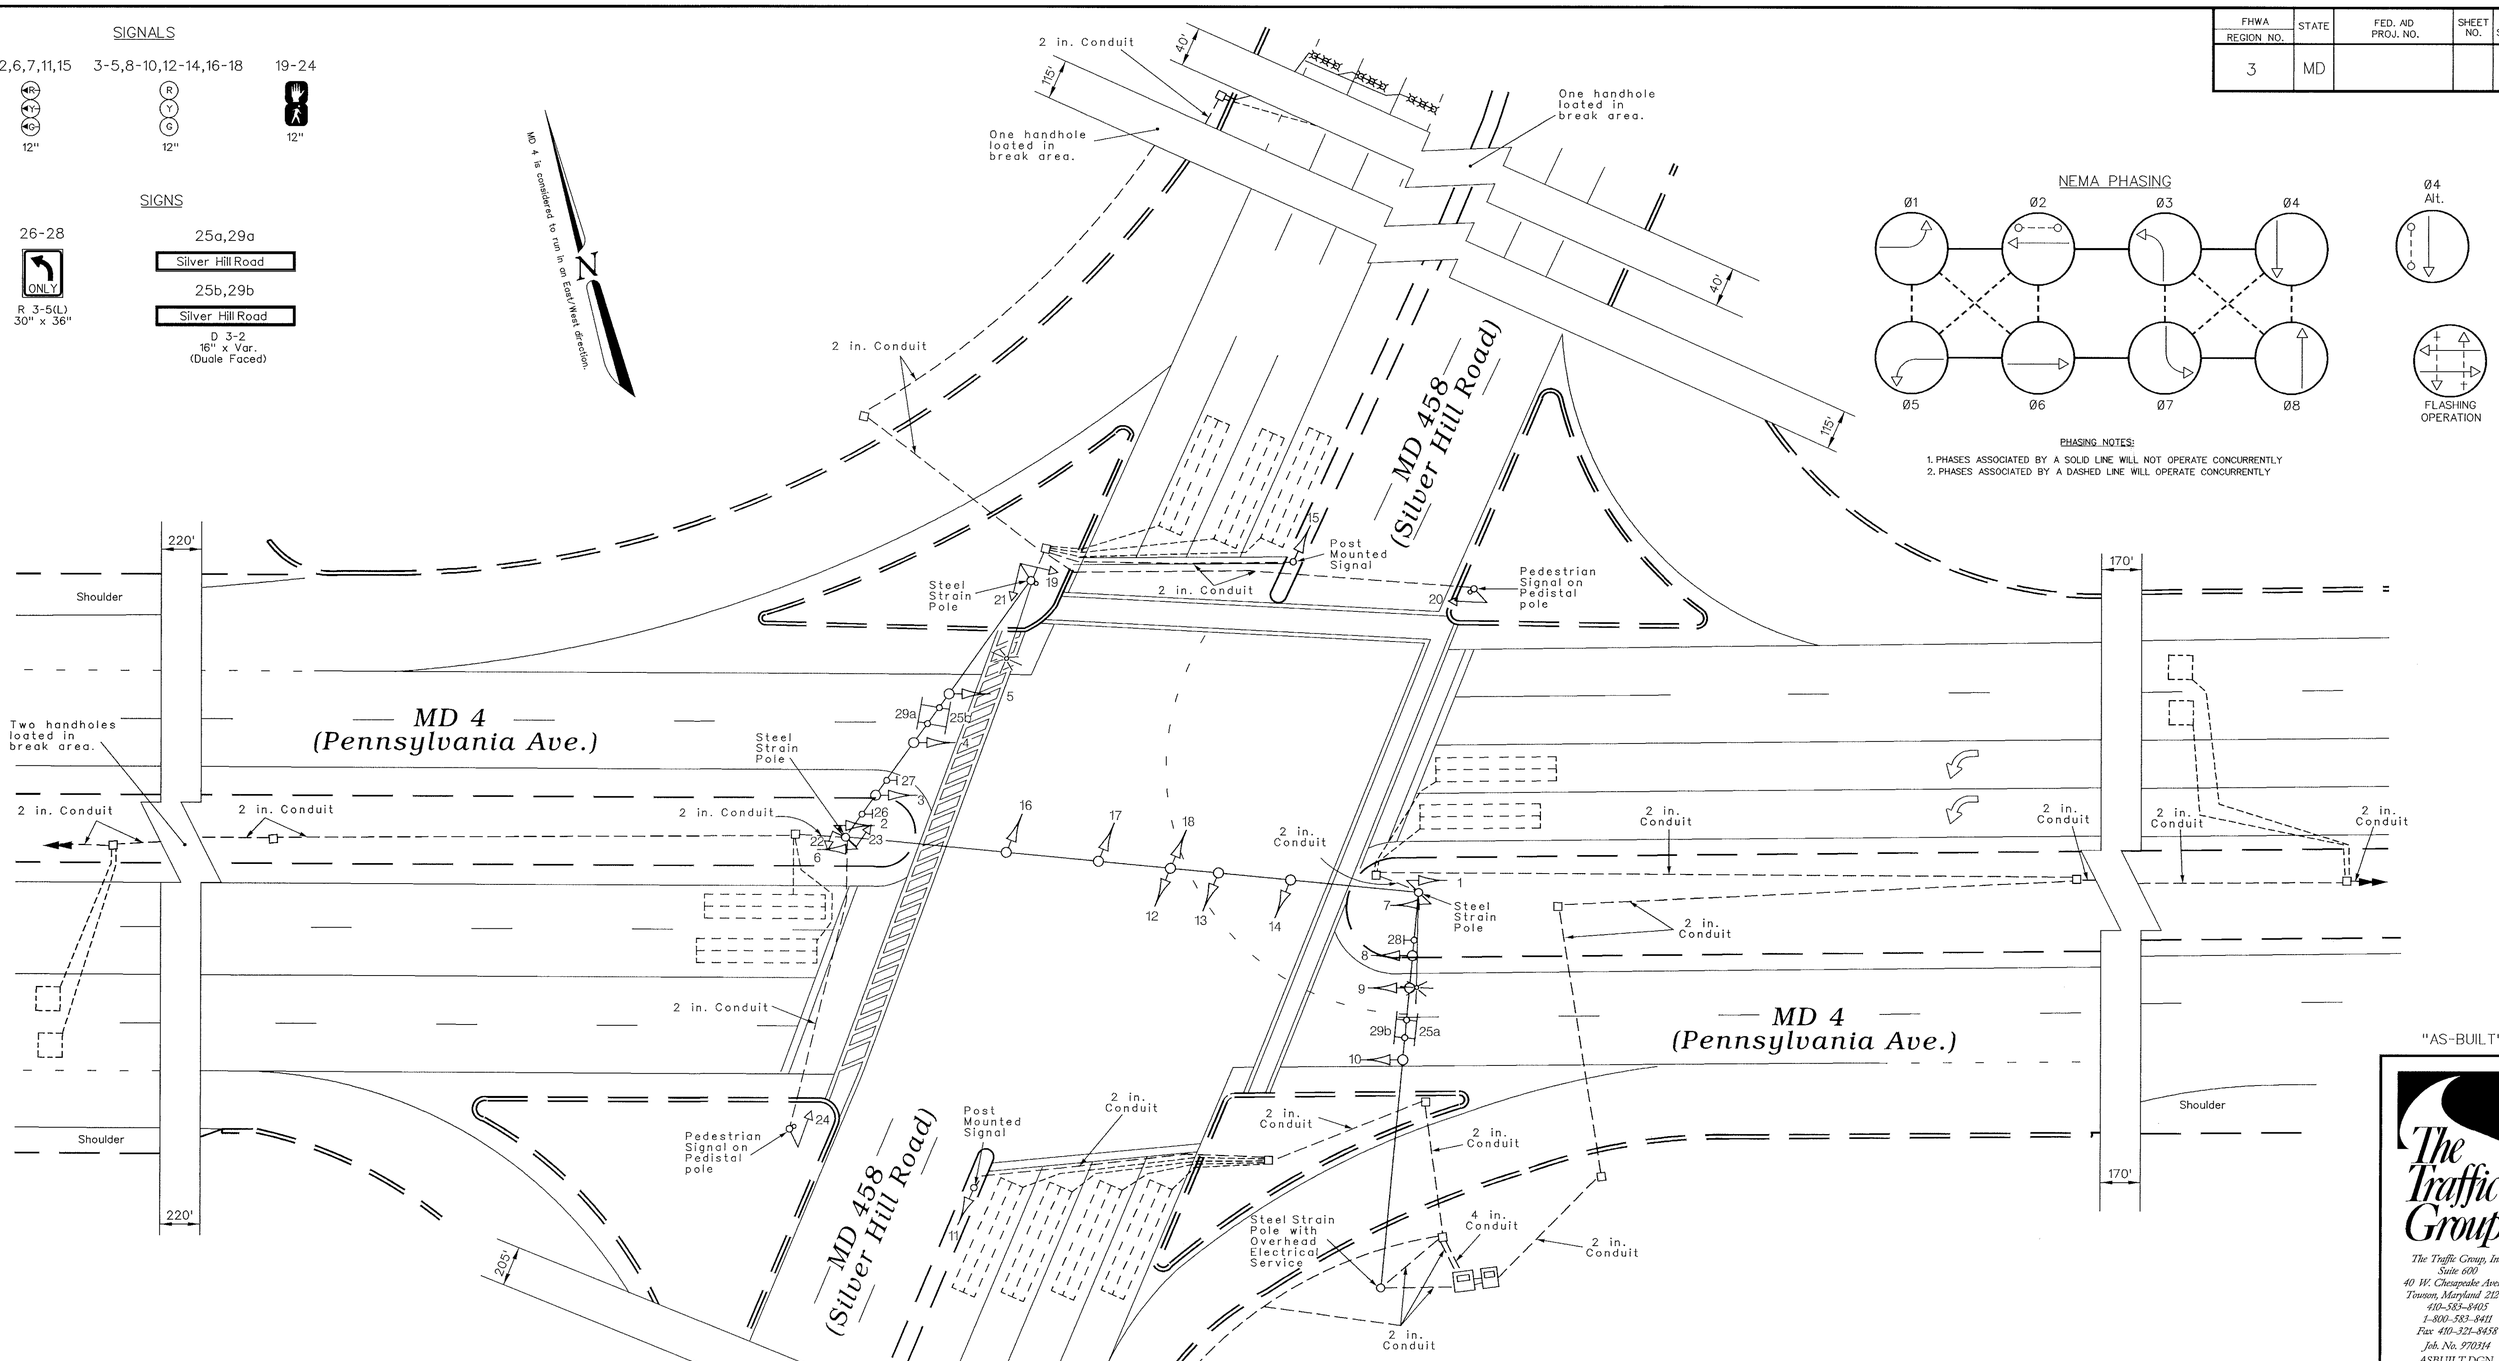

"AS-BUILT"

The Traffic Group
The Traffic Group, Inc.
Suite 600
40 W. Chesapeake Avenue
Towson, Maryland 21204
410-583-8405
1-800-583-8411
Fax 410-321-8458
Job. No. 970314
ASBUILT.DGN

GEOMETRIC LEGEND

EXISTING GEOMETRICS

PROPOSED GEOMETRICS

UTILITY LEGEND

G	GAS MAIN
W	WATER MAIN
S	SEWER MAIN
E	ELECTRIC CABLES
D	STORM DRAIN
A	AERIAL CABLES
T	TELEPHONE CABLES

REVISIONS	APPROVALS
	ASST. DIVISION CHIEF TRAFFIC ENGINEERING DESIGN DIVISION
	CHIEF, TRAFFIC ENGINEERING DESIGN DIVISION
	ASST. DISTRICT ENGINEER - TRAFFIC
(F) March 11, 1998 ASBUILT S.H.A. No.: BW-190-801-312 FTH	DIRECTOR, OFFICE OF TRAFFIC & SAFETY

ORIGINAL ON FILE

MDOT – STATE HIGHWAY ADMINISTRATION

Office of Traffic & Safety

TRAFFIC ENGINEERING DESIGN DIVISION

DRAWN BY: M. Storck

DES. BY: M. Storck

CHK. BY: Steve Renzi

(Traffic Signal Plan)

MD 4 (Pennsylvania Ave.) and MD 458 (Sillver Hill Road)

COUNTY: PRINCE GEORGE'S — LOG MILE • 16000412.01

DATE: October 10, 1993 — F.A.P. NO. N/A

SCALE: 1" = 20' — S.H.A. NO. BW614-802-312

TS/STD. NO. 837F

SHEET NO. 1 of 1