K&E 19 1153 6-81 MC 26474

F.H.W.A. REGION NO.	STATE	FED. AID PROJ. NO.	SHEET NO.	TOTAL SHEETS
3	MD.	HES 000S (90)	4	7

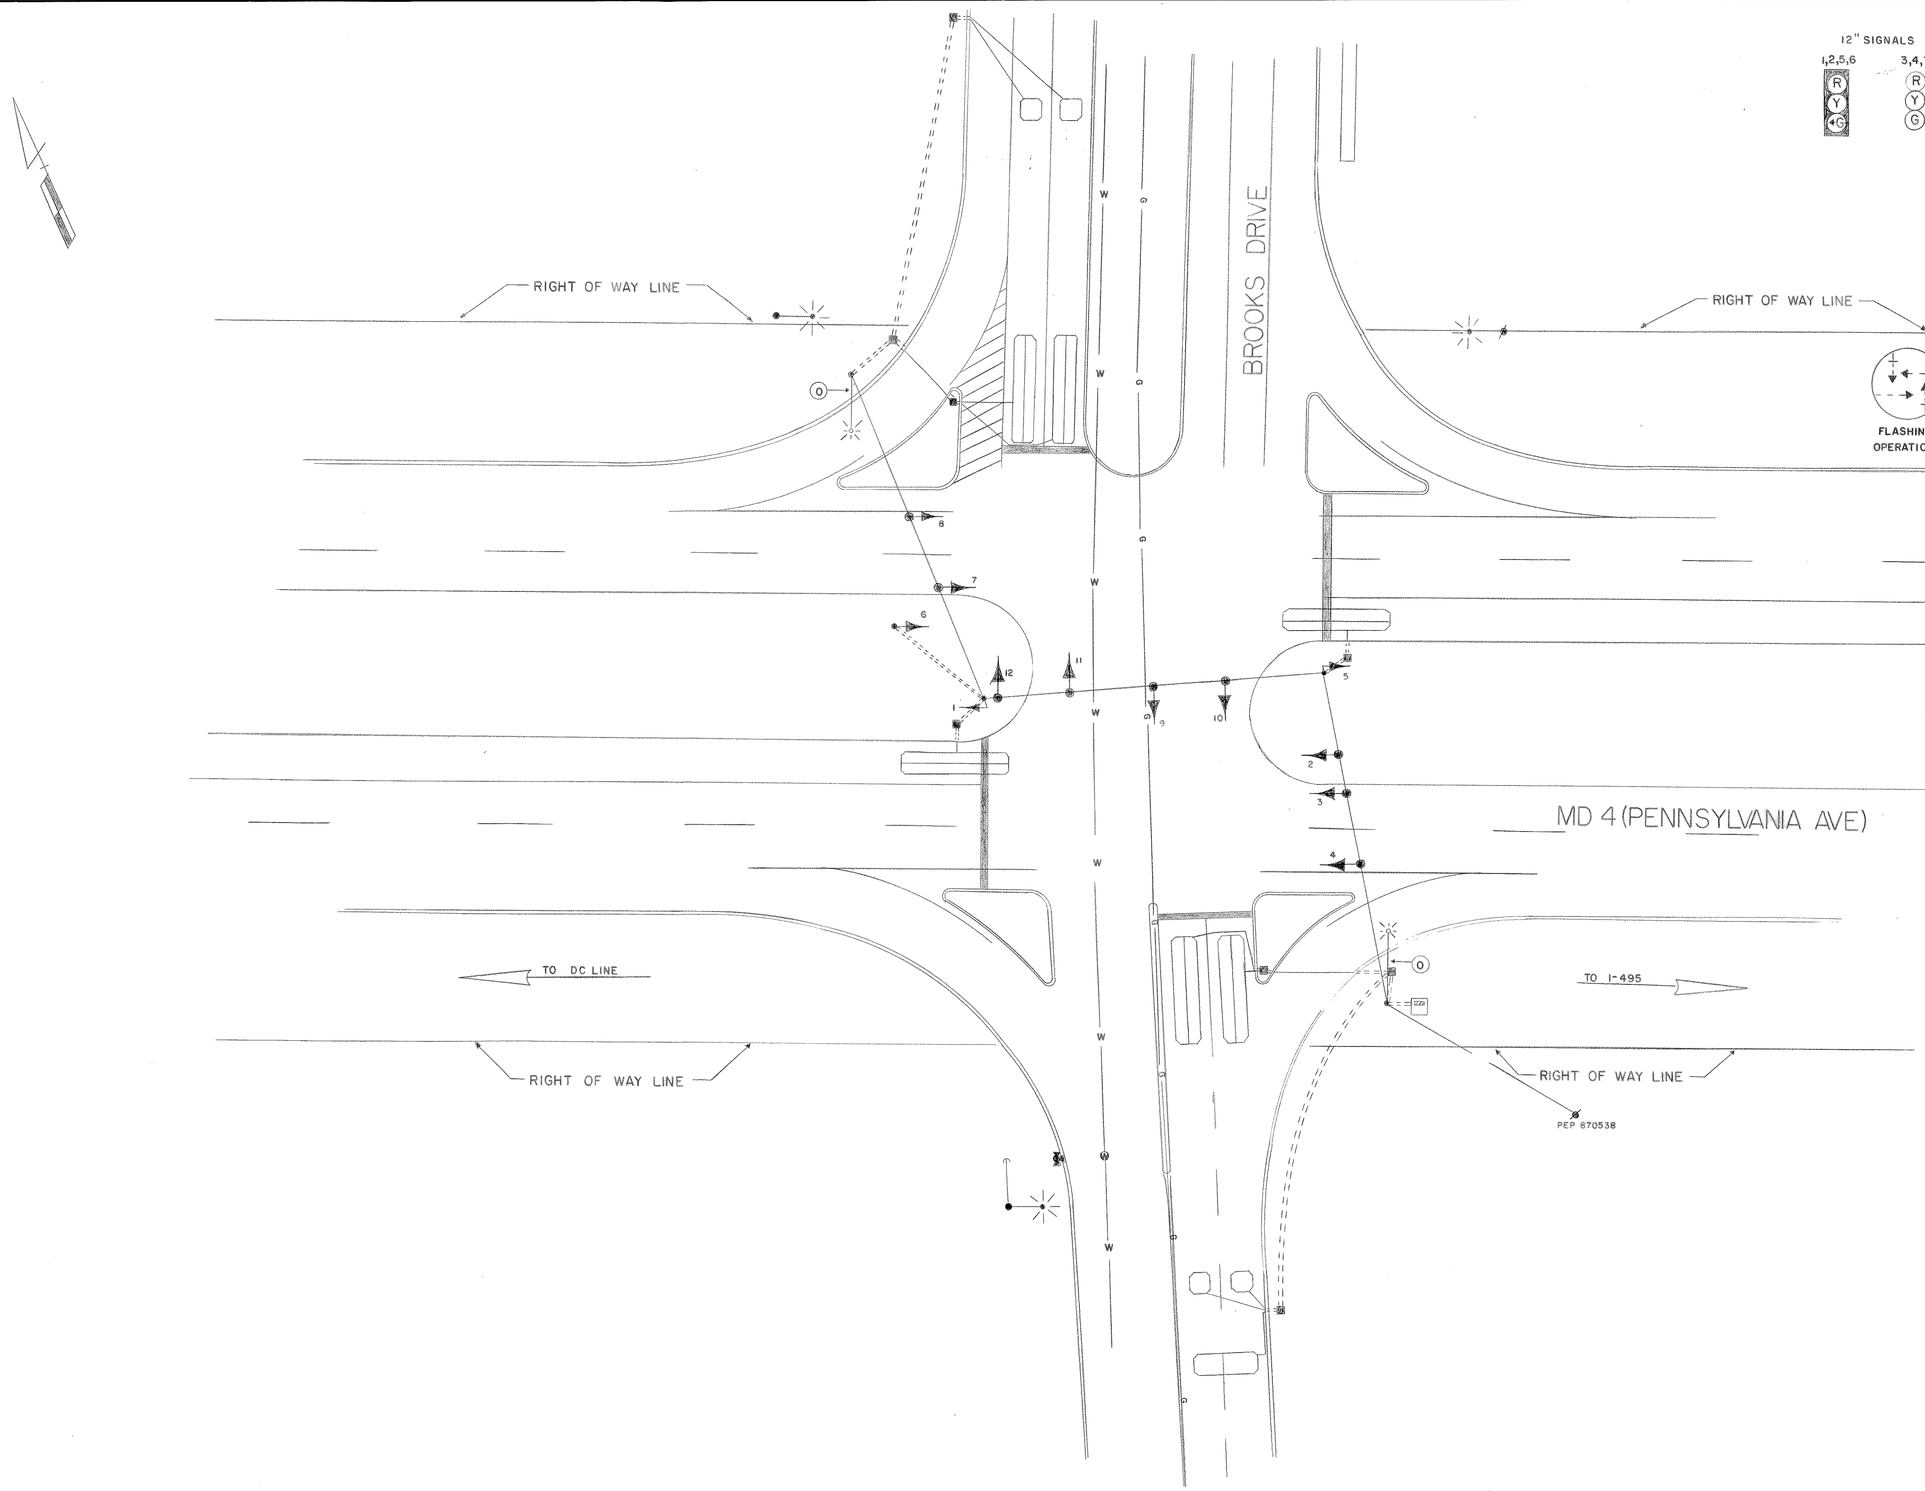

APPROVAL: CHIEF SIGNAL DESIGN SECTION

APPROVAL: REGIONAL TRAFFIC ENGINEER

APPROVAL: CHIEF-BUREAU OF TRAFFIC ENGINEERING

APPROVAL: ASS'T. CHIEF ENGINEER TRAFFIC

(A) 7-84
REDRAWN, ASBUILT, ADD INTERSECTION LIGHTING
KWS

REVISIONS

STATE OF MARYLAND
DEPARTMENT OF TRANSPORTATION
STATE HIGHWAY ADMINISTRATION

TRAFFIC DIVISION – BUREAU OF TRAFFIC ENGINEERING

MD 4 & BROOKS DRIVE

SCALE 1"=20' DATE 7-6-84 CONTRACT NO. P-333-1-385 FAP NO T-8006(25)

DRAWN BY: A HOFFMAN COUNTY: PRINCE GEORGE

DESIGNED BY: SIGNAL NO.: 16205

CHECKED BY:

DRAWING NO. TS-963A