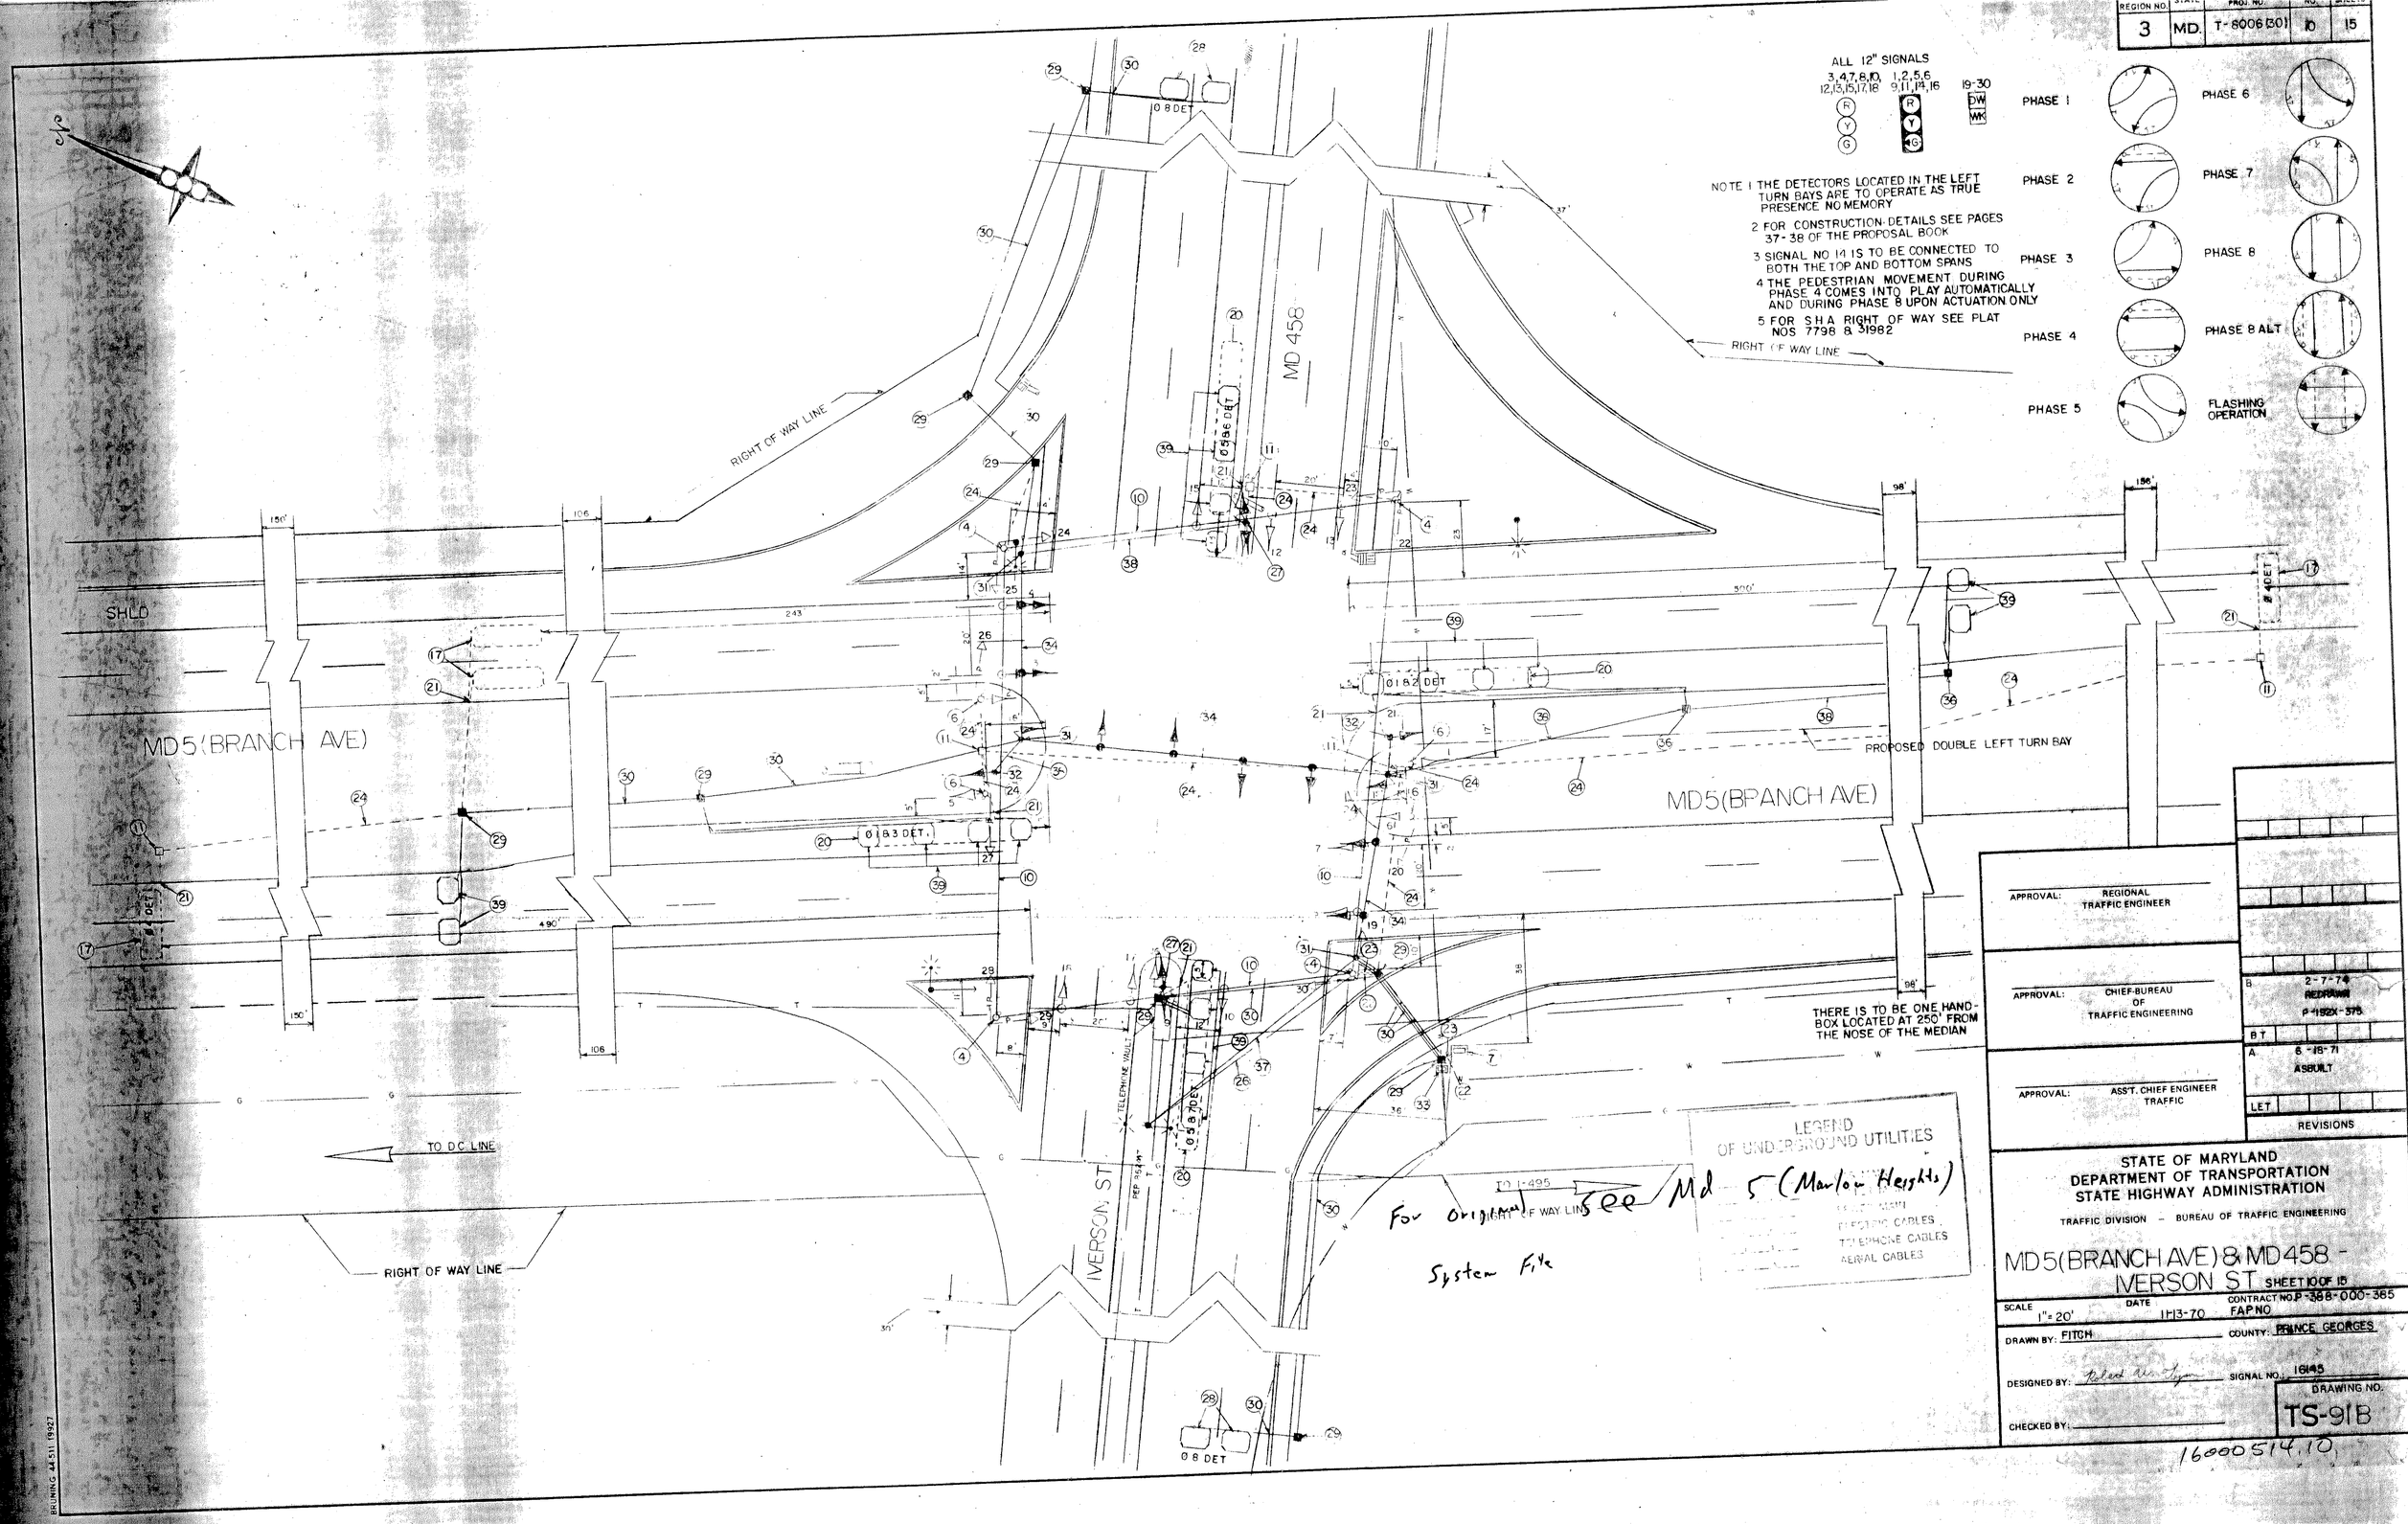REGION NO.	STATE	PROJ. NO.	NO.	SHEETS
3	MD.	T-8006(301)	10	15