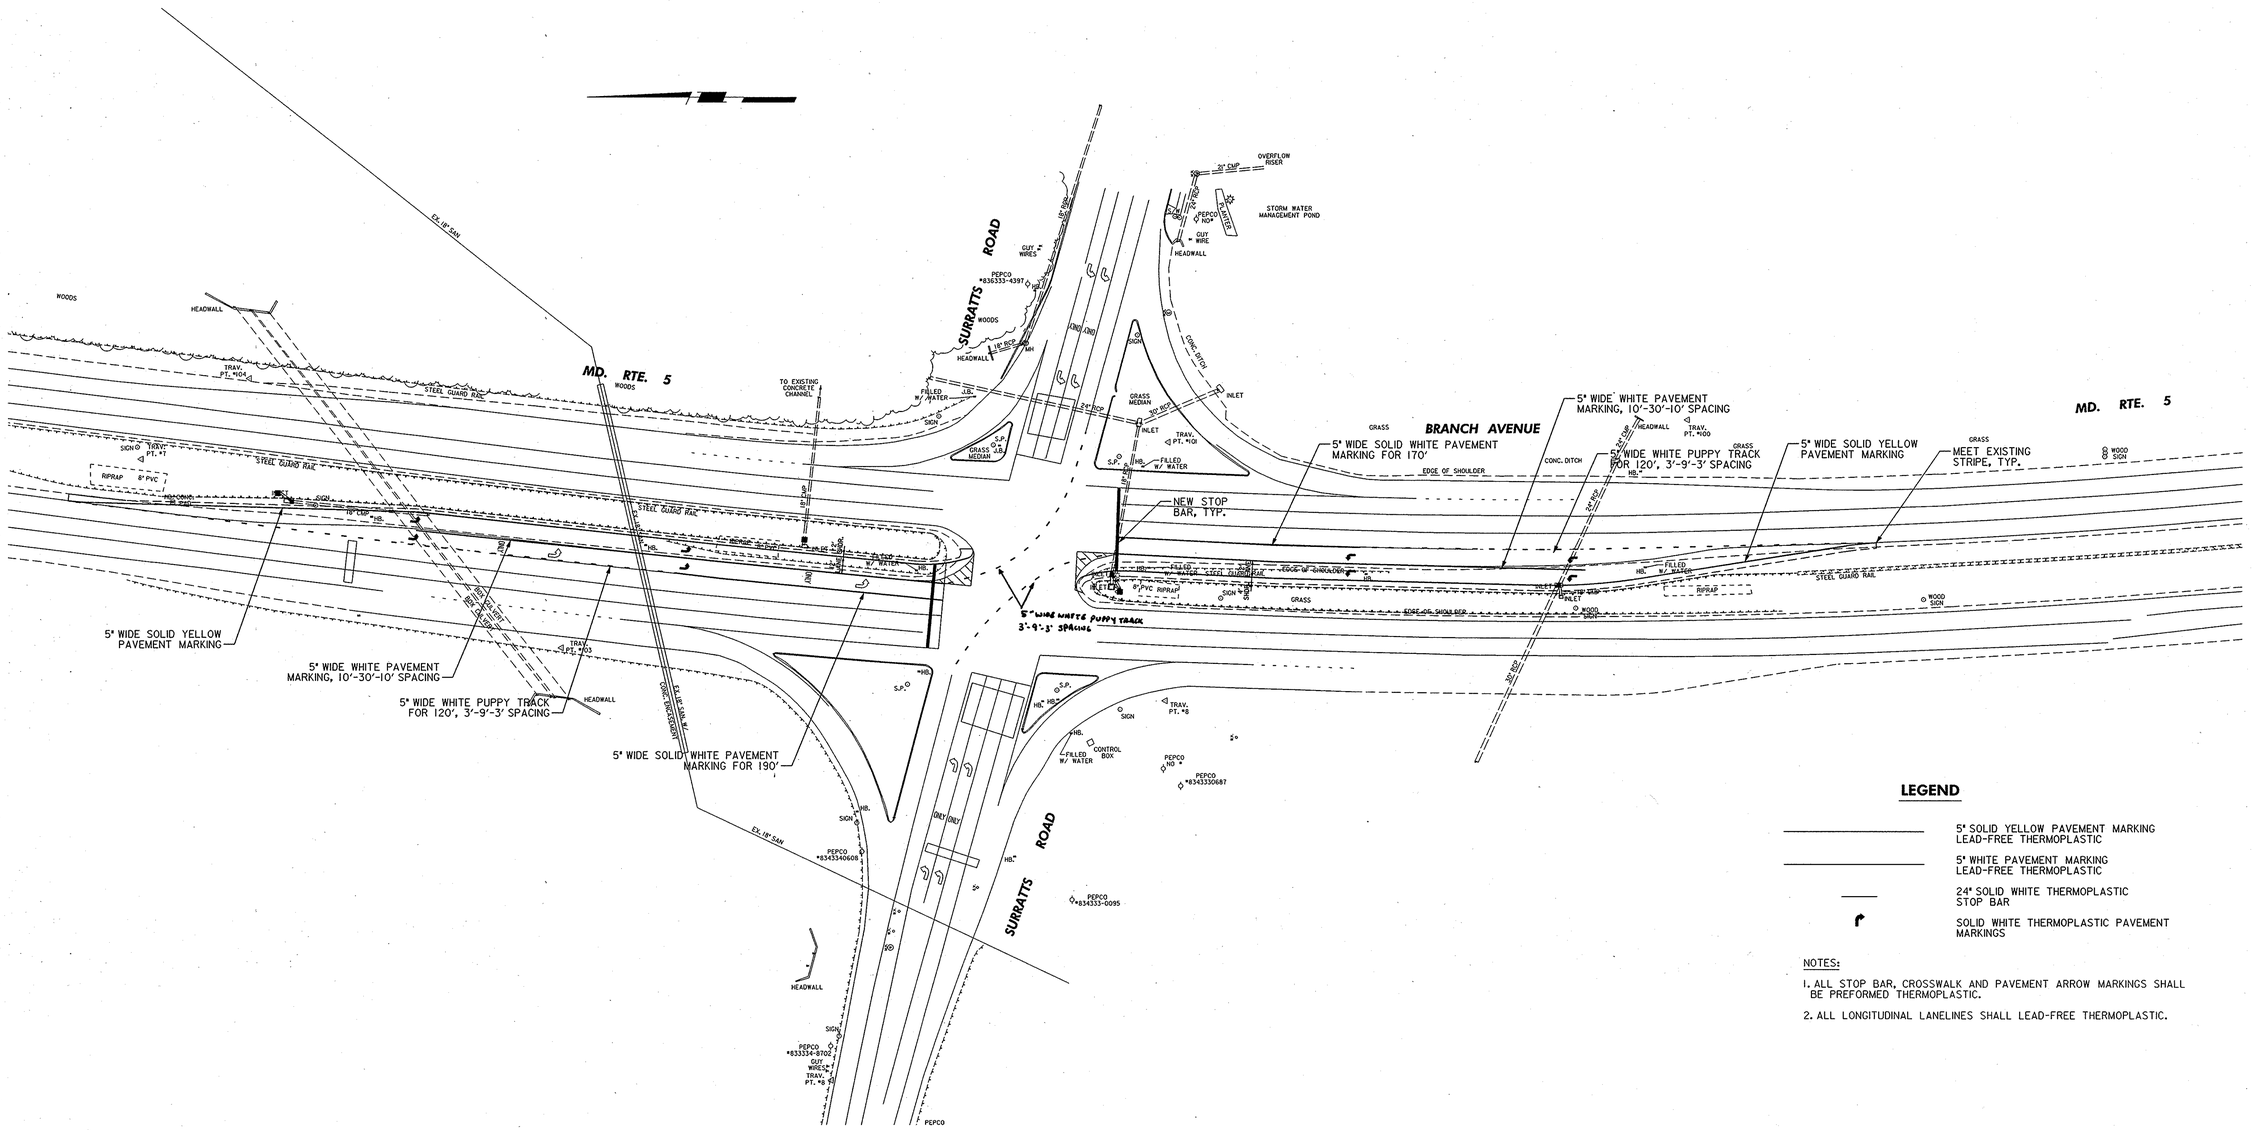

LEGEND

- 5" SOLID YELLOW PAVEMENT MARKING LEAD-FREE THERMOPLASTIC
- 5" WHITE PAVEMENT MARKING LEAD-FREE THERMOPLASTIC
- 24" SOLID WHITE THERMOPLASTIC STOP BAR
- SOLID WHITE THERMOPLASTIC PAVEMENT MARKINGS

NOTES:

1. ALL STOP BAR, CROSSWALK AND PAVEMENT ARROW MARKINGS SHALL BE PREFORMED THERMOPLASTIC.
2. ALL LONGITUDINAL LANELINES SHALL LEAD-FREE THERMOPLASTIC.

REVISIONS

APPROVALS

Amy K. Beall 9/14/05
TEAM LEADER, TRAFFIC ENGINEERING DESIGN DIVISION

Amy K. Beall for 9/14/05
ASST. CHIEF, TRAFFIC ENGINEERING DESIGN DIVISION

9/14/05
CHIEF, TRAFFIC ENGINEERING DESIGN DIVISION

DIRECTOR, OFFICE OF TRAFFIC & SAFETY

GPI
GREENMAN-PEDERSEN, INC.
ENGINEERS, ARCHITECTS, PLANNERS, CONSTRUCTION ENGINEERS & INSPECTORS
10620 GUILFORD ROAD, SUITE 100, JESSUP, MD. 20794
WASH. (301) 470-2772 BALT. (410) 880-3055
FAX: (301) 490-2649 www.gpinet.com

MARYLAND DOT - STATE HIGHWAY ADMINISTRATION
Office of Traffic & Safety
TRAFFIC ENGINEERING DESIGN DIVISION
MD 5 @ SURRATTS RD
PAVEMENT MARKING PLAN

DRAWN BY:	W.K.T.	F.A.P. NO.		TS NO.	SHEET NO.
CHECKED BY:	W.R.F.	S.H.A. NO.	BW996M82		
SCALE:	1" = 50'	COUNTY:	PRINCE GEORGES	T.I.M.S. NO.	
DATE:	SEPTEMBER, 2005	LOG MILE:	16000506.57	H 164	11 OF 13