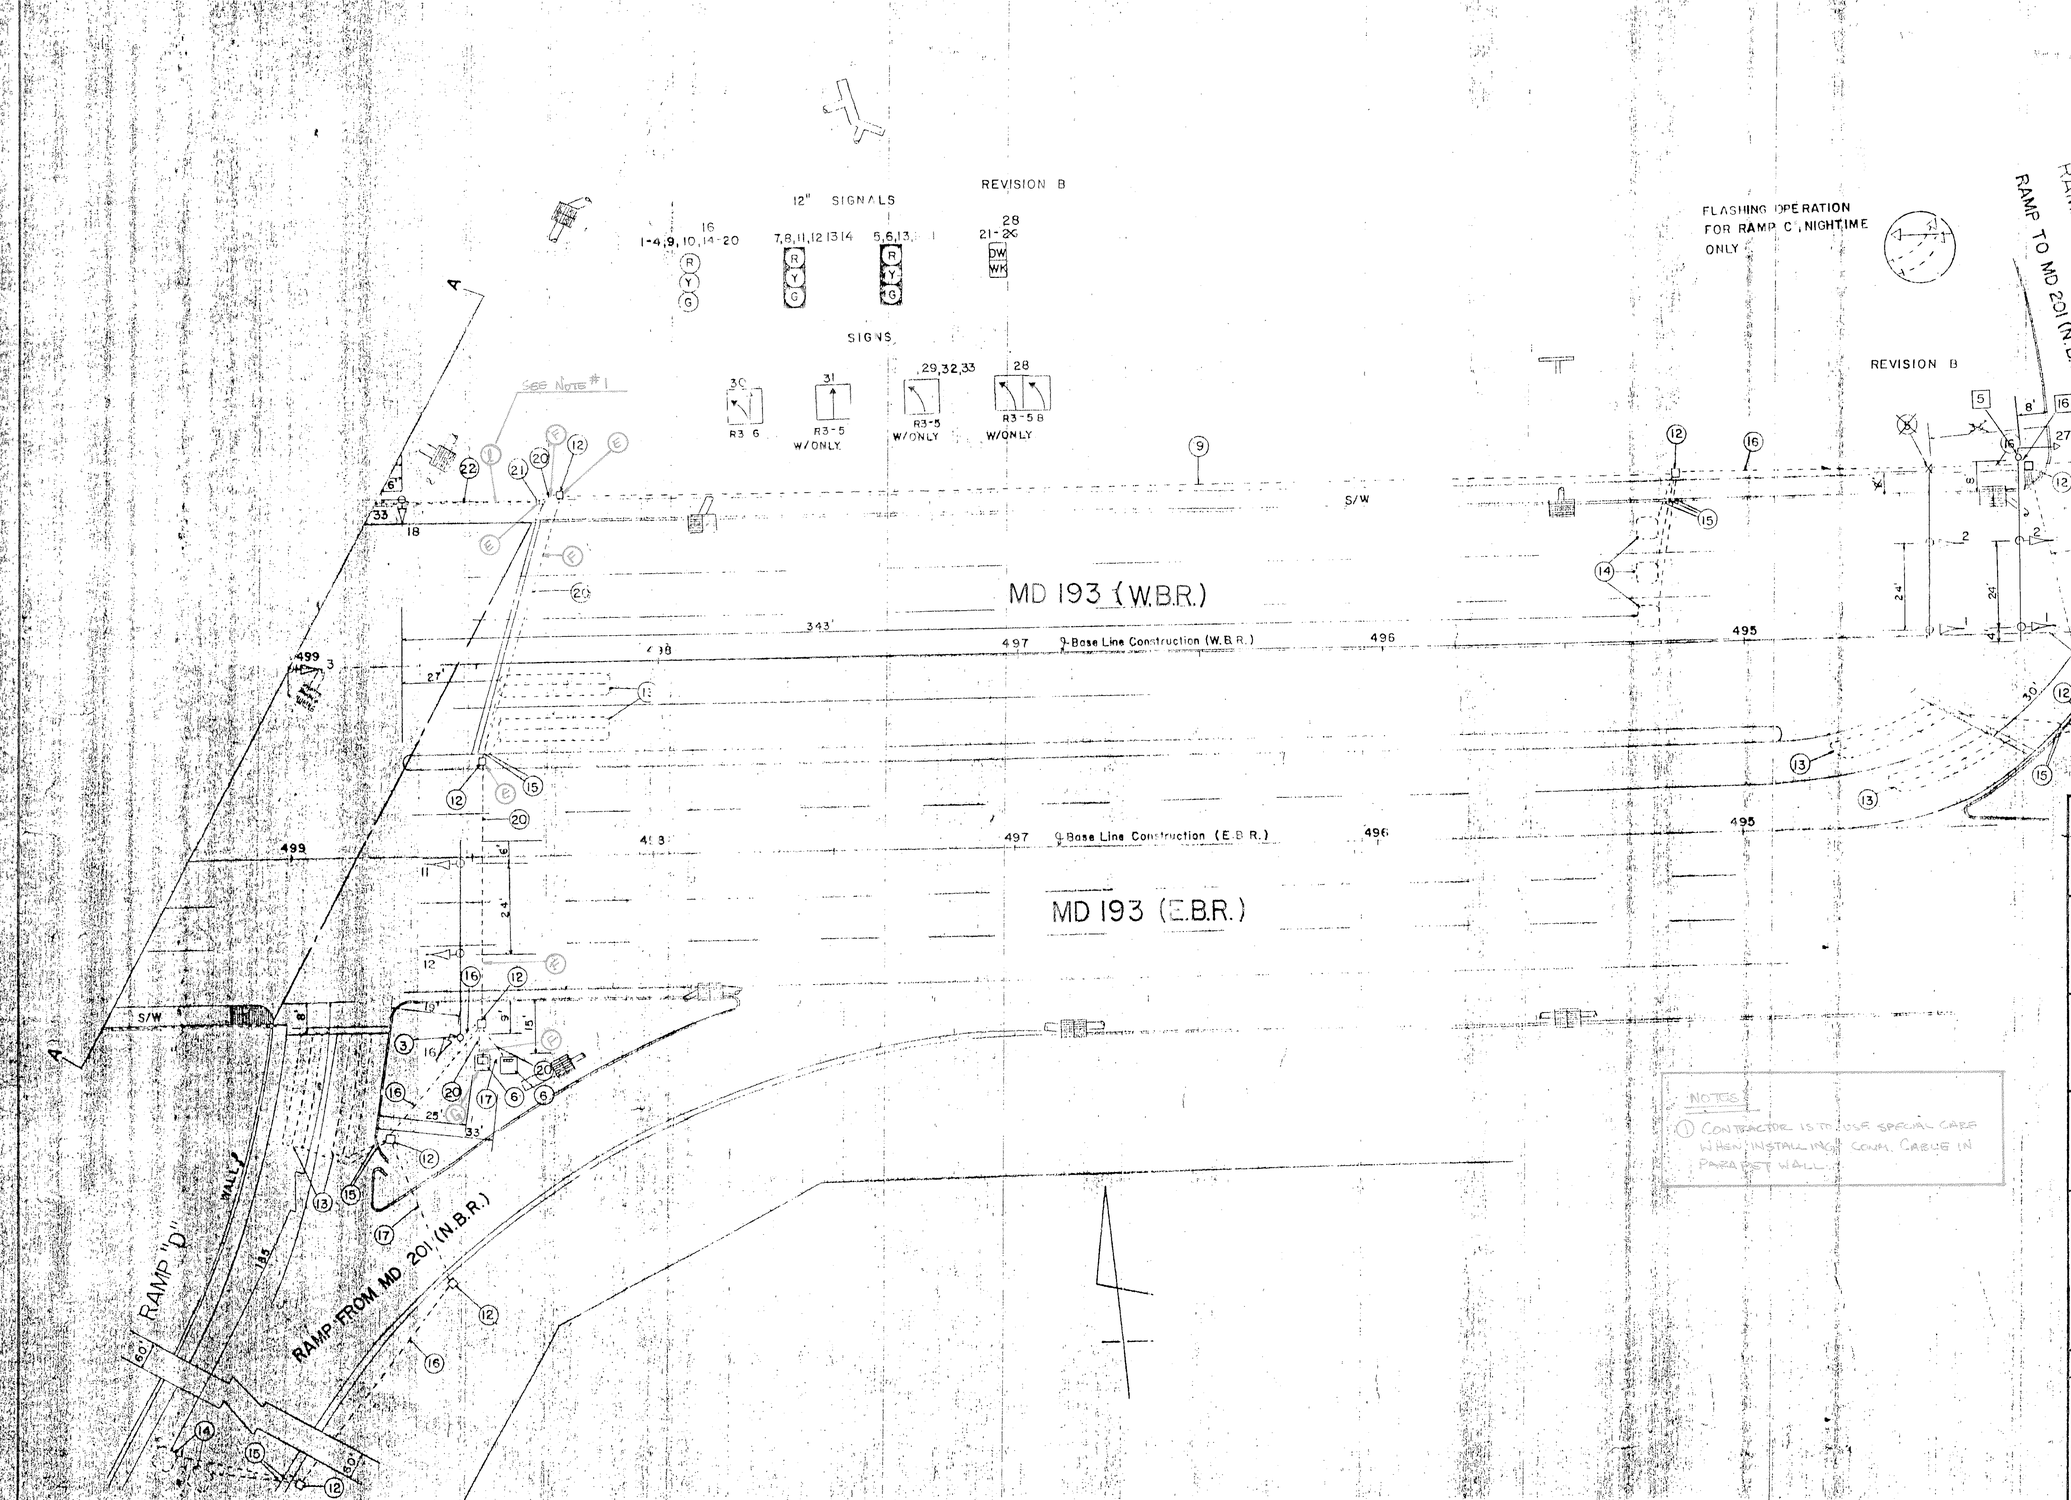

APPROVAL: CHIEF SIGNAL DESIGN SECTION

APPROVAL: DISTRICT TRAFFIC ENGINEER

APPROVAL: CHIEF BUREAU OF TRAFFIC ENGINEERING

APPROVAL: DEPUTY CHIEF ENGINEER TRAFFIC

B 5-6-87 ADD PED. SIGNALS & REVISE MAST ARM '5'

WJR

REVISIONS

STATE OF MARYLAND
DEPARTMENT OF TRANSPORTATION
STATE HIGHWAY ADMINISTRATION

OFFICE OF TRAFFIC — BUREAU OF TRAFFIC ENGINEERING

MD. 193 and MD 201 (Interchange)

SCALE 1" = 20' | DATE 1/30/84 | CONTRACT NO. P474-501-37

DRAWN BY: D. L. A. | COUNTY: PRINCE GEORGE'S

DESIGNED BY: | SIGNAL NO.:

CHECKED BY:

DRAWING NO. TS-193 XIB

16019305.883