| F H WA REGION NO | STATE | FED. AID PROJ. NO | SHEET NO. | TOTAL SHEETS |
|---|---|---|---|---|
| NC | MD. | BW 1D15 | | |

SIGNALS

9,10,13 14,16,17 — 12"

11,12 — 12"

SIGNS

20,23 — ONLY ONLY — R3-5b(L) 36"x 60"

21,22 — ONLY — R3-5R 30"x 36"

NOTE: SEE DRAWING NO TS-1796B FOR SIGNAL PHASING.

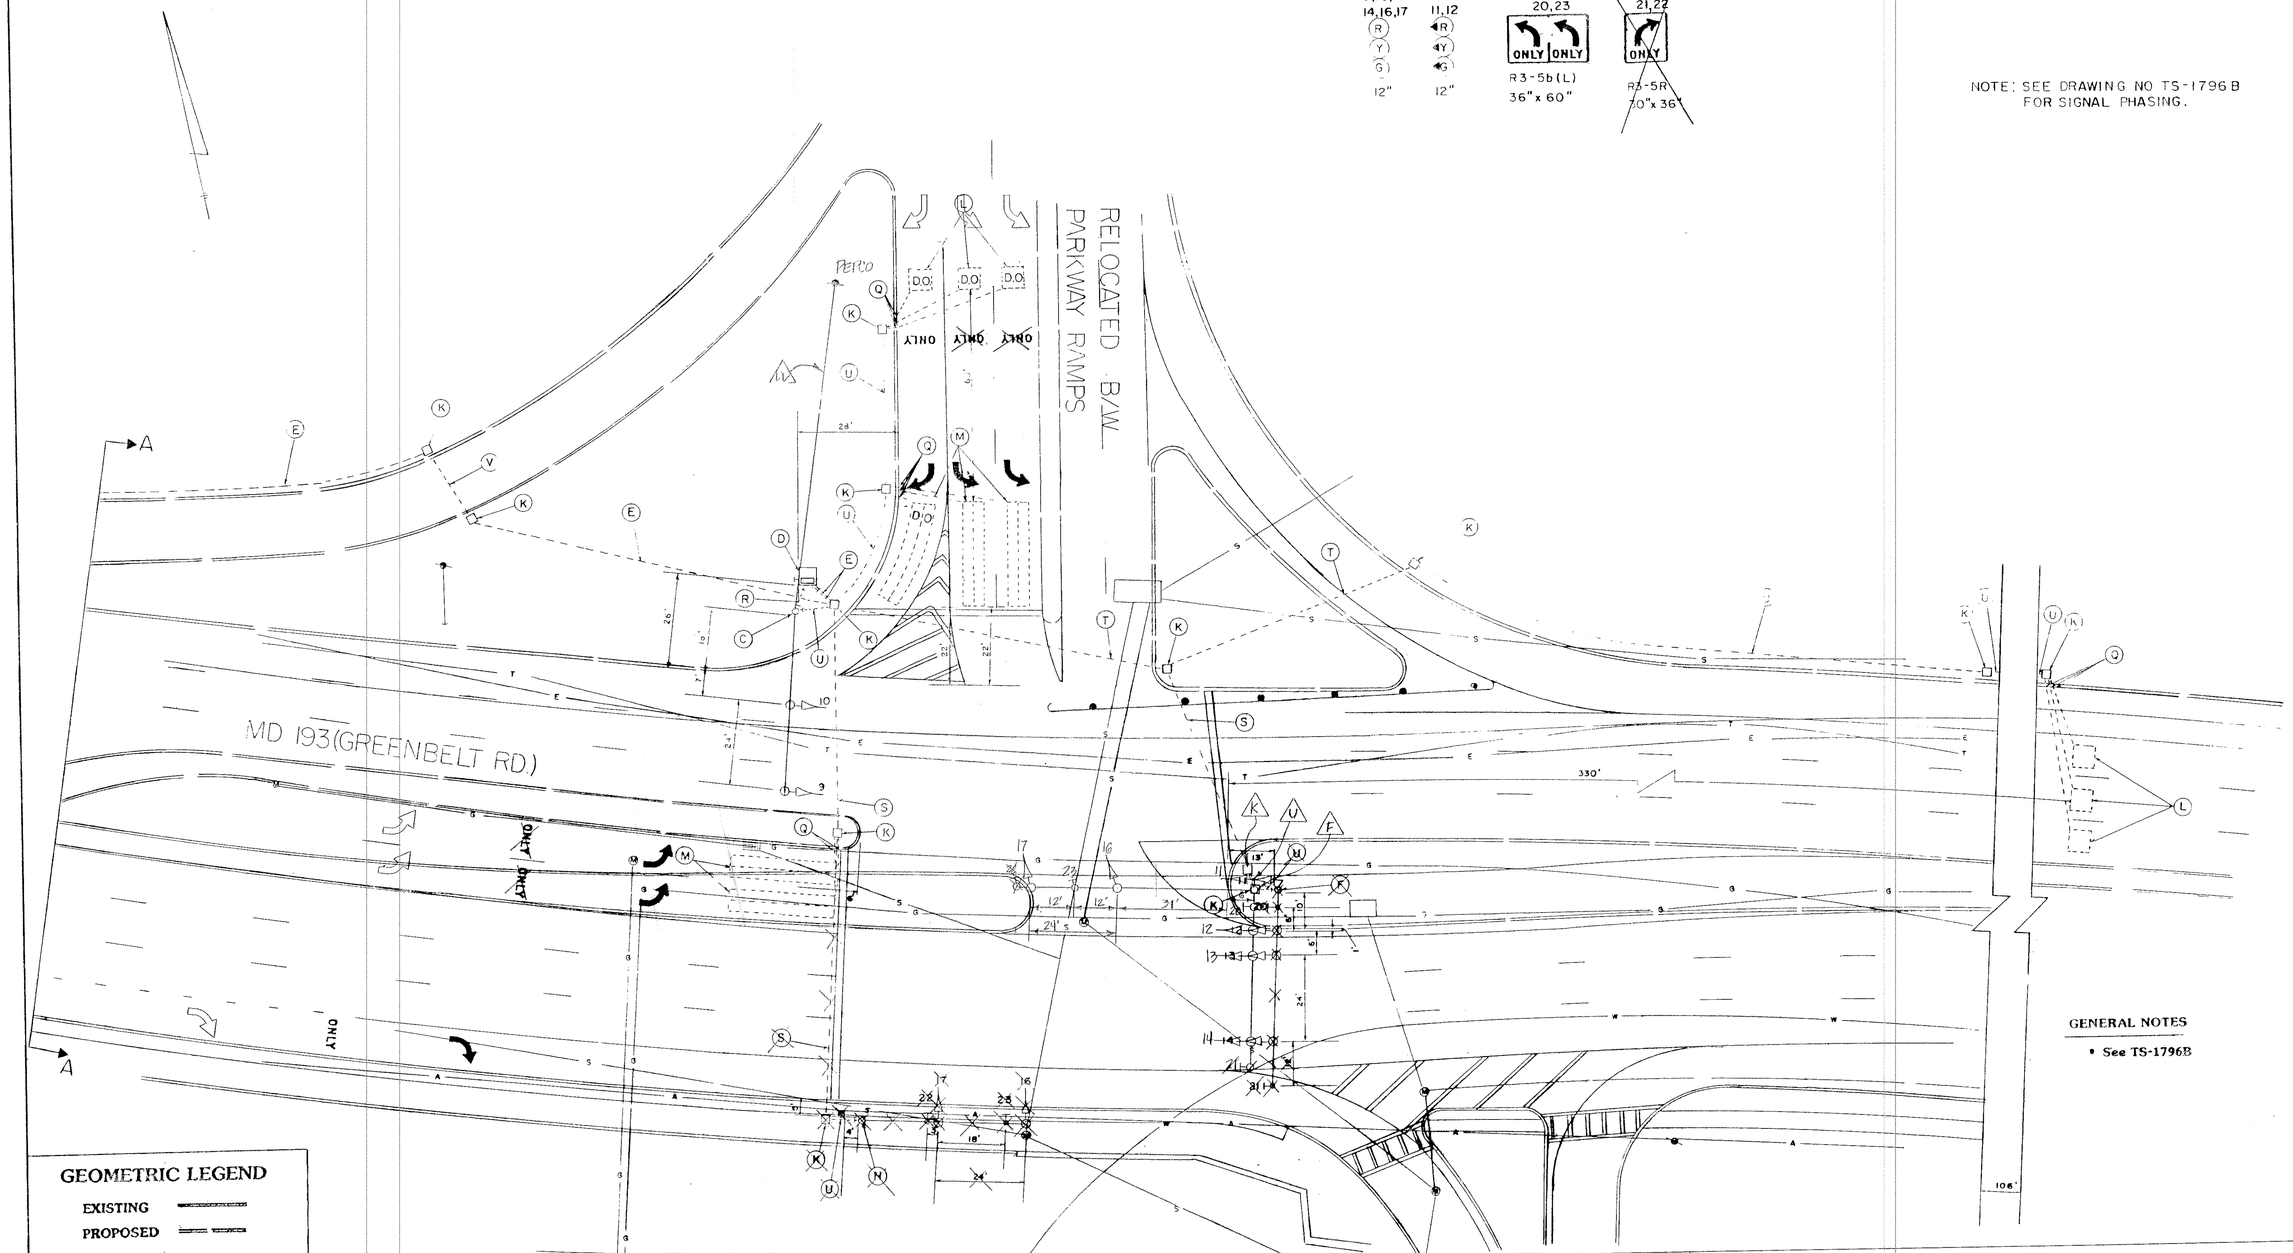


GENERAL NOTES

• See TS-1796B

GEOMETRIC LEGEND

EXISTING

PROPOSED

LEGEND OF UNDERGROUND AND OVERHEAD UTILITIES

AERIAL CABLE — A — A — A — A

ELECTRIC — E — E — E — E

TELEPHONE — T — T — T — T

GAS — G — G — G — G

SEWER — S — S — S — S

WATER — W — W — W — W

CABLE TV — TV — TV — TV — TV

THE TRAFFIC GROUP, INC.
414 East Joppa Road
Towson, Maryland 21204
Telephone 301-583-8405

REVISIONS

4-21-92 RED LINE REVISION TO RELOCATE MAST ARM POLES

APPROVALS

CHIEF, SIGNAL DESIGN SECTION

ASST. DISTRICT ENGINEER, TRAFFIC 11/1/88

CHIEF, BUREAU OF TRAFFIC ENGINEERING 10-28-88

DEPUTY CHIEF ENGINEER, OFFICE OF TRAFFIC 11/29/88

MARYLAND DEPARTMENT OF TRANSPORTATION
STATE HIGHWAY ADMINISTRATION – OFFICE OF TRAFFIC
BUREAU OF TRAFFIC ENGINEERING

DRAWN BY J.BOLING

DES. BY: J.BOLING

CHK. BY: 11/27/88

DATE: MAY 18, 1988

SCALE: 1"=20'

F.A.P. NO.

S.H.A. NO. BW 379-802-312

MD 193(GREENBELT ROAD) & RELOCATED B/W RAMPS

COUNTY: PRINCES GEORGES

TS/FILE NO. 2486A

SHEET NO. 2 OF 6

160 193 06.91