| FHWA REGION NO. | STATE | FED. AID PROJ. NO. | SHEET NO. | TOTAL SHEETS |
|---|---|---|---|---|
| 3 | MD | | | |

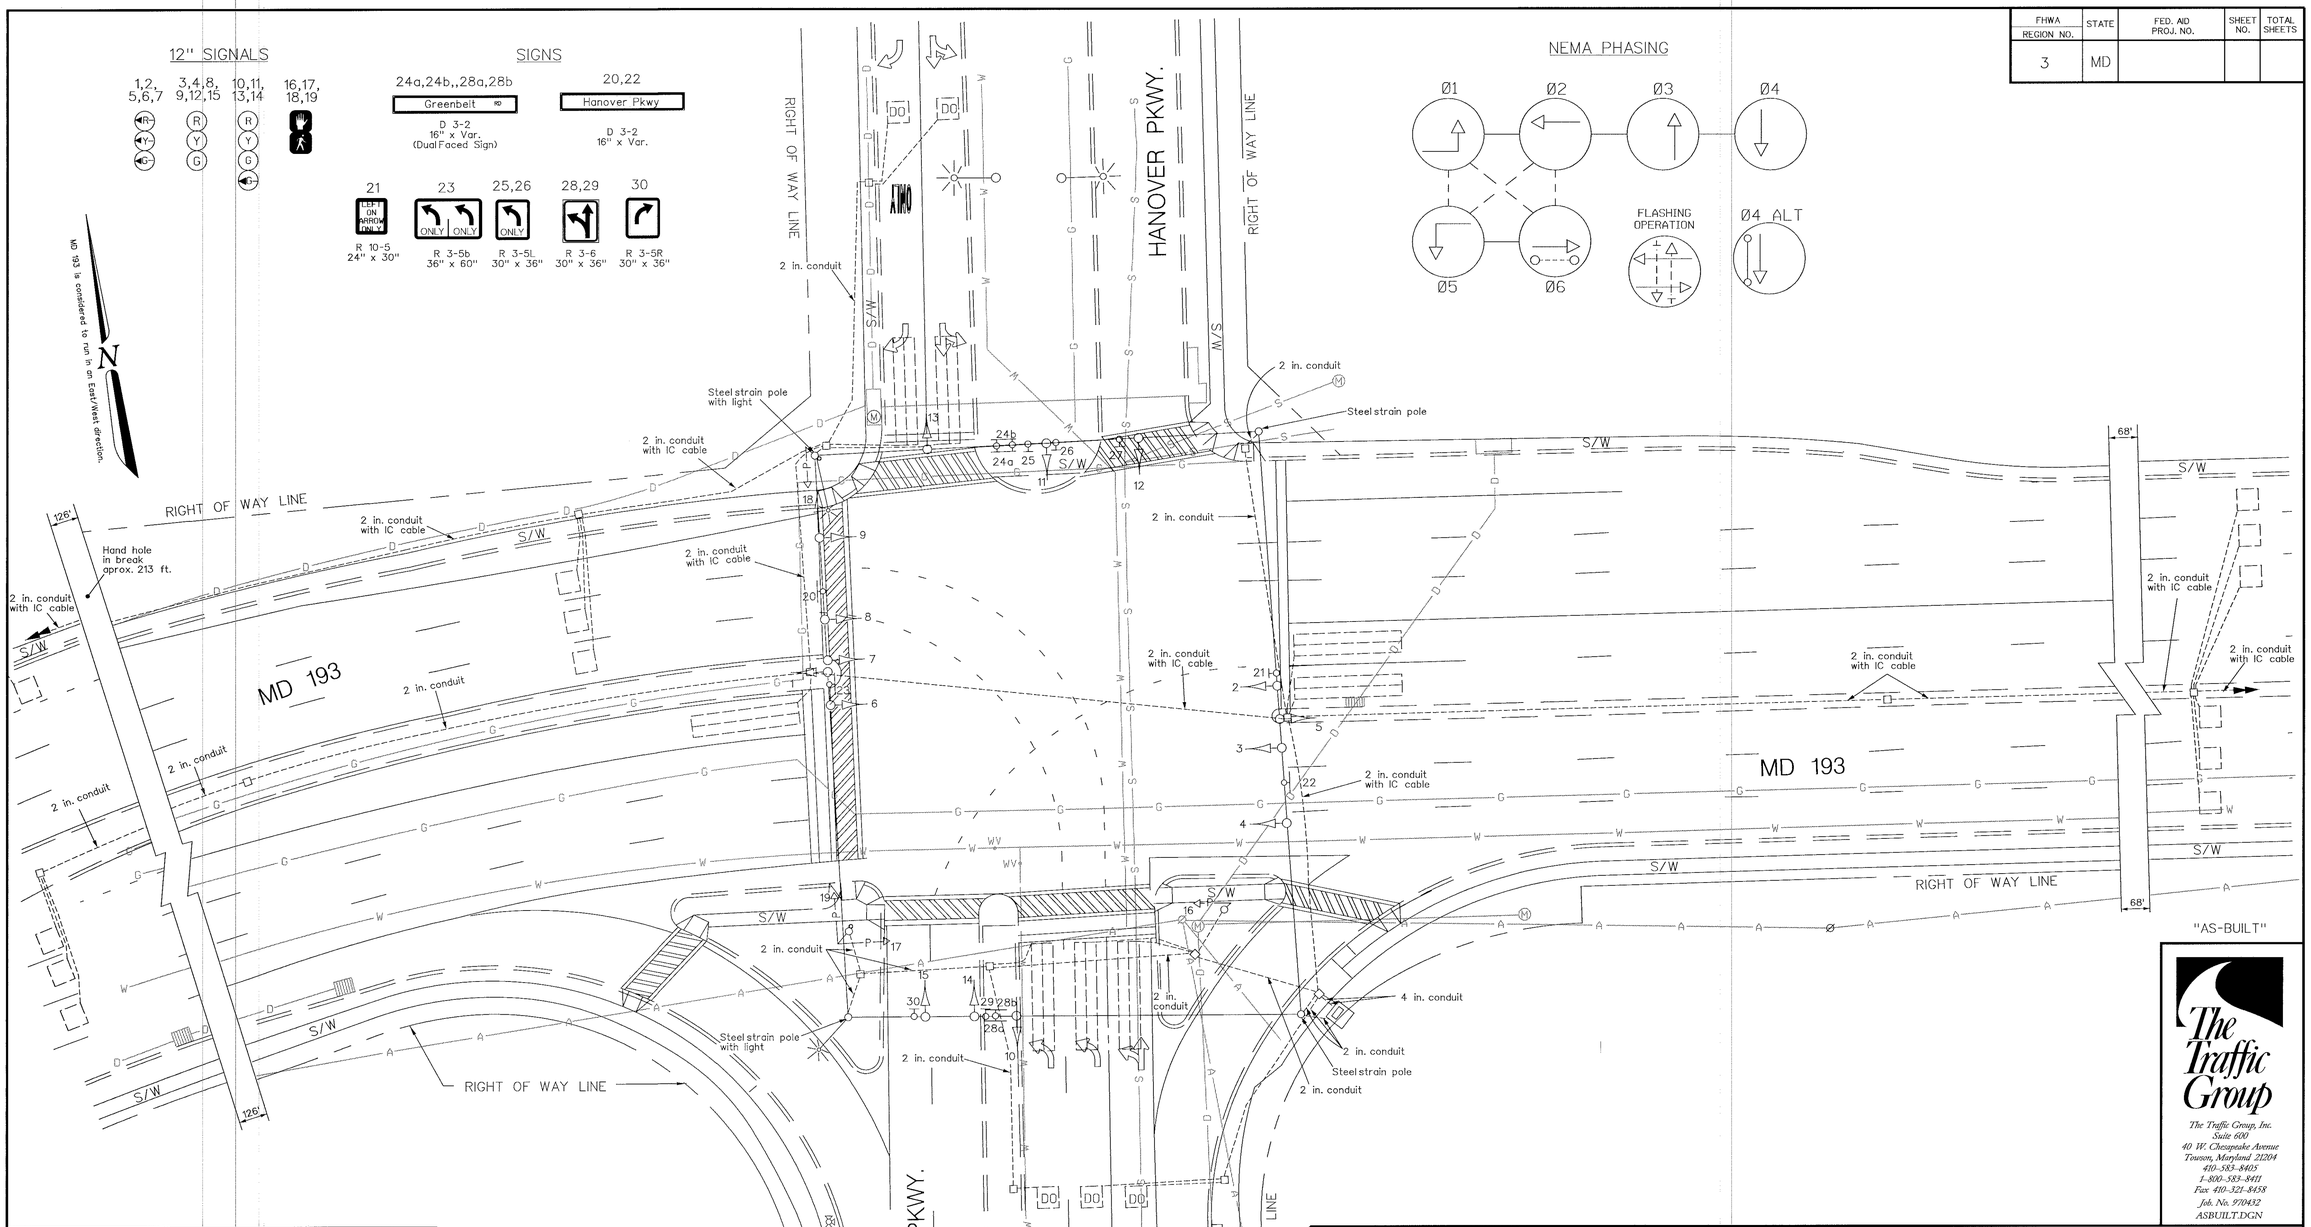


"AS-BUILT"

The Traffic Group

The Traffic Group, Inc.
Suite 600
40 W. Chesapeake Avenue
Towson, Maryland 21204
410-583-8405
1-800-583-8411
Fax 410-321-8458
Job. No. 970432
ASBUILT.DGN

GEOMETRIC LEGEND

EXISTING GEOMETRICS
PROPOSED GEOMETRICS

UTILITY LEGEND

GAS MAIN
WATER MAIN
SEWER MAIN
ELECTRIC CABLES
STORM DRAIN
AERIAL CABLES
TELEPHONE CABLES

REVISIONS

© ASBUILT Oct. 24, 1997
S.H.A. No.: BW-263-802-312
FJH

APPROVALS

ASST. DIVISION CHIEF TRAFFIC ENGINEERING DESIGN DIVISION
CHIEF, TRAFFIC ENGINEERING DESIGN DIVISION
ASST. DISTRICT ENGINEER - TRAFFIC
DIRECTOR, OFFICE OF TRAFFIC & SAFETY

ORIGINAL ON FILE

MDOT – STATE HIGHWAY ADMINISTRATION
*Office of Traffic & Safety*
TRAFFIC ENGINEERING DESIGN DIVISION

DRAWN BY: A.B.S.
DES. BY: J.D.S.
CHK. BY: D.G.M.

(Traffic Signal Plan)

# *MD 193 at Hanover Parkway*

COUNTY: PRINCE GEORGE'S
LOG MILE • 16019307.29

DATE: October, 1990
SCALE: 1" = 20'
F.A.P. NO. N/A
S.H.A. NO. BW-263-802-312
TS/STD. NO. *1797-G*
SHEET NO. 1 of 1