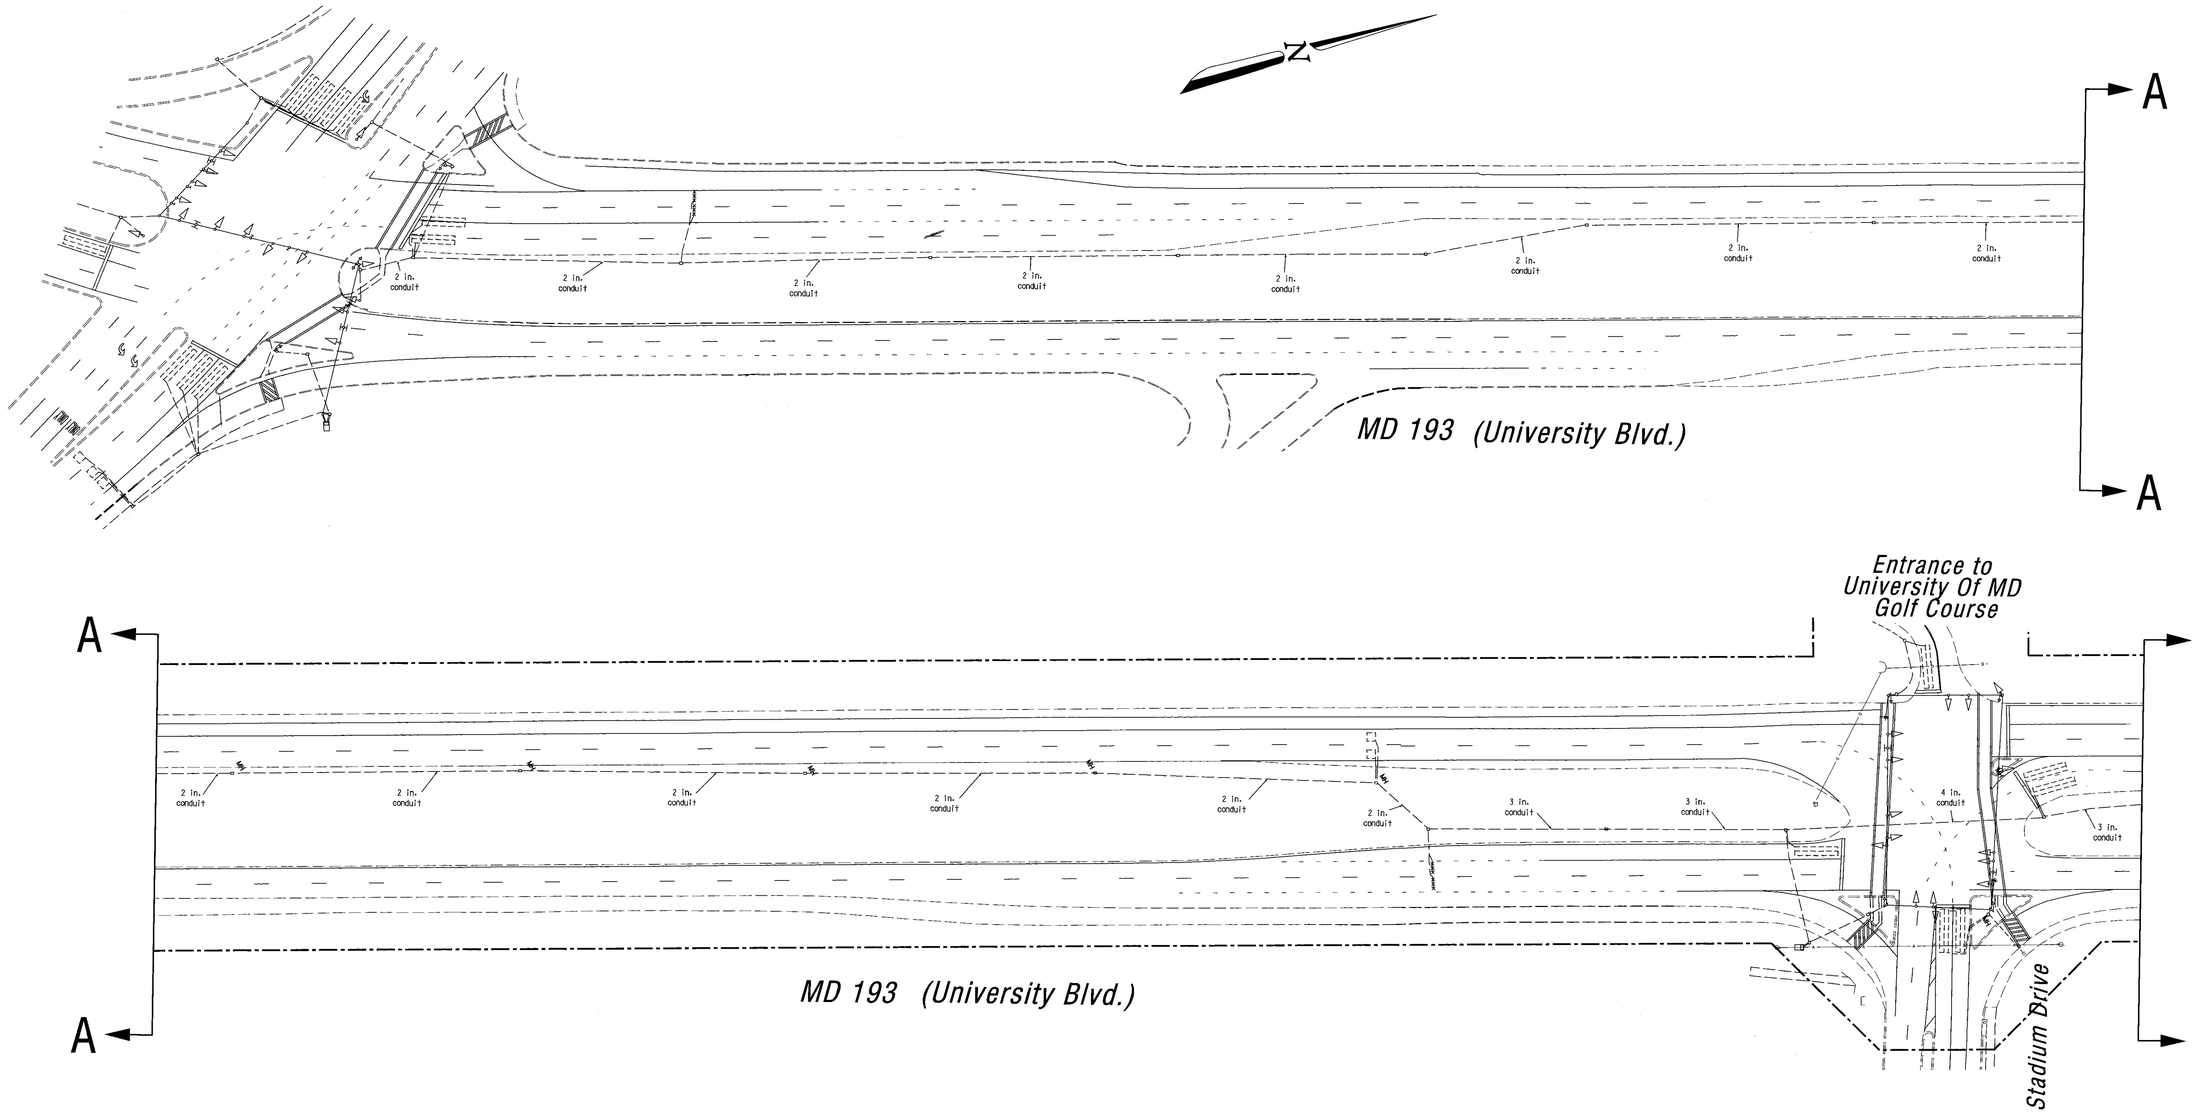

GEOMETRIC LEGEND

EXISTING GEOMETRICS

PROPOSED GEOMETRICS

UTILITY LEGEND

G	GAS MAIN
W	WATER MAIN
S	SEWER MAIN
E	ELECTRIC CABLES
D	STORM DRAIN
A	AERIAL CABLES
T	TELEPHONE CABLES

"As Built"

The Traffic Group

The Traffic Group, Inc.
410-931-6600
Fax 410-931-6601

REVISIONS

As Built
S.H.A. No. EW996M82
September 23, 2002
md

APPROVALS

TEAM LEADER, TRAFFIC ENGINEERING DESIGN DIVISION

ASST. CHIEF TRAFFIC ENGINEERING DESIGN DIVISION

CHIEF, TRAFFIC ENGINEERING DESIGN DIVISION

DIRECTOR, TRAFFIC & SAFETY

MARYLAND DOT - STATE HIGHWAY ADMINISTRATION
Office of Traffic & Safety
TRAFFIC ENGINEERING DESIGN DIVISION
(Interconnect Plan)

MD 193 from Adelphi Rd to Metzerott Rd/Paint Branch Dr.

DRAWN BY:	Frank Hoeckel	F.A.P. NO.	N/A	TS NO.	SHEET NO.
CHECKED BY:		S.H.A. NO.			
SCALE:	1" = 50'	COUNTY:	Prince George's	T.I.M.S. NO. E-758	1 OF 3
DATE:	August 23, 2001	LOG MILE:			

f:\1998\98110\DES\asbuilt-tc.dgn 9/27/2002