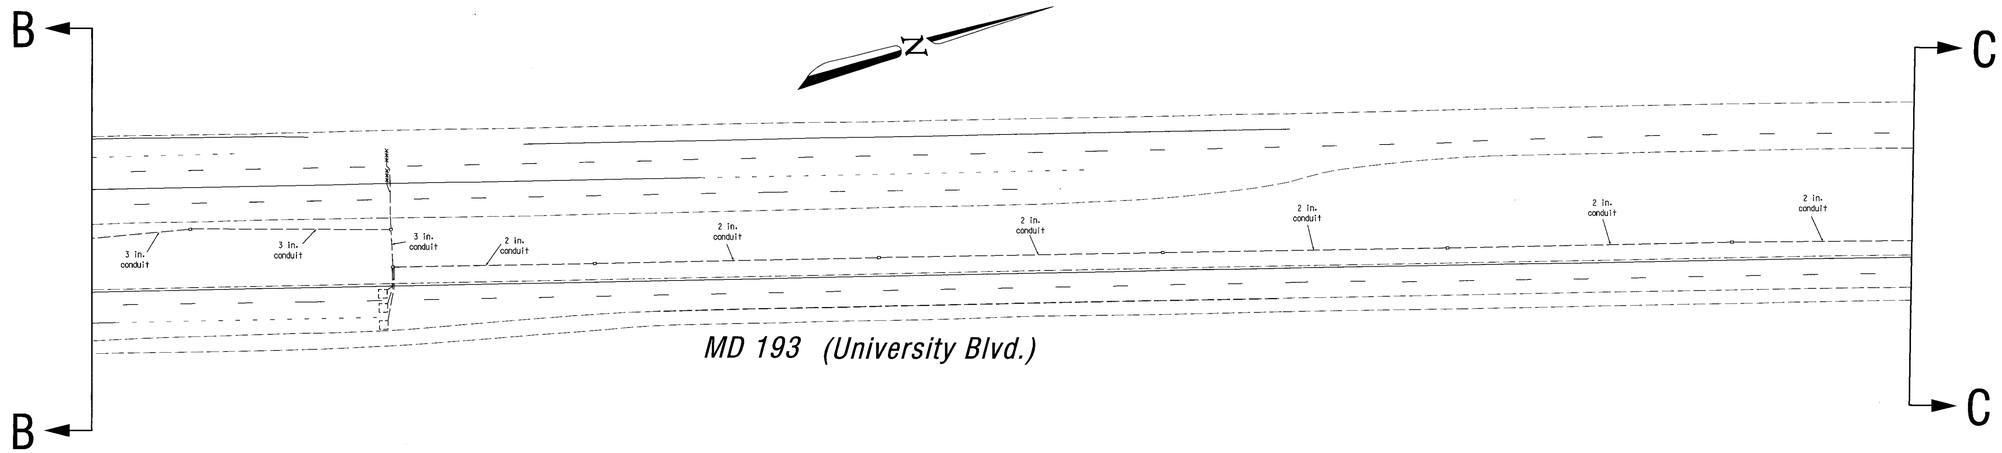

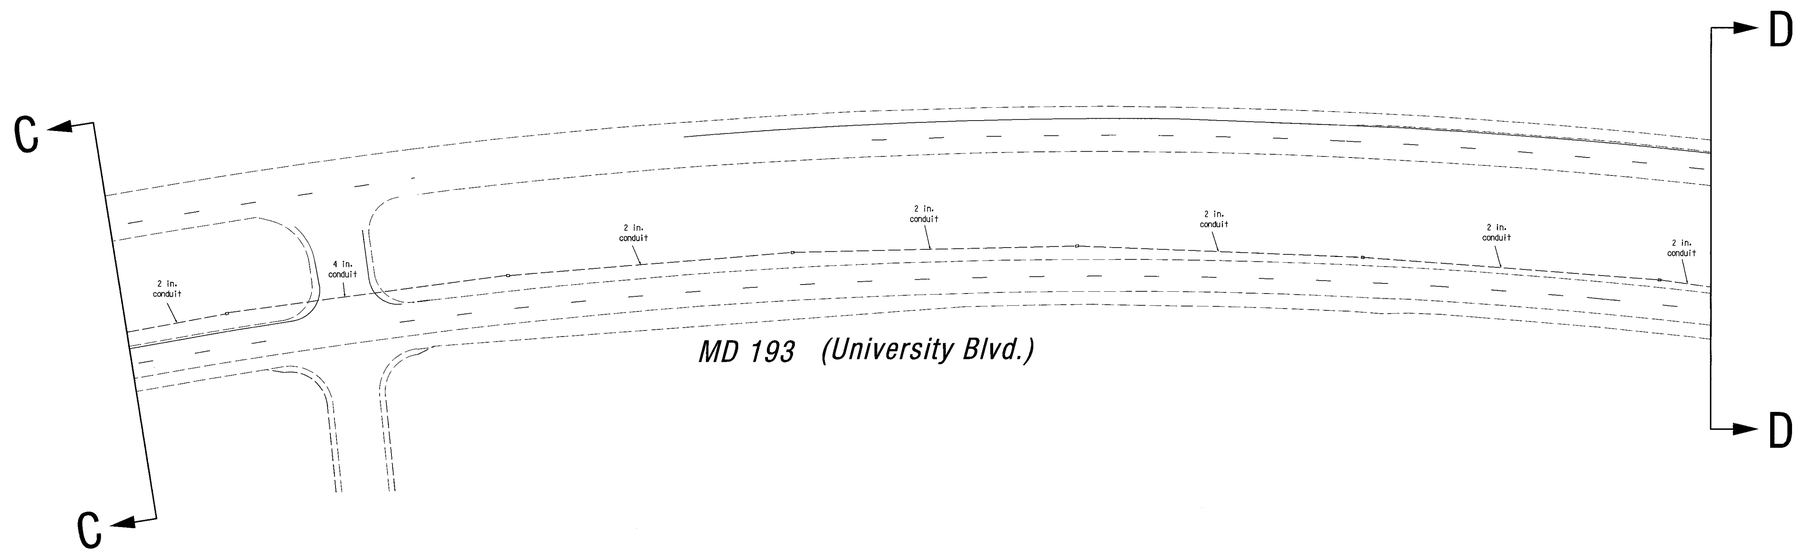

GEOMETRIC LEGEND

EXISTING GEOMETRICS
PROPOSED GEOMETRICS

UTILITY LEGEND

G	GAS MAIN
W	WATER MAIN
S	SEWER MAIN
E	ELECTRIC CABLES
D	STORM DRAIN
A	AERIAL CABLES
T	TELEPHONE CABLES

"As Built"

The Traffic Group

The Traffic Group, Inc.
410-931-6600
Fax 410-931-6601

REVISIONS

September 23, 2002
As Built
S.H.A. No.:BW996M82
mnd

APPROVALS

TEAM LEADER, TRAFFIC ENGINEERING DESIGN DIVISION

ASST. CHIEF TRAFFIC ENGINEERING DESIGN DIVISION

CHIEF, TRAFFIC ENGINEERING DESIGN DIVISION

DIRECTOR, TRAFFIC & SAFETY

MARYLAND DOT - STATE HIGHWAY ADMINISTRATION
Office of Traffic & Safety
TRAFFIC ENGINEERING DESIGN DIVISION
(Interconnect Plan)

MD 193 from Adelphi Rd to Metzerott Rd/Paint Branch Dr.

DRAWN BY:	Frank Hoeckel	F.A.P. NO.	N/A	TS NO.	SHEET NO.
CHECKED BY:		S.H.A. NO.			
SCALE:	1" = 50'	COUNTY:	Prince George's	T.I.M.S. NO.	
DATE:	August 23, 2001	LOG MILE:		E-758	2 OF 3

f:\1998\98101\DES\asbuilt-ic.dgn 9/27/2002