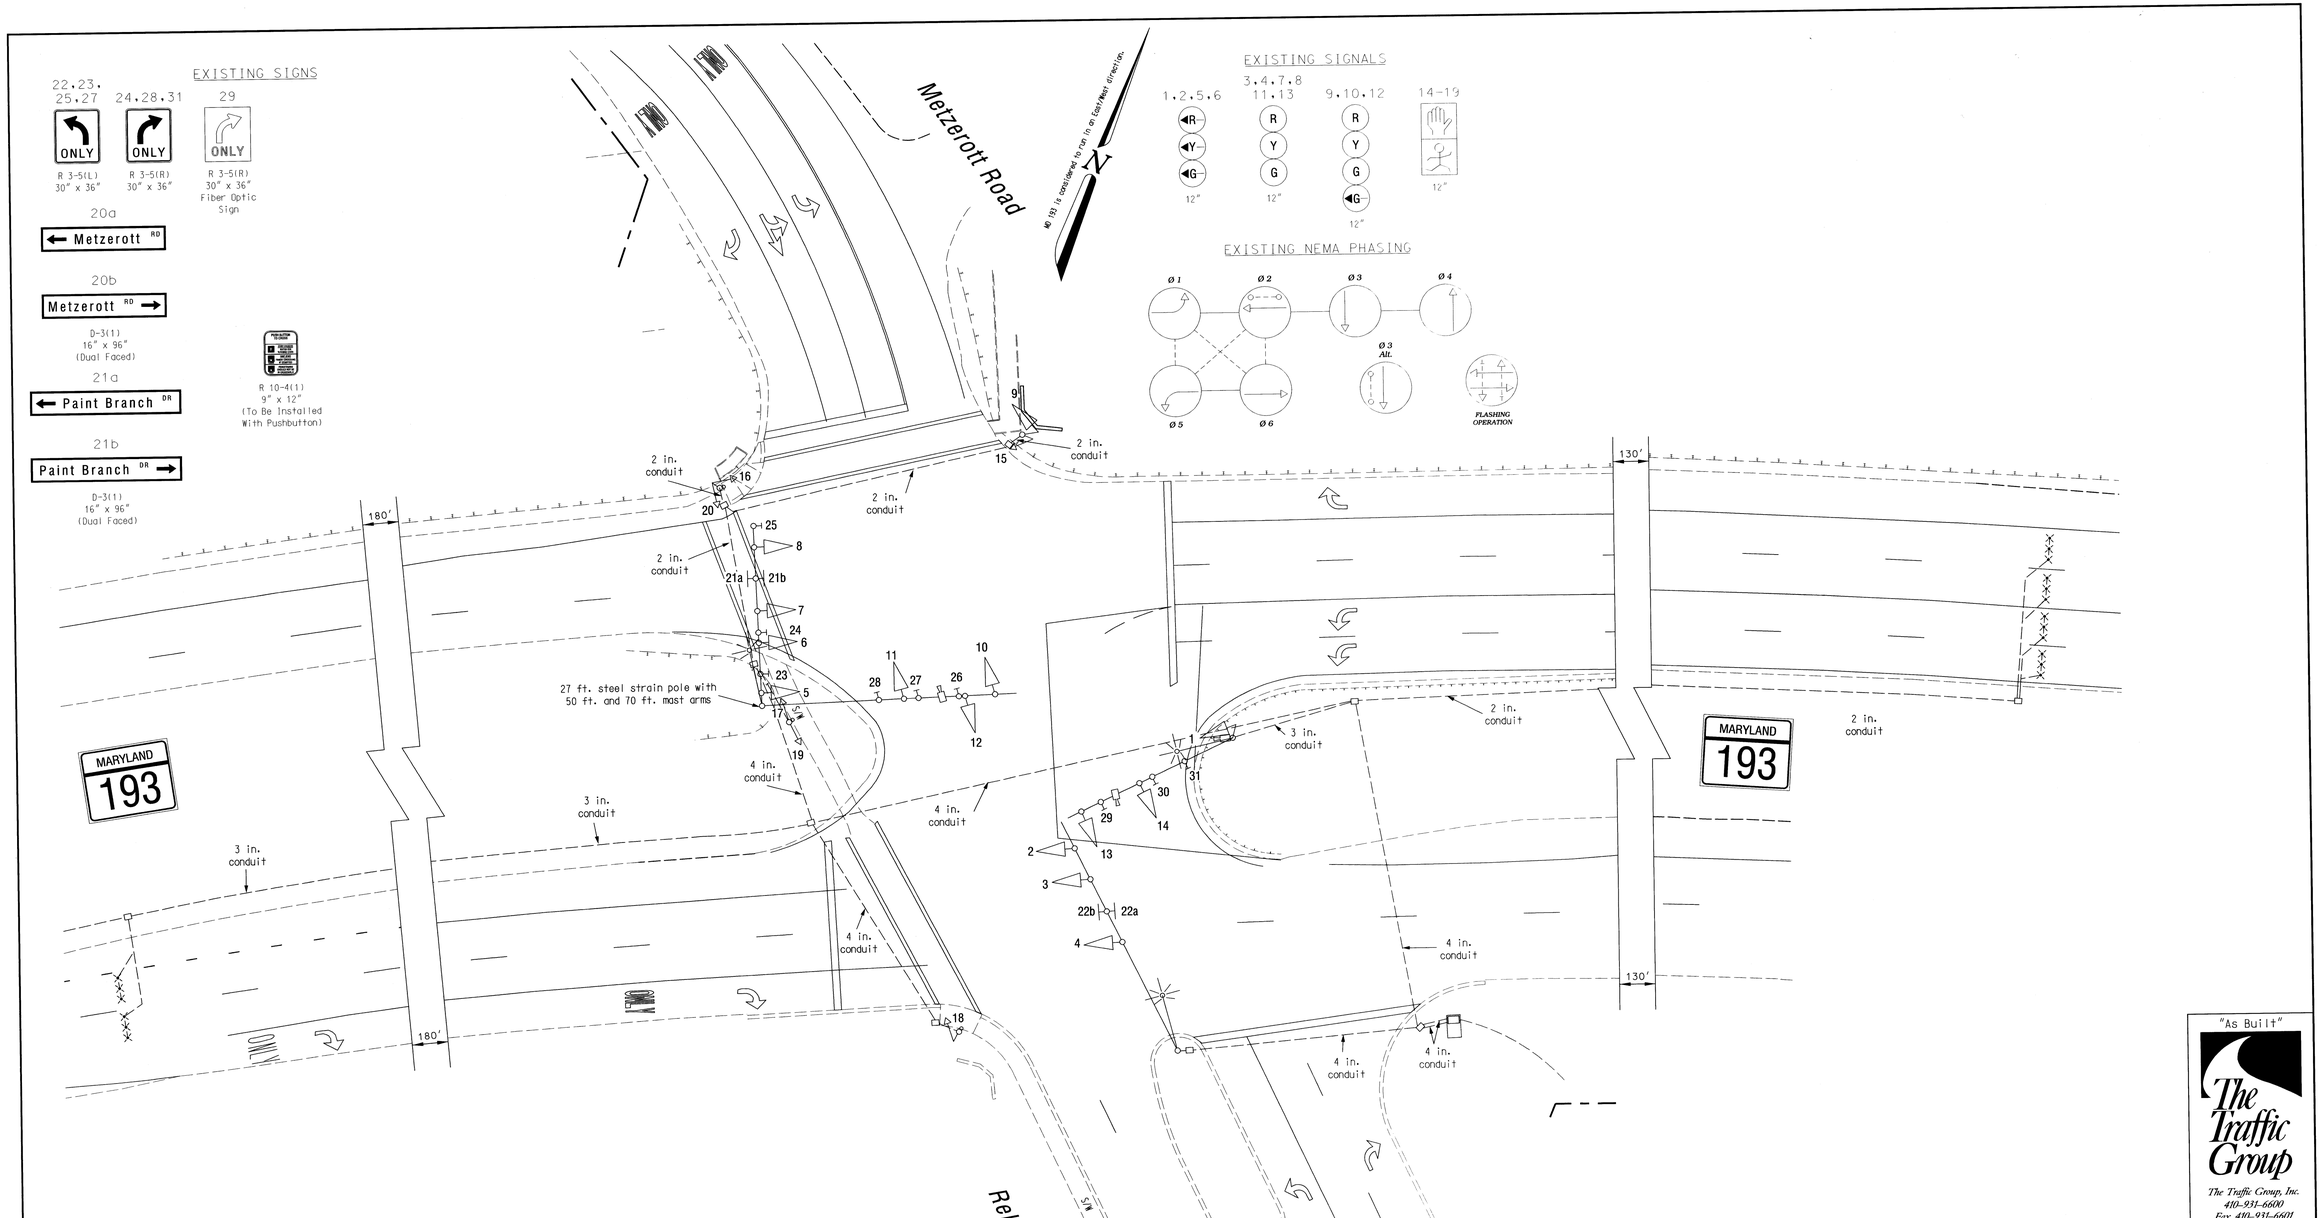

"As Built"

The Traffic Group

The Traffic Group, Inc.
410-931-6600
Fax 410-931-6601

GEOMETRIC LEGEND

EXISTING GEOMETRICS
PROPOSED GEOMETRICS

UTILITY LEGEND

GAS MAIN
WATER MAIN
SEWER MAIN
ELECTRIC CABLES
STORM DRAIN
AERIAL CABLES
TELEPHONE CABLES

REVISIONS

E FEBRUARY 5, 2001
REGENERATE FOR NEW GEOMETRICS

3.50/SH	J.R.H	MAR	DAZ	BRK	TH

(F) September 23, 2002
As Built
S.H.A. No.:BW996M82
rmd

APPROVALS

TEAM LEADER, TRAFFIC ENGINEERING DESIGN DIVISION
ASST. CHIEF TRAFFIC ENGINEERING DESIGN DIVISION
CHIEF, TRAFFIC ENGINEERING DESIGN DIVISION
DIRECTOR, TRAFFIC & SAFETY

ORIGINAL ON FILE

MARYLAND DOT - STATE HIGHWAY ADMINISTRATION
Office of Traffic & Safety
TRAFFIC ENGINEERING DESIGN DIVISION
(Traffic Signal Plan)

MD 193 at Metzerott Rd /Rel. Paint Branch Dr

DRAWN BY: H. Kilian	F.A.P. NO. N/A	TS NO. 1034-F	SHEET NO.
CHECKED BY: W. Fitch	S.H.A. NO. P-337-001-385	T.I.M.S. NO. XXX	1 OF 1
SCALE: 1" = 20'	COUNTY: Prince George's		
DATE: September 7, 1973	LOG MILE: ~~XXX~~ 16019303.44		

f:\1998\98101\DES\asbuilt.dgn 9/27/2002