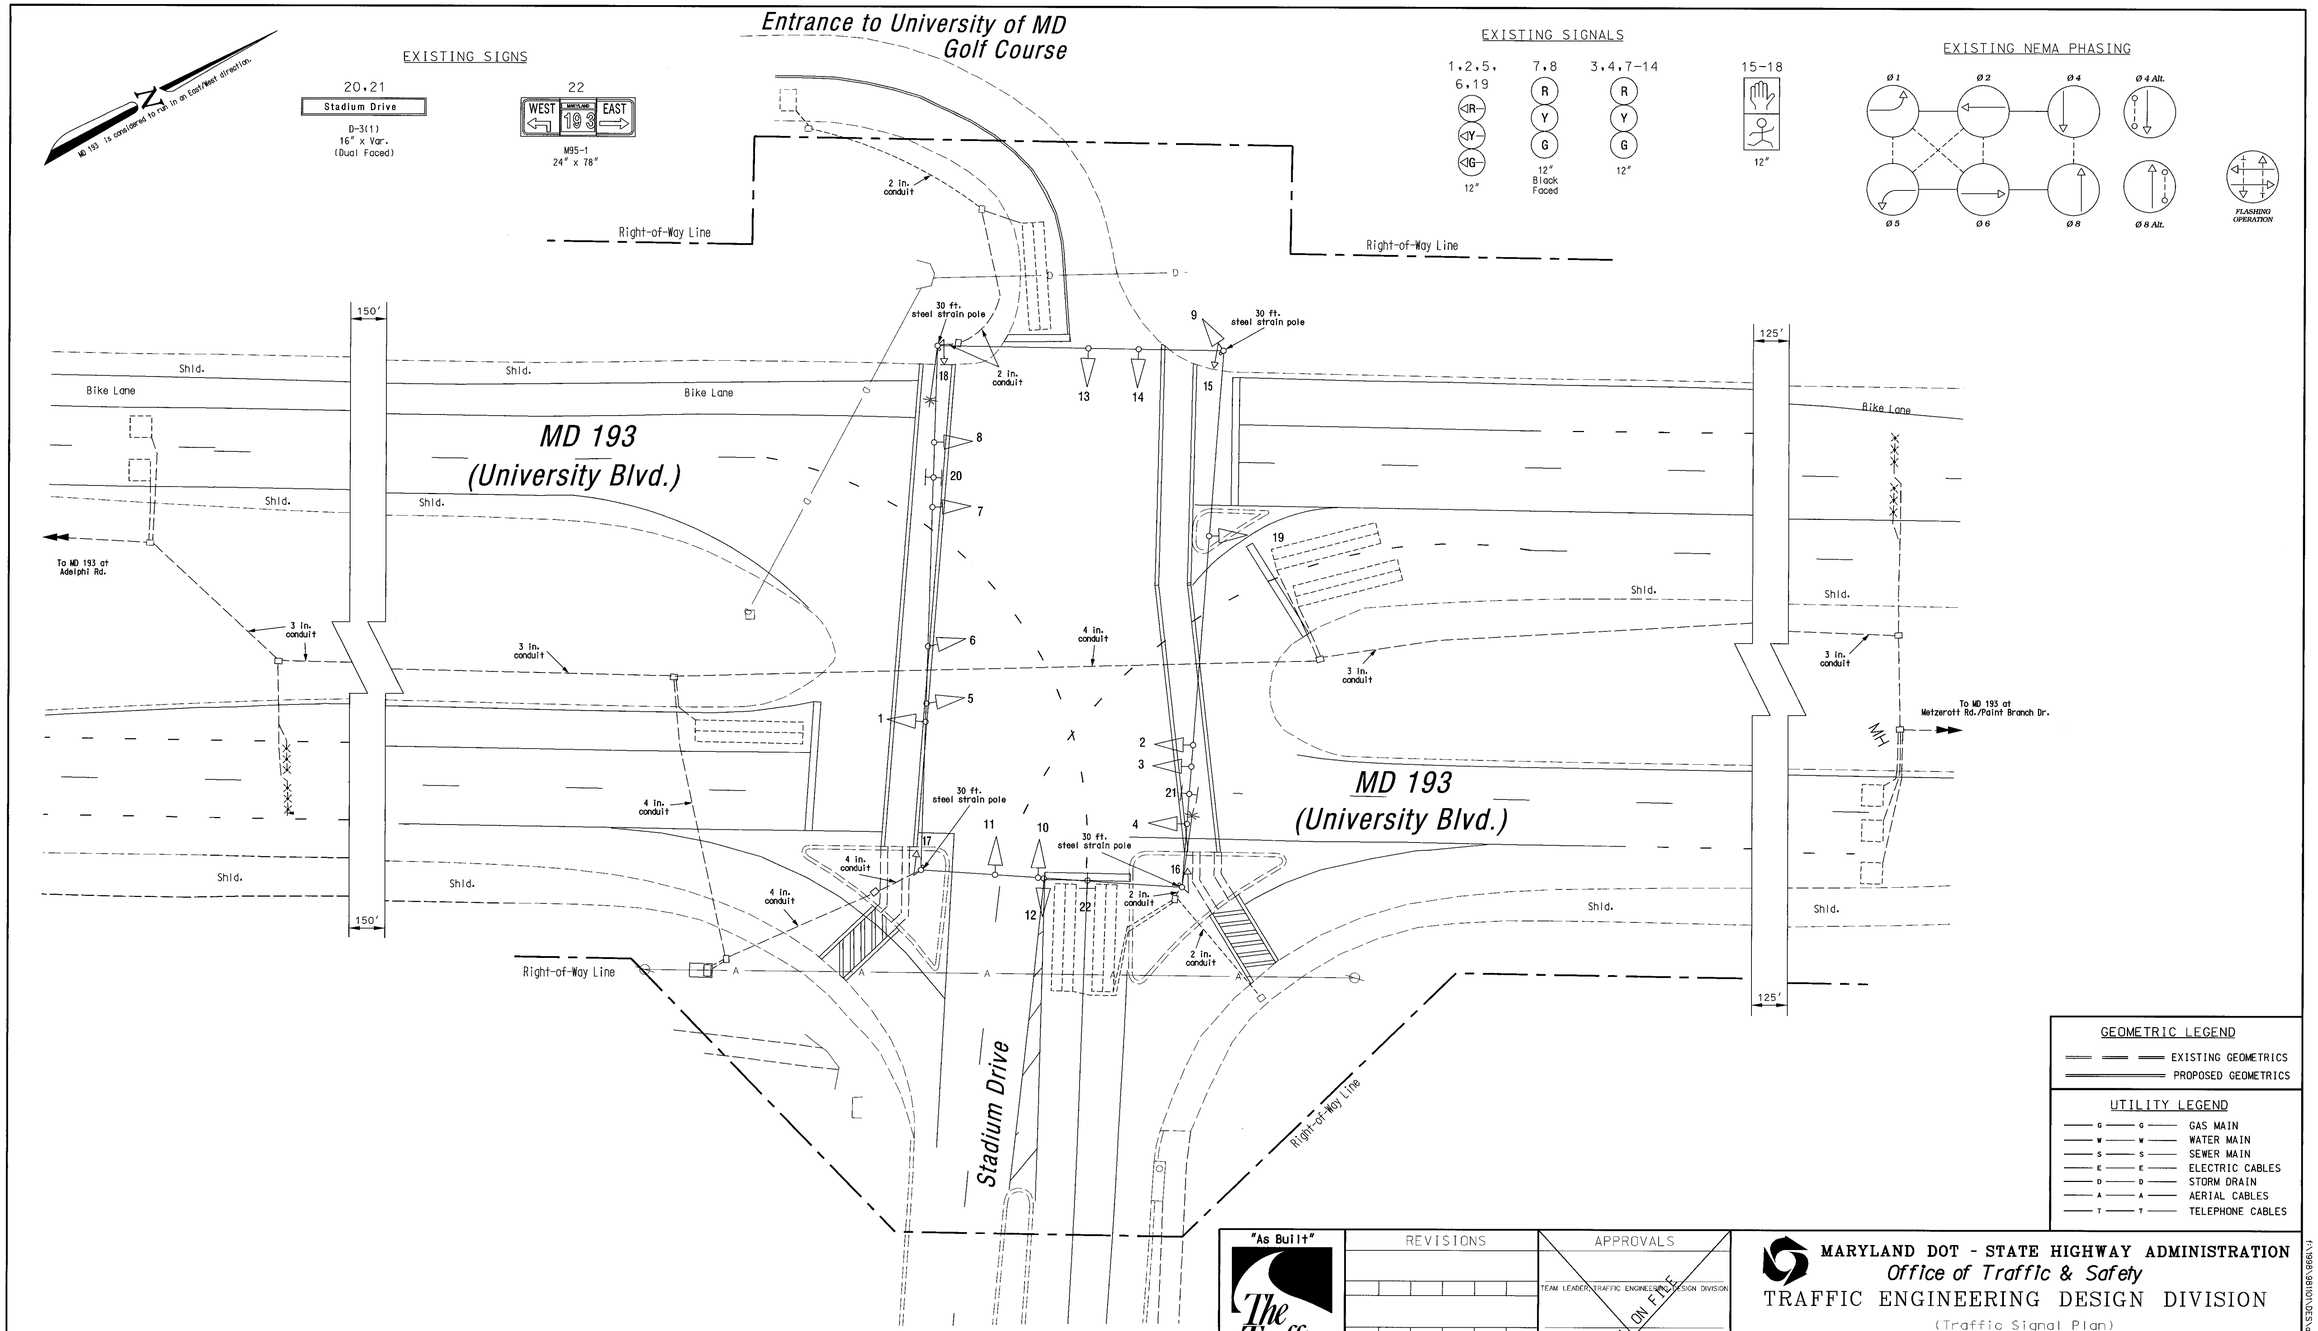

"As Built"

The Traffic Group

The Traffic Group, Inc.
410-931-6600
Fax 410-931-6601

REVISIONS

(A) "as built" September 23, 2002
S.H.A. No.:BW996M82
mnd

APPROVALS

TEAM LEADER, TRAFFIC ENGINEERING DESIGN DIVISION

ASST. CHIEF TRAFFIC ENGINEERING DESIGN DIVISION

CHIEF, TRAFFIC ENGINEERING DESIGN DIVISION

DIRECTOR, TRAFFIC & SAFETY

ORIGINAL ON FILE

MARYLAND DOT - STATE HIGHWAY ADMINISTRATION

Office of Traffic & Safety

TRAFFIC ENGINEERING DESIGN DIVISION

(Traffic Signal Plan)

MD 193 (University Blvd.) at Stadium Drive

DRAWN BY:	Steve Renzi	F.A.P. NO.	M-5018 (2)	TS NO. 1010A	SHEET NO.
CHECKED BY:	W.R.	S.H.A. NO.	P-337-001-385		
SCALE:	1" = 20'	COUNTY:	Princes George's	T.I.M.S. NO. E-758	1 OF 1
DATE:	September 20, 1973	LOG MILE:			

f:\1998\98110\DES\asbuilt3.dgn 9/27/2002