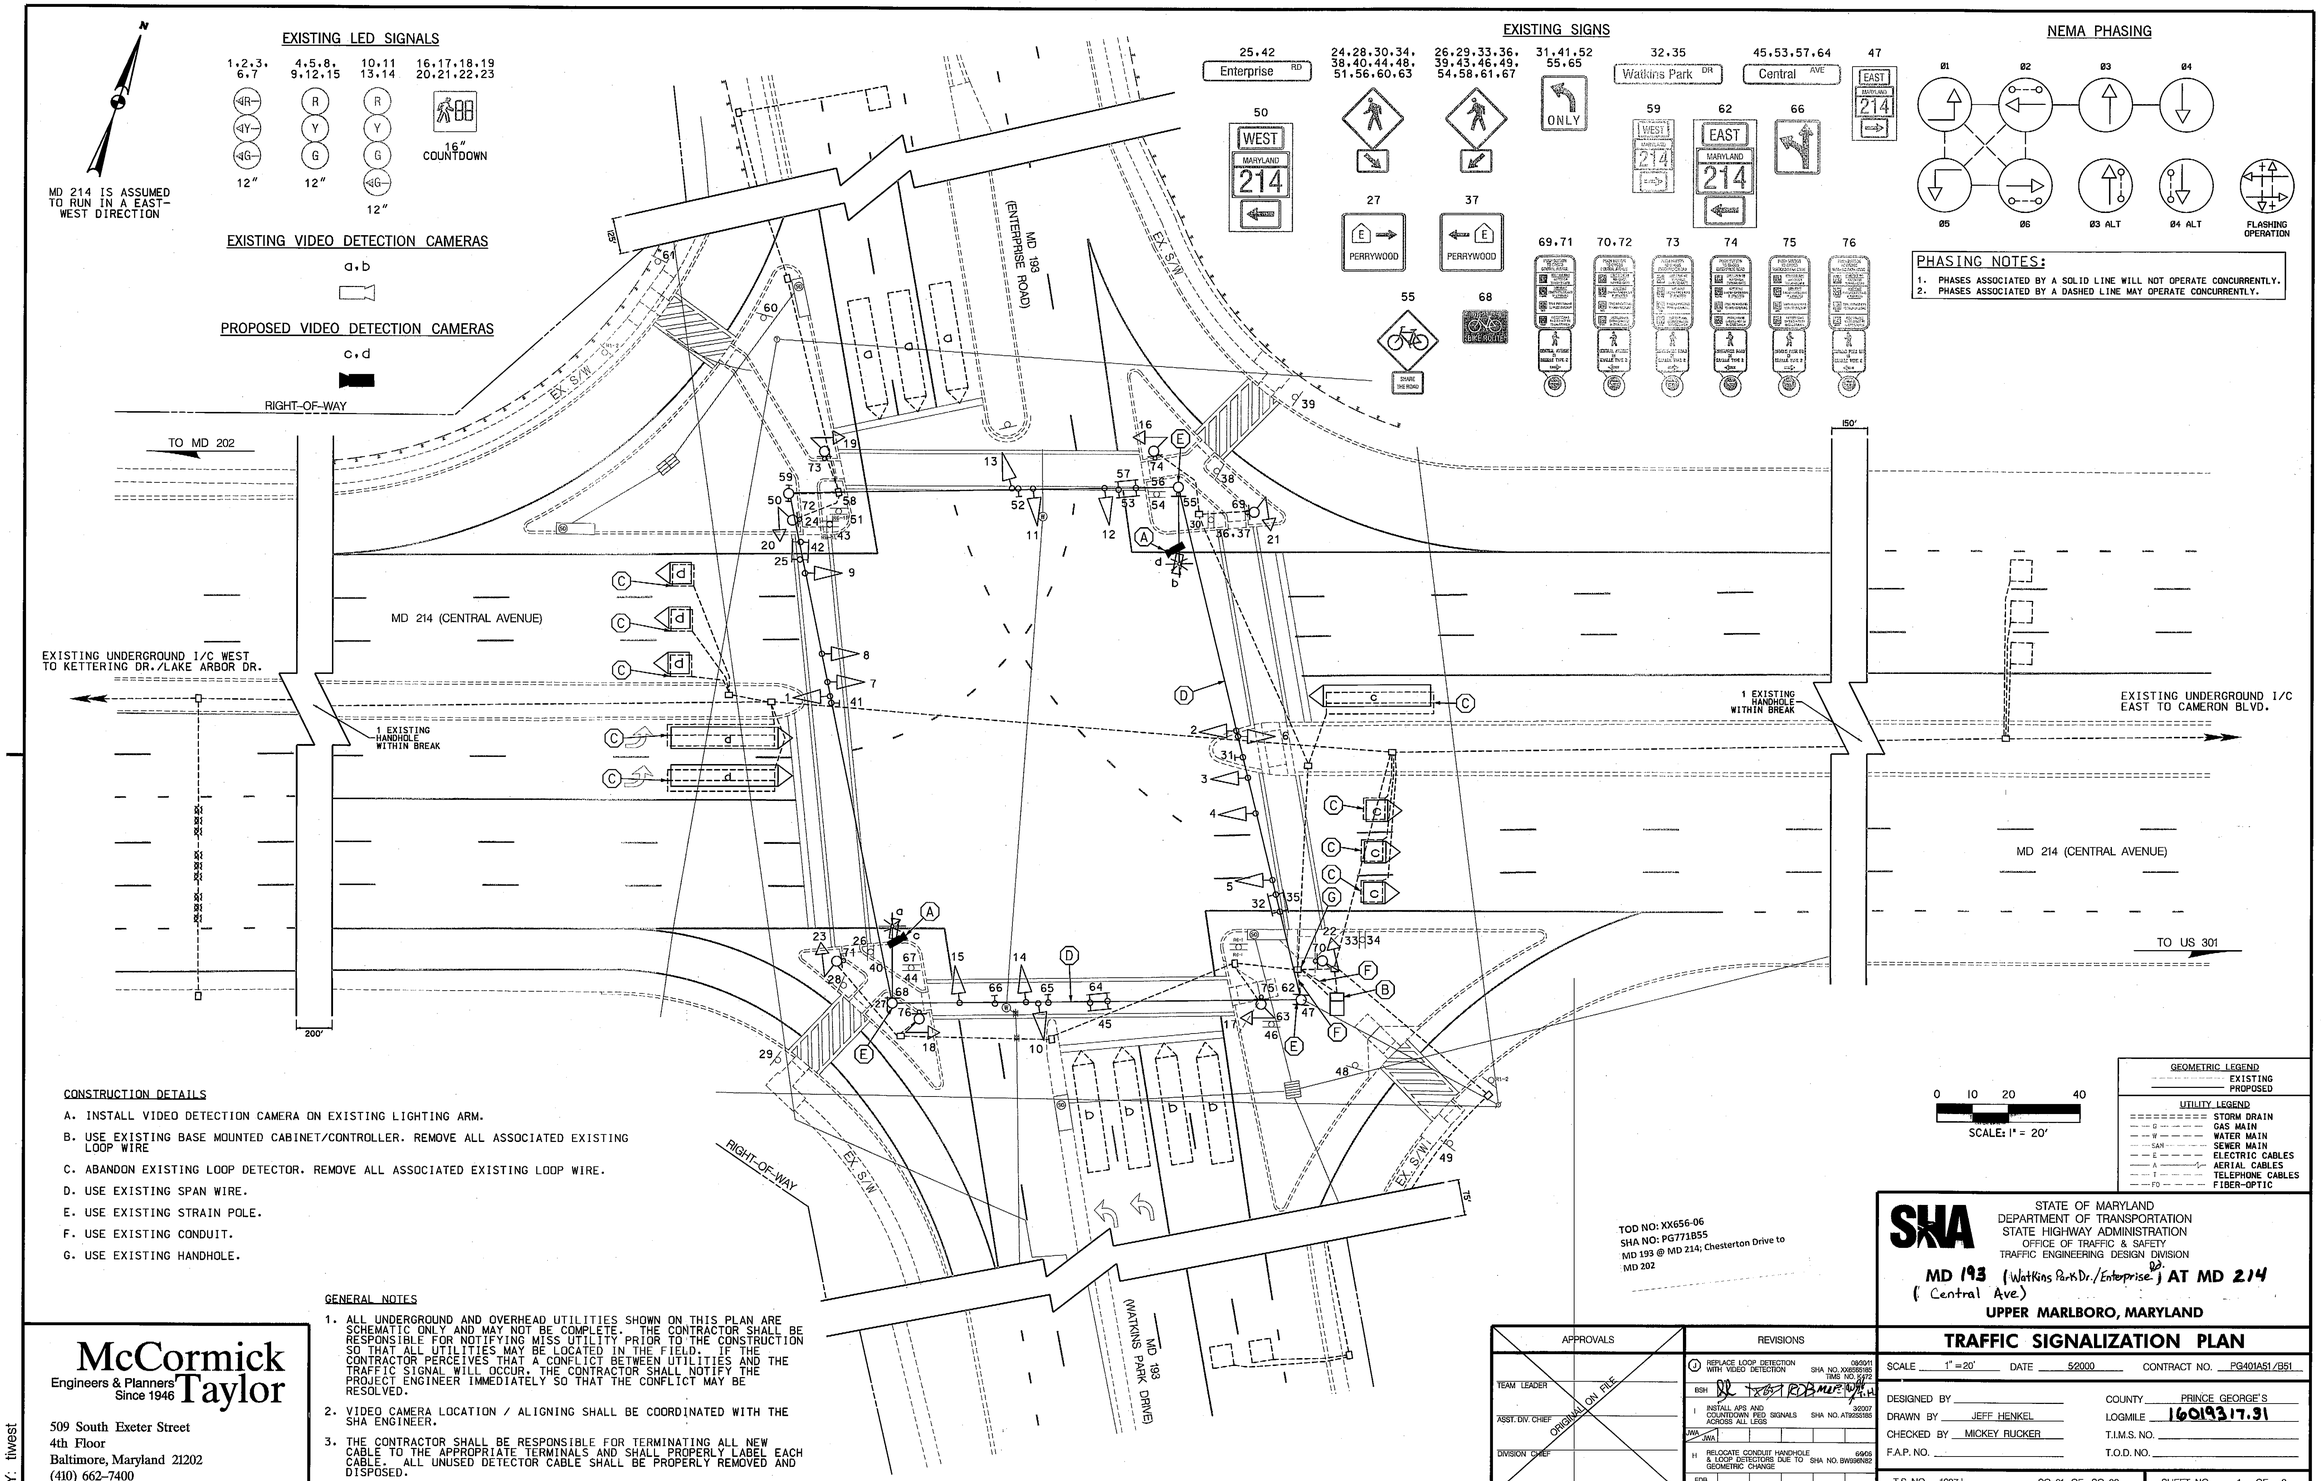

CONSTRUCTION DETAILS

A. INSTALL VIDEO DETECTION CAMERA ON EXISTING LIGHTING ARM.

B. USE EXISTING BASE MOUNTED CABINET/CONTROLLER. REMOVE ALL ASSOCIATED EXISTING LOOP WIRE

C. ABANDON EXISTING LOOP DETECTOR. REMOVE ALL ASSOCIATED EXISTING LOOP WIRE.

D. USE EXISTING SPAN WIRE.

E. USE EXISTING STRAIN POLE.

F. USE EXISTING CONDUIT.

G. USE EXISTING HANDHOLE.

GENERAL NOTES

1. ALL UNDERGROUND AND OVERHEAD UTILITIES SHOWN ON THIS PLAN ARE SCHEMATIC ONLY AND MAY NOT BE COMPLETE. THE CONTRACTOR SHALL BE RESPONSIBLE FOR NOTIFYING MISS UTILITY PRIOR TO THE CONSTRUCTION SO THAT ALL UTILITIES MAY BE LOCATED IN THE FIELD. IF THE CONTRACTOR PERCEIVES THAT A CONFLICT BETWEEN UTILITIES AND THE TRAFFIC SIGNAL WILL OCCUR. THE CONTRACTOR SHALL NOTIFY THE PROJECT ENGINEER IMMEDIATELY SO THAT THE CONFLICT MAY BE RESOLVED.

2. VIDEO CAMERA LOCATION / ALIGNING SHALL BE COORDINATED WITH THE SHA ENGINEER.

3. THE CONTRACTOR SHALL BE RESPONSIBLE FOR TERMINATING ALL NEW CABLE TO THE APPROPRIATE TERMINALS AND SHALL PROPERLY LABEL EACH CABLE. ALL UNUSED DETECTOR CABLE SHALL BE PROPERLY REMOVED AND DISPOSED.