F.H.WA. REGION NO	STATE	FED. AID PROJ. NO	SHEET NO.	TOTAL SHEETS
3	MD.			

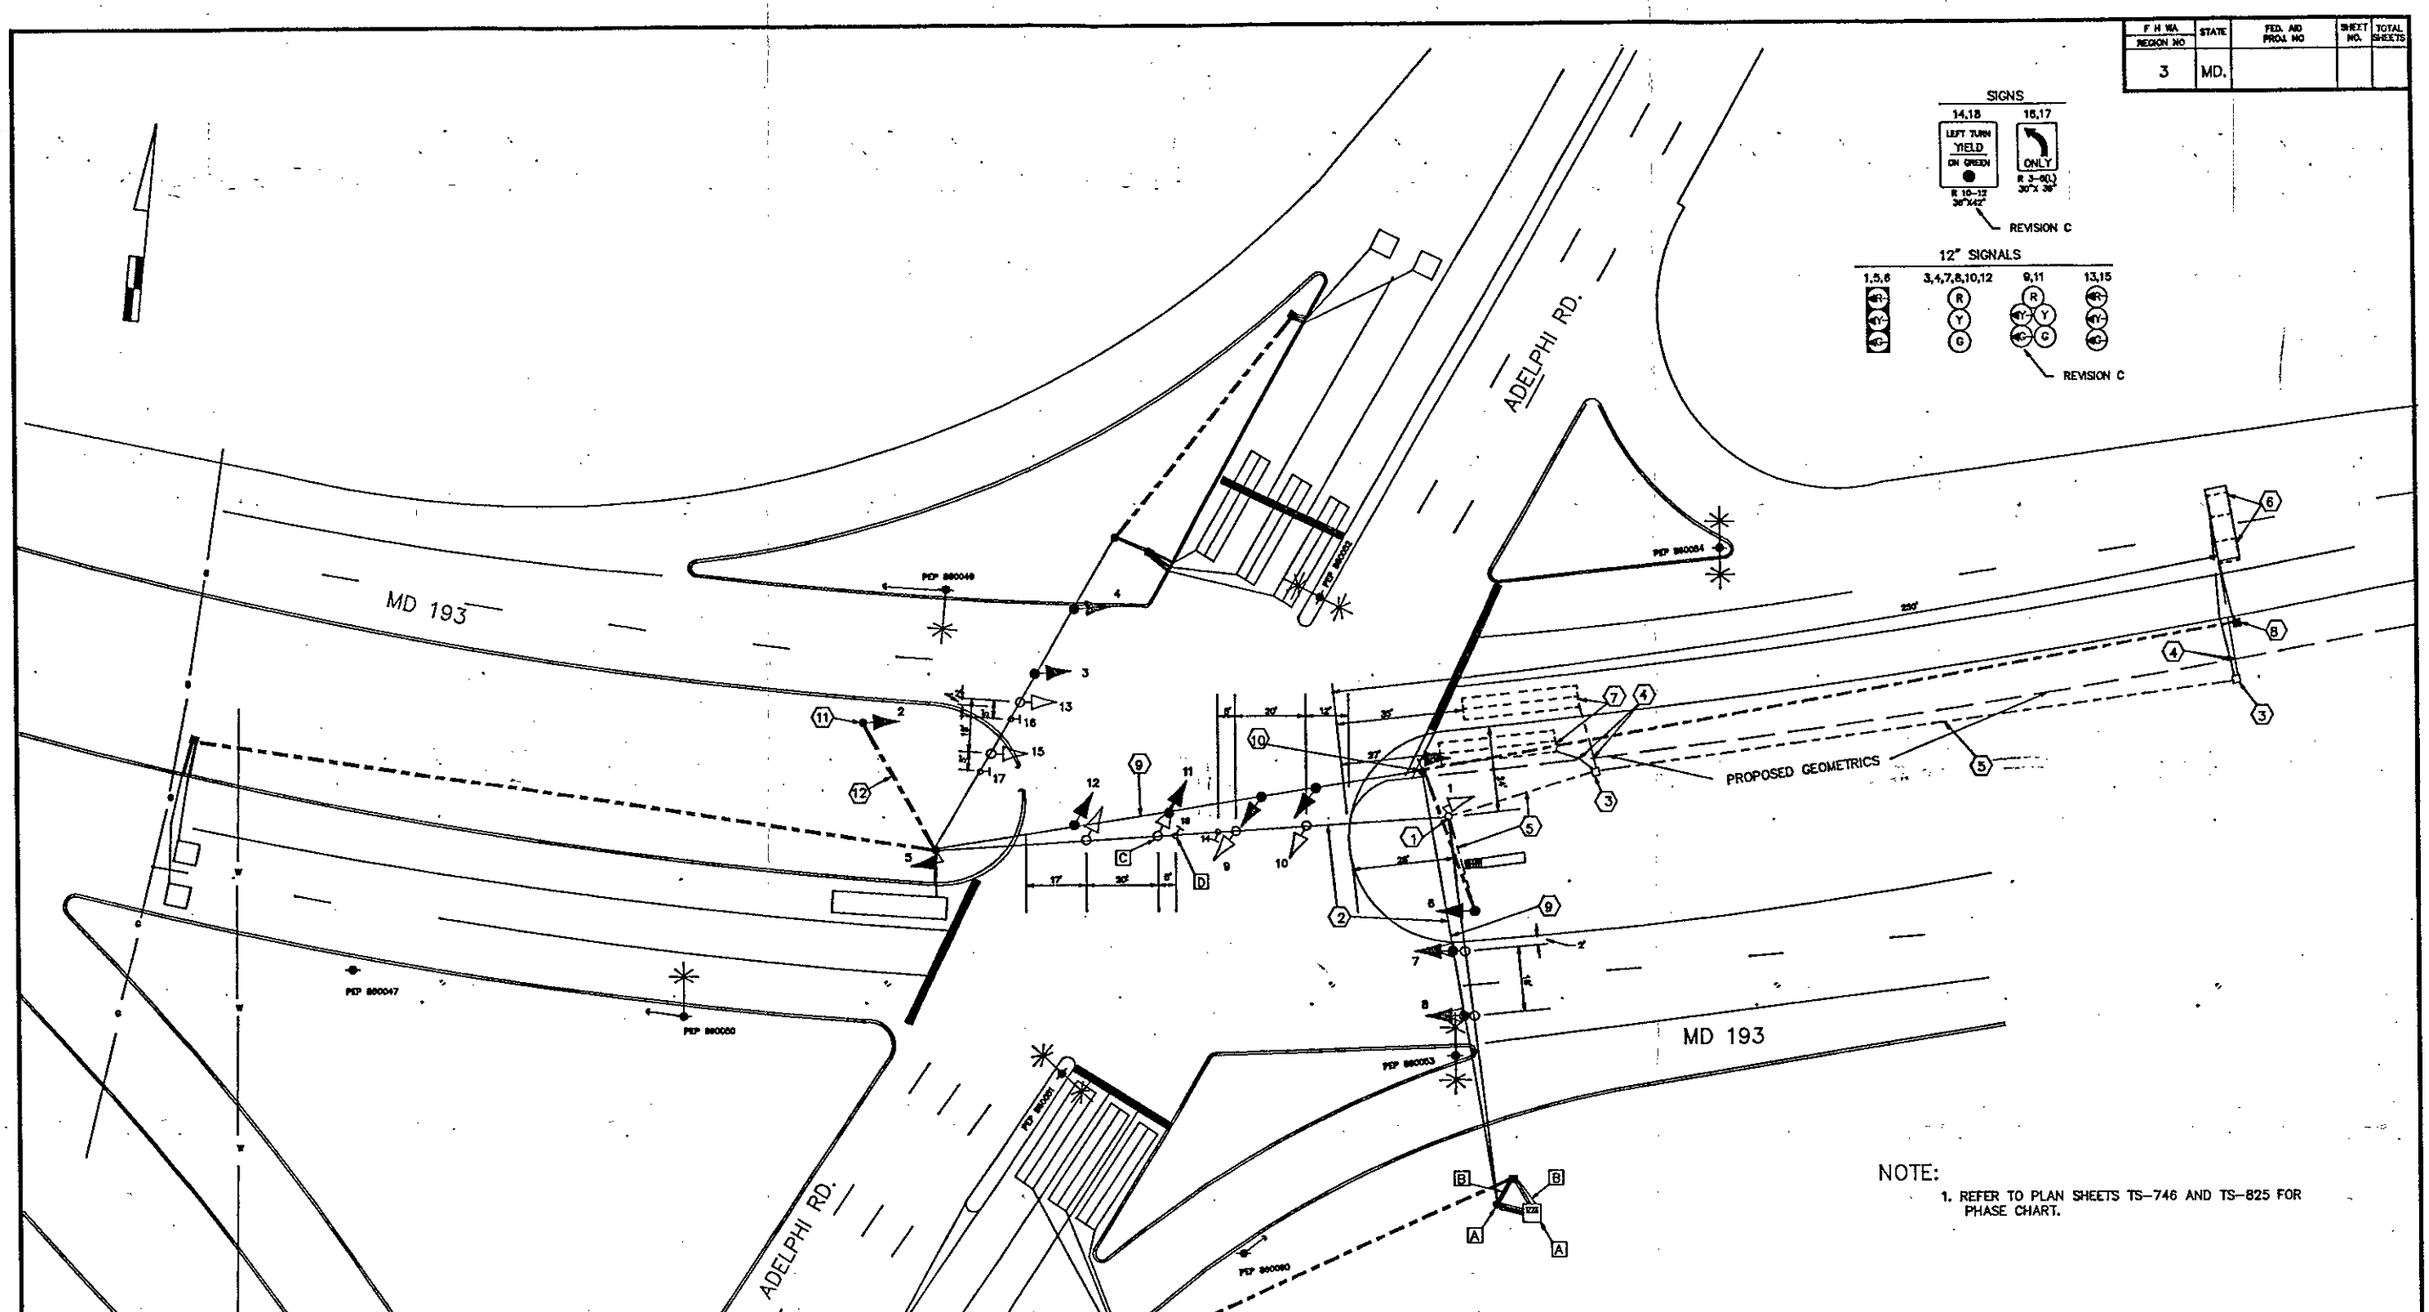

NOTE:

1. REFER TO PLAN SHEETS TS-746 AND TS-825 FOR PHASE CHART.

REVISIONS	APPROVALS
A 7-91 RECUT LOOP DETECTOR AW-680-501-062 MINOR MOD. CONTRACT	CHIEF, SIGNAL DESIGN SECTION
EAM SR ETP TH B 9-2-90 MODIFIED DESIGN DUE TO GEOMETRIC IMPROVEMENTS.	ASST. DISTRICT ENGINEER, TRAFFIC
C 1/91 INSTALL 3" ELBOW IN POLE & CABINET BASE, CHANGED SIGNAL # 11.	CHIEF, TRAFFIC ENGINEERING DIVISION
	DEPUTY CHIEF ENGINEER, OFFICE OF TRAFFIC

REVISION S.H.A. APPROVAL DATE 9-25-90 MAKES THIS AS CONTRACT NO. 5075 THE OFFICIAL PLAN IN THE FILE

MARYLAND DEPARTMENT OF TRANSPORTATION
STATE HIGHWAY ADMINISTRATION – OFFICE OF TRAFFIC
TRAFFIC ENGINEERING DIVISION

DRAWN BY BRUCE THOMPSON
DES. BY:
CHK. BY:
DATE: REDRAWN 9-2-90
SCALE: 1"=20'

MD 193 (UNIVERSITY BLVD.) and ADELPHI RD.

16019302.22

COUNTY: PRINCE GEORGE'S

F.A.P. NO.
S.H.A. NO.

TS/FILE NO. 288 C

SHEET NO. ___ OF ___

16019302.22