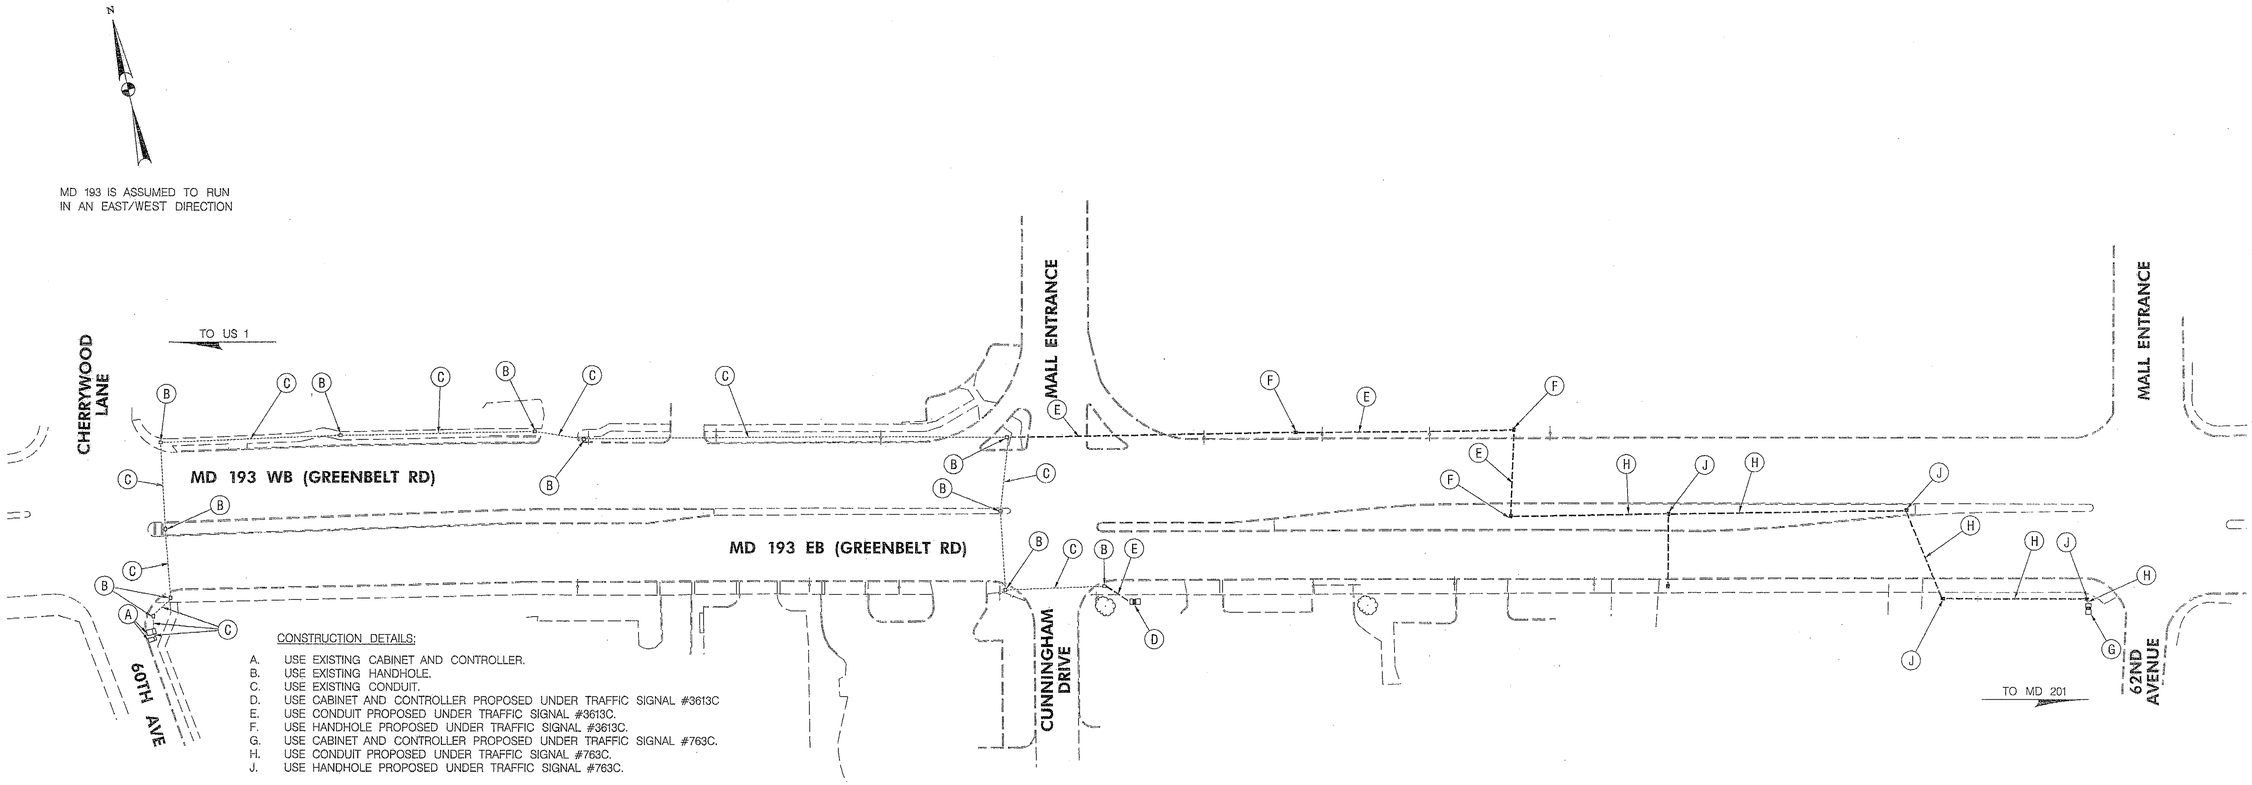

CONSTRUCTION DETAILS:

A. USE EXISTING CABINET AND CONTROLLER.
B. USE EXISTING HANDHOLE.
C. USE EXISTING CONDUIT.
D. USE CABINET AND CONTROLLER PROPOSED UNDER TRAFFIC SIGNAL #3613C
E. USE CONDUIT PROPOSED UNDER TRAFFIC SIGNAL #3613C.
F. USE HANDHOLE PROPOSED UNDER TRAFFIC SIGNAL #3613C.
G. USE CABINET AND CONTROLLER PROPOSED UNDER TRAFFIC SIGNAL #763C.
H. USE CONDUIT PROPOSED UNDER TRAFFIC SIGNAL #763C.
J. USE HANDHOLE PROPOSED UNDER TRAFFIC SIGNAL #763C.

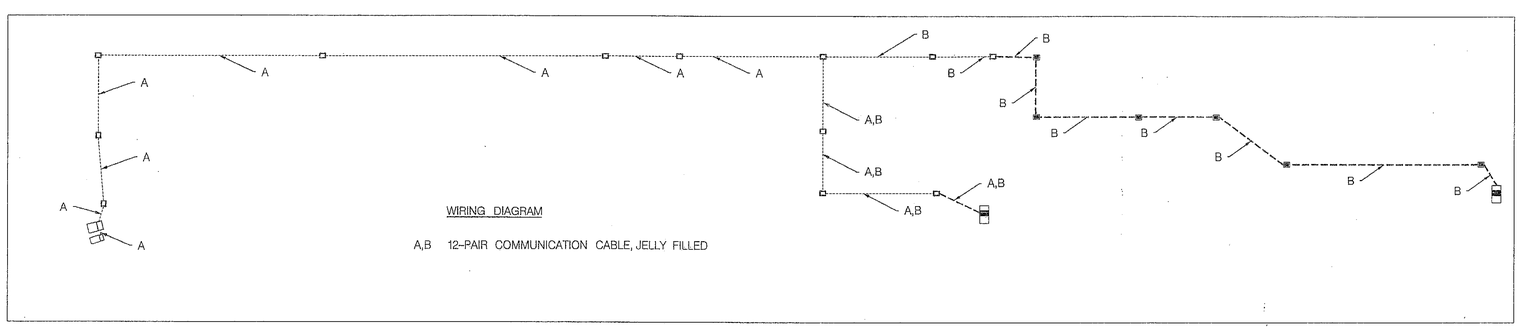

WIRING DIAGRAM

A,B 12-PAIR COMMUNICATION CABLE, JELLY FILLED

REDLINE 1
ADDITION OF SIGNAL TO PROJECT PG8925177

GEOMETRIC LEGEND

EXISTING
PROPOSED

UTILITY LEGEND

SD	STORM DRAIN
	GAS MAIN
W	WATER MAIN
S	SEWER MAIN
E	ELECTRIC CABLES
A	AERIAL CABLES
T	TELEPHONE CABLES
F	FIBER-OPTIC CABLES

BY: davidma –

BRUDIS & ASSOCIATES, INC.
Consulting Engineers
9240 Rumsey Road; Suite 110
Columbia, Maryland 21045
Phone 410-884-3607
www.brudis.com

APPROVALS	
TEAM LEADER	
ASST. DIV. CHIEF	11/16/12
DIVISION CHIEF	11/20/12
OFFICE DIRECTOR	

REVISIONS

STATE OF MARYLAND
DEPARTMENT OF TRANSPORTATION
STATE HIGHWAY ADMINISTRATION

OFFICE OF TRAFFIC & SAFETY
TRAFFIC ENGINEERING DESIGN DIVISION
MD 193 (GREENBELT RD) BETWEEN
(60TH AVE AND 62ND AVE)
GREENBELT, MD

INTERCONNECT PLAN

SCALE 1" = 50' ADVERTISED DATE 09/2012 CONTRACT NO. PG8925177

DESIGNED BY CW
DRAWN BY CW
CHECKED BY RM
F.A.P. NO.
COUNTY PRINCE GEORGE'S
LOGMILE 16019305.18-16019305.45
TIMS NO. L274
TOD NO.

TS NO. 12405 | DRAWING SG - 1 OF 2 | SHEET NO. 25 OF 26

PLOTTED: Thursday, November 01, 2012 AT 12:49 PM
FILE: P:\09-002 TEDD\Task 94 MD 193 Rhode Island Ave to Southway\Drawings\CADD\Working\MD193@Cunningham\pSG-C001_MD193@Cunningham.dgn