FHWA REGION NO.	STATE	FED. AID PROJ. NO.	SHEET NO.	TOTAL SHEETS
3	MD			

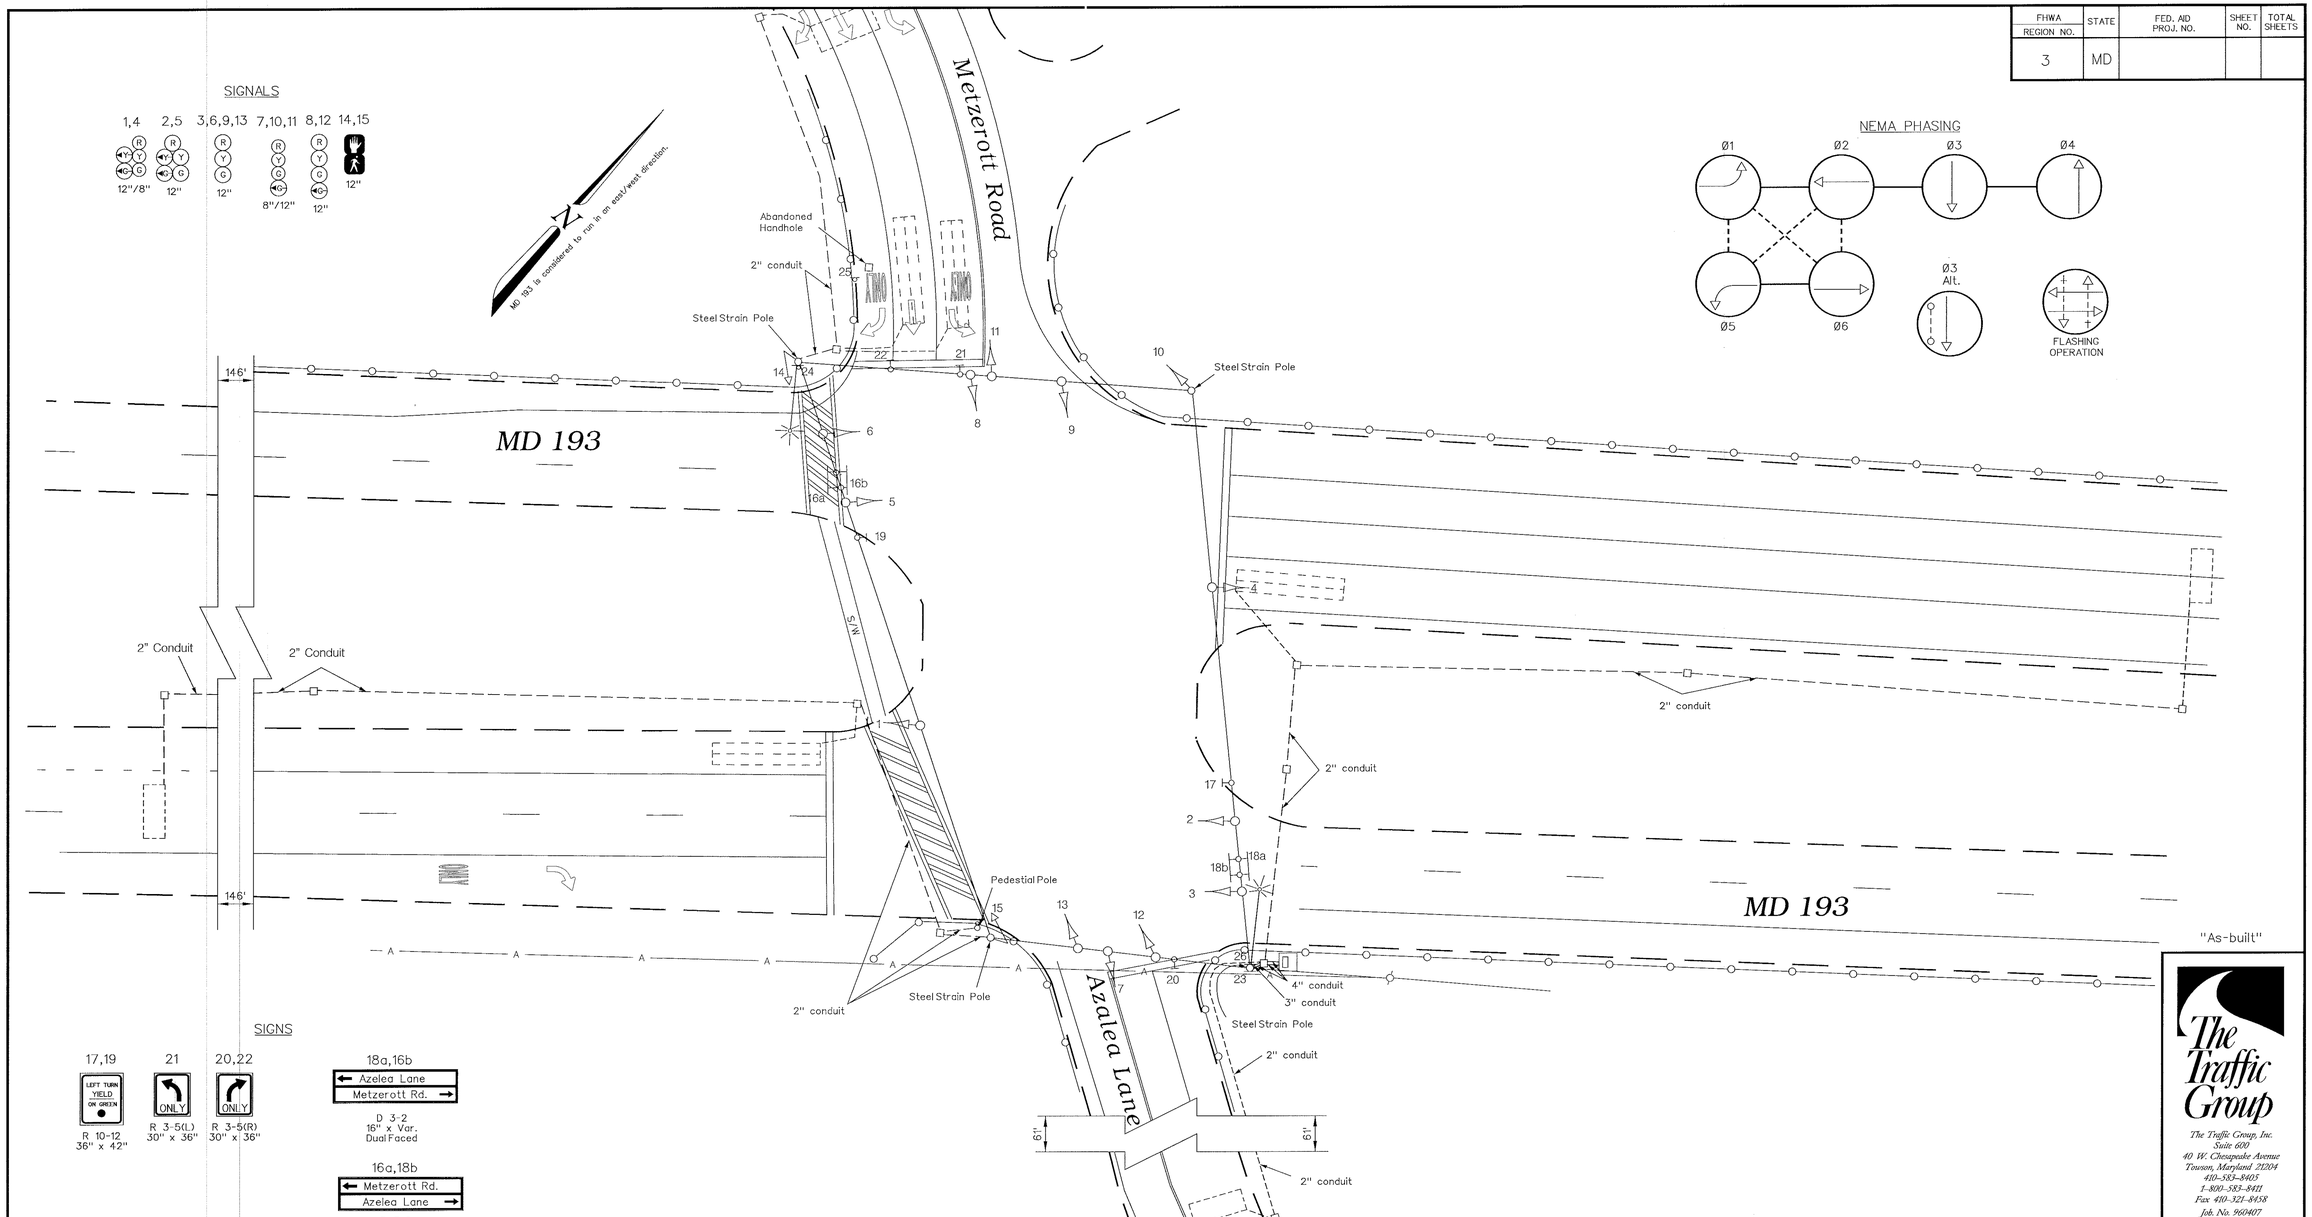

"As-built"

The Traffic Group

The Traffic Group, Inc.
Suite 600
40 W. Chesapeake Avenue
Towson, Maryland 21204
410-583-8405
1-800-583-8411
Fax 410-321-4638
Job No. 960407

GEOMETRIC LEGEND

EXISTING GEOMETRICS
PROPOSED GEOMETRICS

UTILITY LEGEND

G — GAS MAIN
W — WATER MAIN
S — SEWER MAIN
E — ELECTRIC CABLES
D — STORM DRAIN
A — AERIAL CABLES
T — TELEPHONE CABLES

REVISIONS

© May 23, 1996
As-Built
S.H.A. No.: 855-25057042
FTH

APPROVALS

ASST. DIVISION CHIEF TRAFFIC ENGINEERING DESIGN DIVISION
CHIEF, TRAFFIC ENGINEERING DESIGN DIVISION
ASST. DISTRICT ENGINEER - TRAFFIC
DIRECTOR, OFFICE OF TRAFFIC & SAFETY
ORIGINAL ON FILE

MDOT – STATE HIGHWAY ADMINISTRATION
Office of Traffic & Safety
TRAFFIC ENGINEERING DESIGN DIVISION

DRAWN BY: H. KILIAN
DES. BY:
CHK. BY:

(Traffic Signal Plan)
MD 193 at Metzerott Road / Azalea Lane

COUNTY: PRINCE GEORGE'S
LOG MILE • 16019303.93

DATE: 9/7/73
SCALE: 1" = 20'
F.A.P. NO. N/A
S.H.A. NO. P-337-001-385
TS/STD. NO. 1034C-P
SHEET NO. 1 of 1