F.H.WA. REGION NO.	STATE	FED. AID PROJ. NO.	SHEET NO.	TOTAL SHEETS
3	MD.		1	5

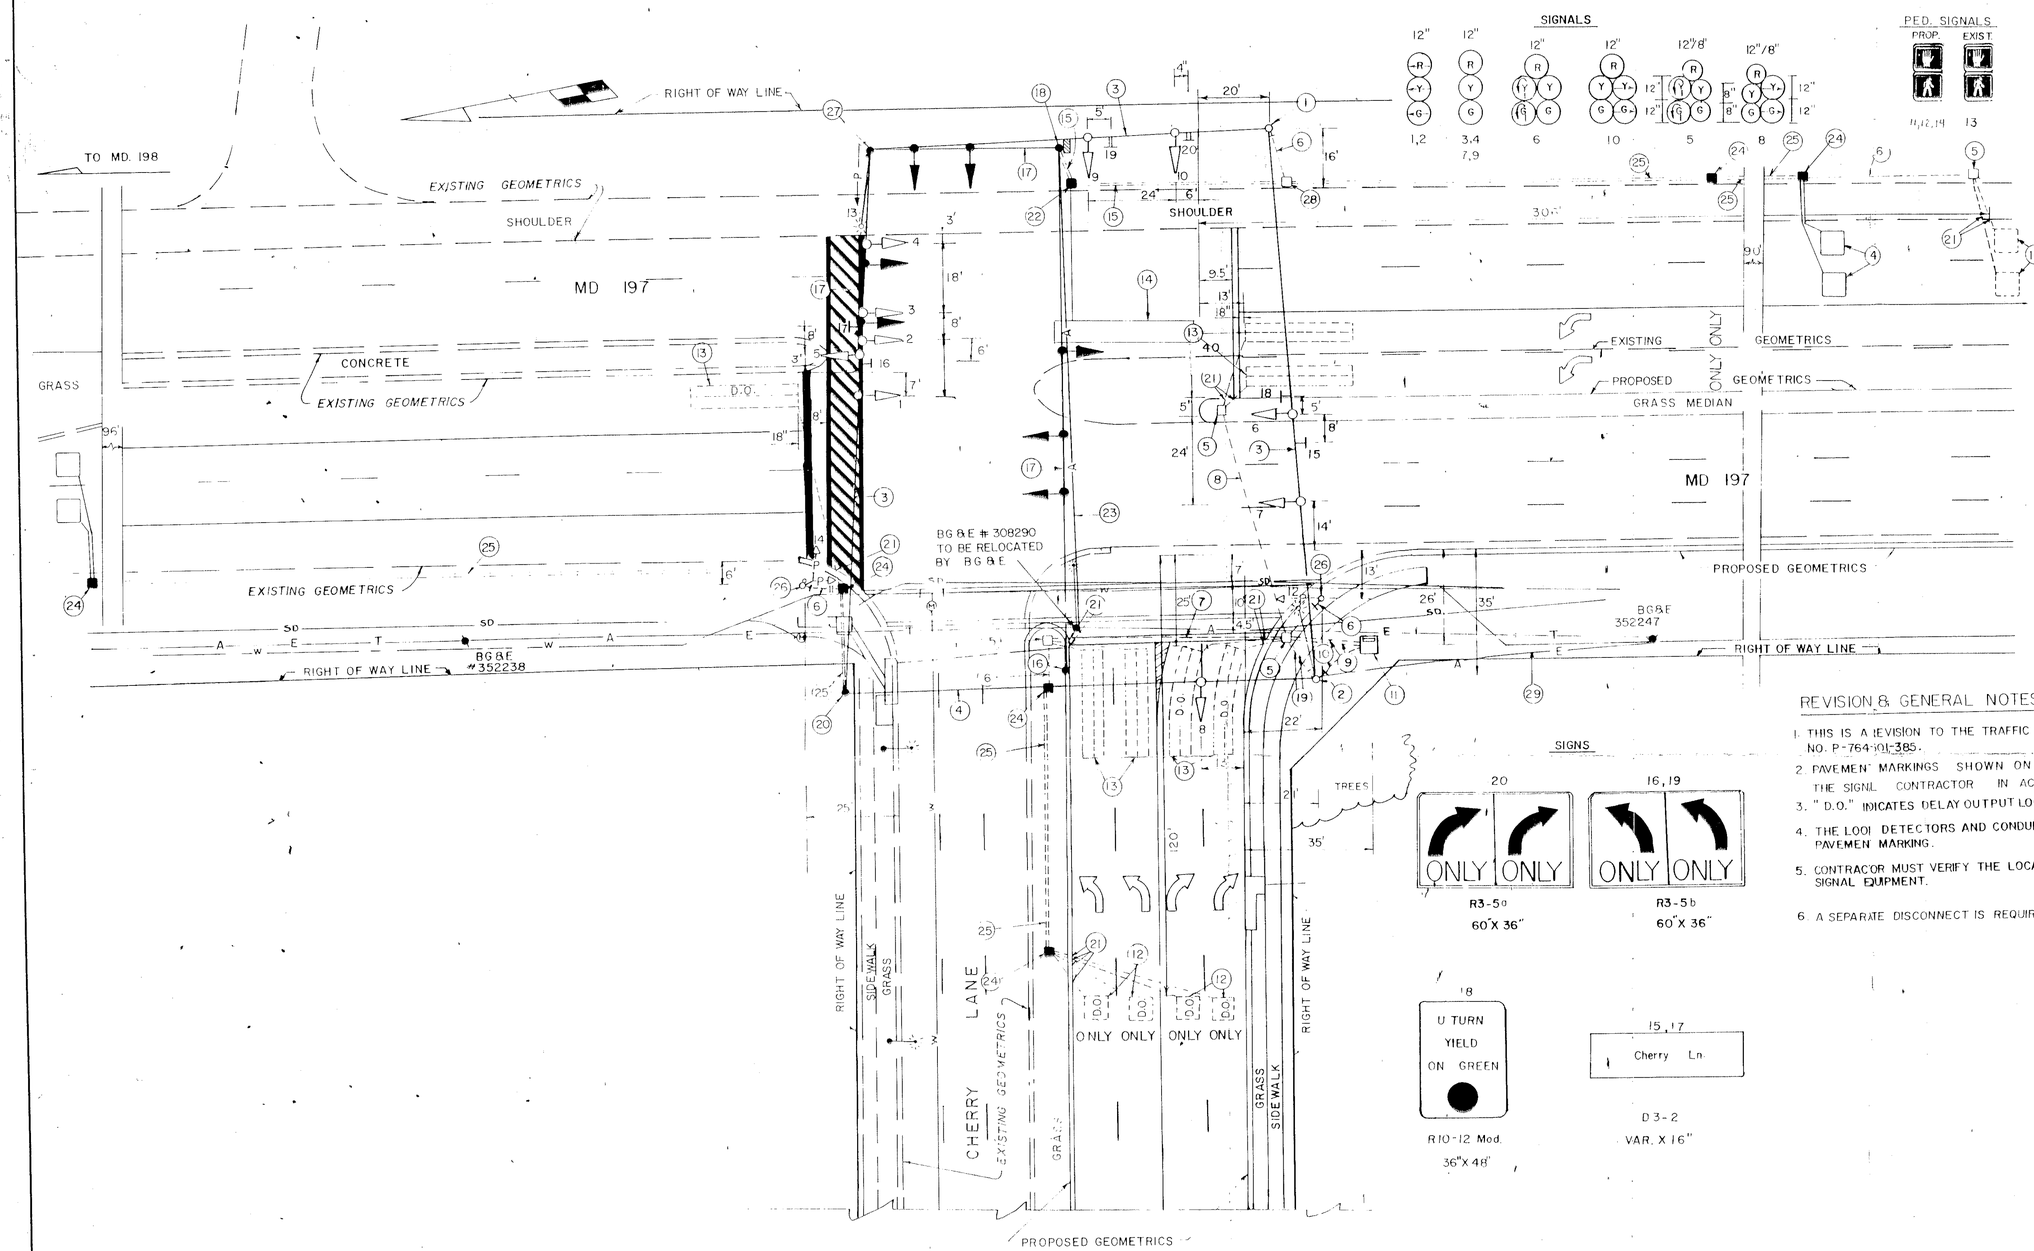

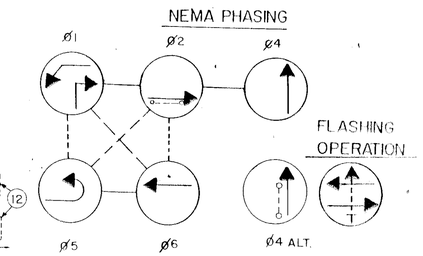

PHASING NOTES

1. PHASES ASSOCIATED BY A DASHED LINE WILL OPERATE CONCURRENTLY
2. PHASES ASSOCIATED BY A SOLID LINE WILL NOT OPERATE CONCURRENTLY

REVISION & GENERAL NOTES

1. THIS IS A REVISION TO THE TRAFFIC SIGNAL INSTALLED IN OCTOBER, 1982, UNDER CONTRACT NO. P-764-101-385.
2. PAVEMENT MARKINGS SHOWN ON DRAWING ARE PROPOSED AND WILL BE INSTALLED BY THE SIGNAL CONTRACTOR IN ACCORDANCE WITH S.H.A. STANDARDS (SEE TYPICAL)
3. "D.O." INDICATES DELAY OUTPUT LOOP DETECTOR.
4. THE LOOP DETECTORS AND CONDUITS MUST BE INSTALLED PRIOR TO THE INSTALLATION OF PAVEMENT MARKING.
5. CONTRACTOR MUST VERIFY THE LOCATION OF ALL PROPOSED GEOMETRICS PRIOR TO INSTALLING SIGNAL EQUIPMENT.
6. A SEPARATE DISCONNECT IS REQUIRED FOR STREET LIGHTING

Office of Traffic & Safety Engineer
STATE HIGHWAY ADMINISTRATION
9300 Kenilworth Avenue
Greenbelt, Maryland 20770

DEPARTMENT OF PUBLIC WORKS AND TRANSPORTATION
PRINCE GEORGE'S COUNTY, MARYLAND

MD 197 & CHERRY LANE

UTILITY LEGEND	
—T—T—T—	TELEPHONE CABLES
—SD—SD—SD—	STORM DRAIN
—G—G—G—	GAS MAIN
—W—W—W—	WATER MAIN
—S—S—S—	SEWER MAIN
—E—E—E—	ELECTRIC CABLES
—A—A—A—	AERIAL CABLES

ROADWAY LEGEND	
= = = = =	EXISTING GEOMETRICS
═══	PROPOSED GEOMERICS

STATE OF MARYLAND — HAMMEN DALE — 10.19.82 — REGISTERED PROFESSIONAL ENGINEER

DANIEL CONSULTANTS, INC.
8950 RTE. 108 E, SUITE 229
COLUMBIA, MARYLAND

REVISIONS	
© 9-15-88	REL. SIG. EQUIP. DUE TO GEOM. IMP.
BHE	
⚠ AS BUILT AND 4-12-84	ADDED E/P RT TO SB. CHERRY LANE
EMM	
⚠ SEPT 7, 1983	ADD PUSHBUTTON & SIGN TO CROSS MD197

APPROVALS
CHIEF, SIGNAL DESIGN SECTION
ASST. DISTRICT ENGINEER, TRAFFIC
CHIEF, BUREAU OF TRAFFIC ENGINEERING
DEPUTY CHIEF ENGINEER, OFFICE OF TRAFFIC
ORIGINAL ON FILE

MARYLAND DEPARTMENT OF TRANSPORTATION
STATE HIGHWAY ADMINISTRATION – OFFICE OF TRAFFIC
BUREAU OF TRAFFIC ENGINEERING

DRAWN BY: HOWARD J. KILIAN
DES. BY: HOWARD J. KILIAN
CHK. BY:
DATE: 10-13-1982
SCALE: 1" = 20'

MD 197 & CHERRY LANE
COUNTY: PRINCE GEORGES
F.A.P. NO.
S.H.A. NO. P-764-101-385
TS/FILE NO. TS-1884C
SHEET NO. 29 OF 35

160197/4.18