F.H.W.A. REGION NO.	STATE	FED. AID PROJ. NO.	SHEET NO.	TOTAL SHEETS
3	MD			

NOTE A DOUBLE DISCONNECT SWITCH IS REQUIRED FOR SIGNALS AND STREET LIGHTING

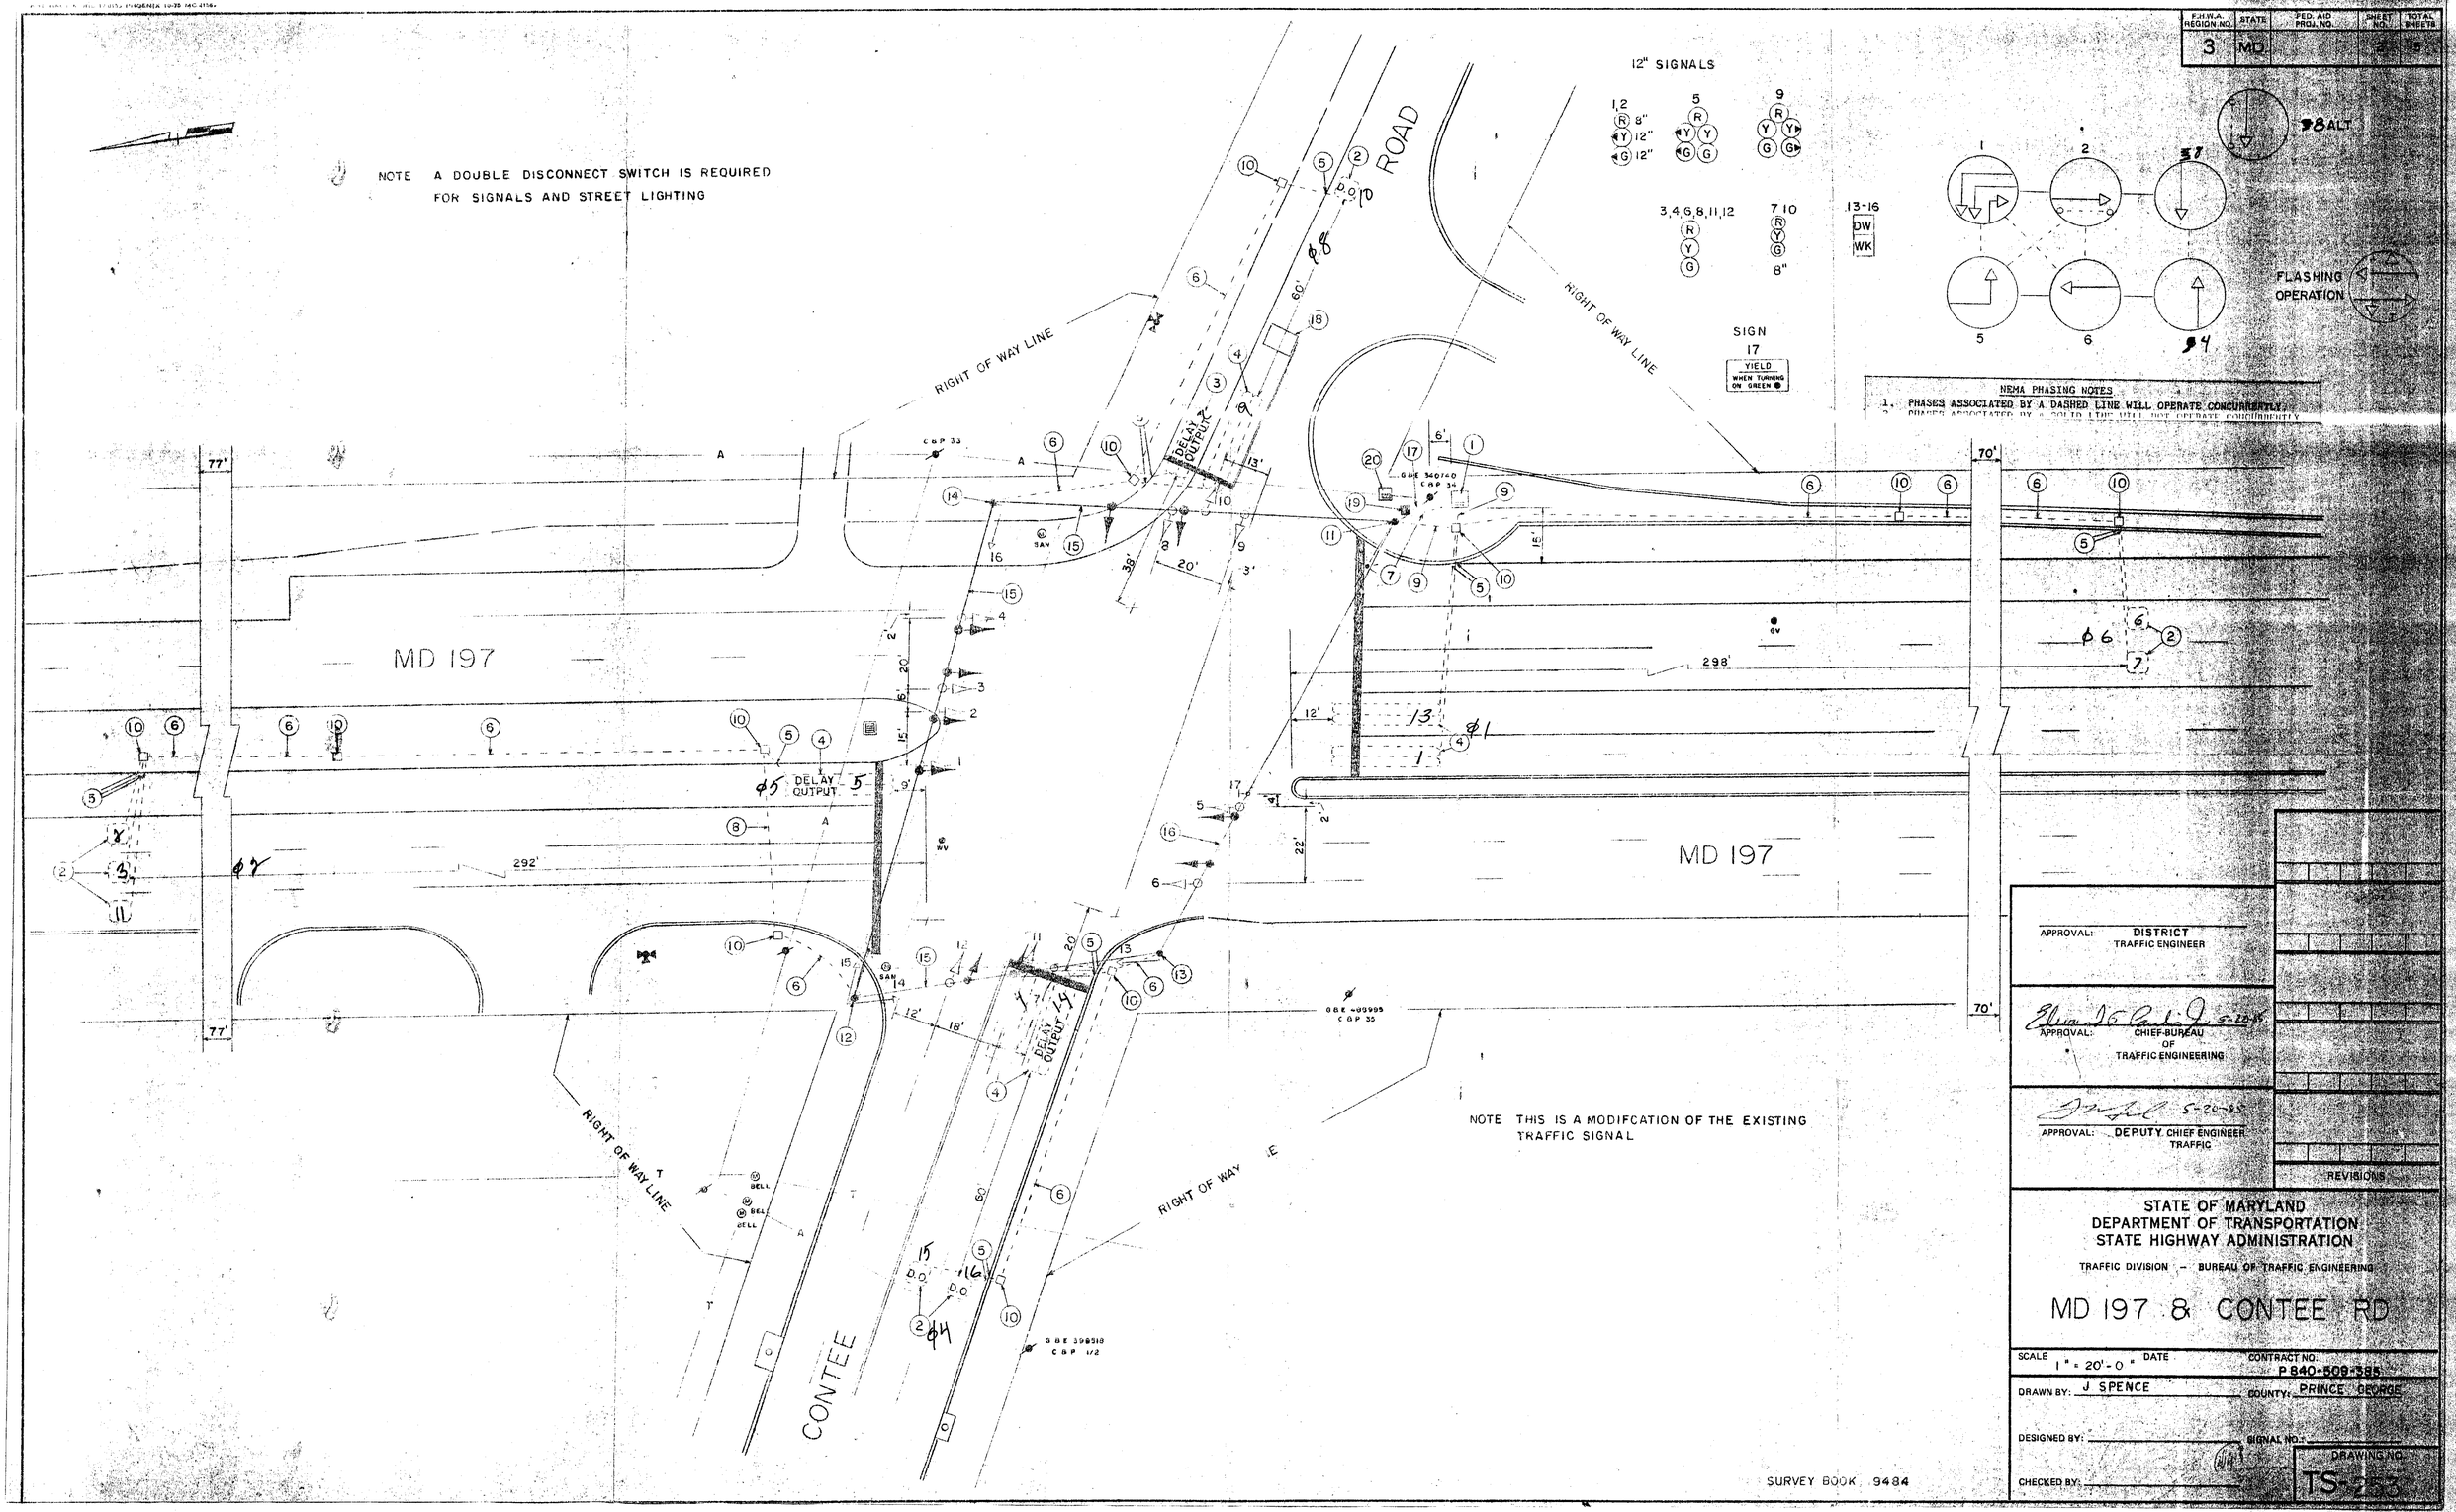

APPROVAL: DISTRICT TRAFFIC ENGINEER

APPROVAL: CHIEF-BUREAU OF TRAFFIC ENGINEERING 5-20-85

APPROVAL: DEPUTY CHIEF ENGINEER TRAFFIC 5-20-85

REVISIONS

STATE OF MARYLAND
DEPARTMENT OF TRANSPORTATION
STATE HIGHWAY ADMINISTRATION

TRAFFIC DIVISION – BUREAU OF TRAFFIC ENGINEERING

MD 197 & CONTEE RD

SCALE 1" = 20'-0" DATE CONTRACT NO. P 840-509-385

DRAWN BY: J SPENCE COUNTY: PRINCE GEORGE

DESIGNED BY: SIGNAL NO.: DRAWING NO. TS-253

CHECKED BY: