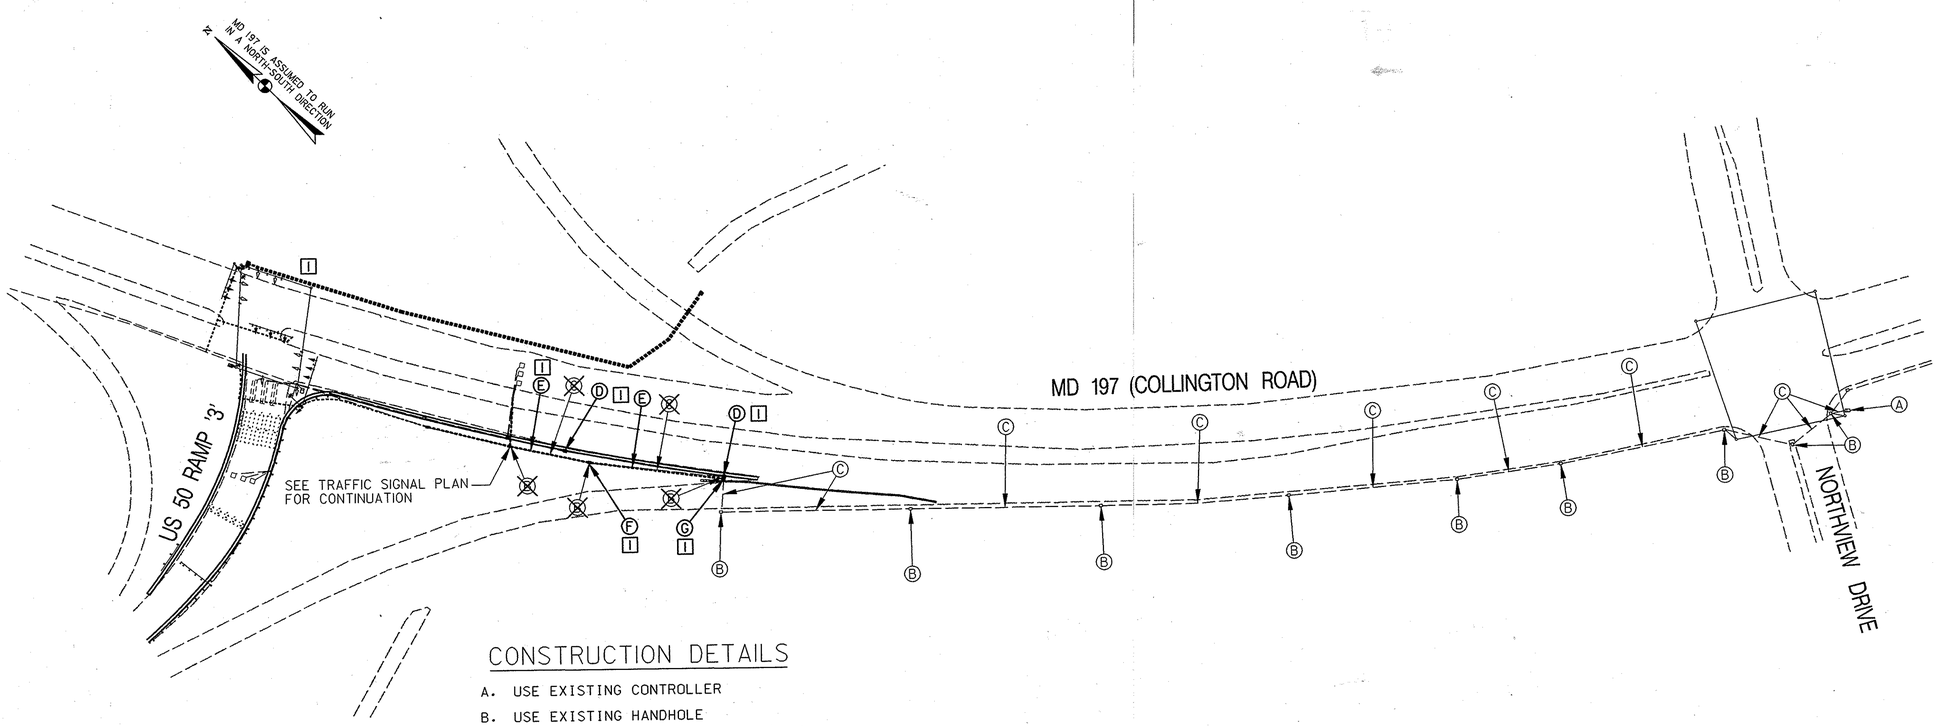

CONSTRUCTION DETAILS

A. USE EXISTING CONTROLLER
B. USE EXISTING HANDHOLE
C. USE EXISTING CONDUIT
[1] D. REMOVE EXISTING HANDHOLE
[1] E. INSTALL 3 IN. SCHEDULE 80 RIGID PVC ELECTRICAL CONDUIT (TRENCHED)
[1] F. INSTALL HANDHOLE
[1] G. INTERCEPT EXISTING CONDUIT, INSTALL HANDHOLE

WIRING DIAGRAM

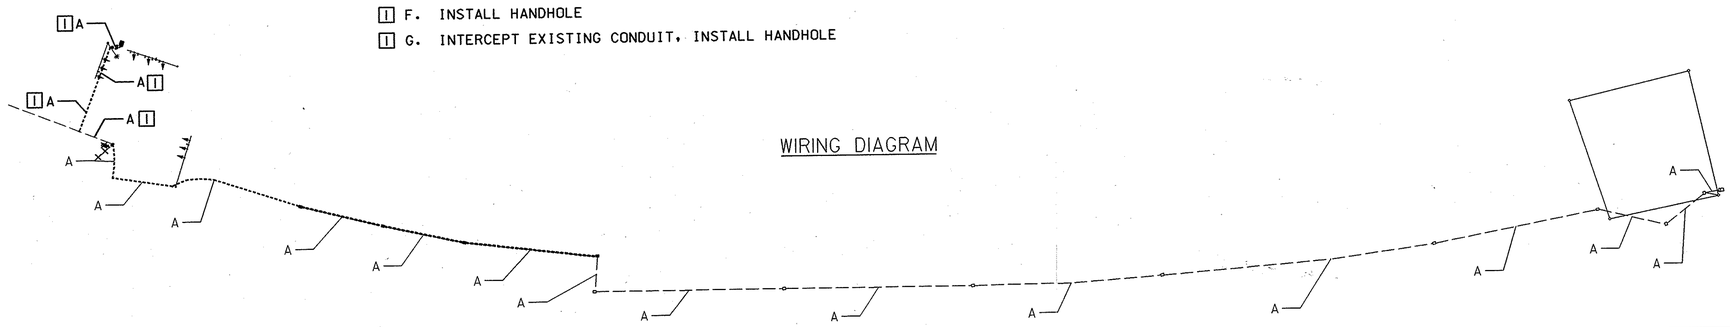

[A] -12-PAIR INTERCONNECT CABLE, JELLY FILLED (UNDERGROUND)

[1] REDLINE REVISION NO. 1

STATE OF MARYLAND
DEPARTMENT OF TRANSPORTATION
STATE HIGHWAY ADMINISTRATION
OFFICE OF TRAFFIC & SAFETY
TRAFFIC ENGINEERING DESIGN DIVISION

MD 197 (COLLINGTON ROAD) AT
US 50 (JOHN HANSON HIGHWAY)

APPROVALS	REVISIONS
TEAM LEADER Amy K. Beall 8/9/05	
ASST. DIV. CHIEF	
DIVISION CHIEF	
OFFICE DIRECTOR	

INTERCONNECT PLAN

SCALE 1"=100' DATE 1/19/05 CONTRACT NO. PG6365130

DESIGNED BY S.D.Y.
DRAWN BY S.D.Y.
CHECKED BY B.A.B.
F.A.P. NO.

COUNTY PRINCE GEORGE'S
LOGMILE 16019701.53
T.I.M.S. NO. G778
TOD NO. TS-2462A

DRAWING NO. OF SHEET NO. 14 OF 21

PLOTTED: MONDAY, AUGUST 01, 2005 AT 03:18 PM
FILE: I:\PROJECTS\11294\06US50MD197\SIGNAL\PSG-C000_MD197.DGN

STV Incorporated
engineers/architects/planners/scientists/construction managers
7125 Ambassador Road Baltimore, MD 21244-2722 (410) 944-9112

BY: THOMPSMA