NOTE: IT IS ASSUMED THAT MD 198 RUNS IN AN EAST-WEST DIRECTION.

CONSTRUCTION DETAILS FOR RED LIGHT CAMERA

- **A** F&I 13' LASER POLE. F&I 1 RUN OF 3/C #14 CABLE & INSTALL 1 RUN OF 12 PAIR LASER CABLE (FURNISHED BY LASERCRAFT) FROM LASER POLE TO CAMERA POLE. LEAVE 5' OF SLACK COILED OUT OF TOP OF LASER POLE AND 10' OF SLACK COILED IN BOTTOM OF CAMERA POLE.
- **B** REMOVE EXISTING CAMERA POLE. INSTALL NEW 13' CAMERA POLE ONTO EXISTING T-BASE. F&I 1 RUN OF 7/C #14 CABLE FROM CAMERA POLE TO TRAFFIC SIGNAL CABINET. LEAVE 10' OF SLACK COILED IN BOTTOM OF CAMERA POLE. F&I 1 RUN OF 3/C #14 CABLE FROM CAMERA POLE TO SERVICE PEDESTAL. LEAVE 10' OF SLACK COILED IN BOTTOM OF CAMERA POLE. INSTALL CAMERA CONTROLLER
- **C** USE EXISTING CAMERA CONDUIT.
- **D** F&I 2" PVC (SCH. 80) CONDUIT - TRENCHED.
- **E** F&I 2" PVC (SCH. 80) CONDUIT - PUSHED. (NOT USED)
- **F** USE EXISTING HANDHOLE.
- **G** F&I HANDHOLE. (NOT USED)
- **H** F&I EMBEDDED SERVICE PEDESTAL. (SEE ATTACHED TYPICALS) F&I SCH 80 PVC CONDUIT TRENCHED (SIZE PER BY POWER COMPANY) FROM SERVICE PEDESTAL TO SERVICE POLE. F&I RISER UP POLE IF NEEDED.
- **I** LOCATE EXISTING SPARE 2" CONDUIT IN TRAFFIC SIGNAL CABINET. F&I 2" PVC SCH 80 CONDUIT TRENCHED FROM TRAFFIC SIGNAL CABINET AND ELBOWED INTO SERVICE PEDESTAL. F&I #4 WIRE FROM SERVICE PEDESTAL TO TRAFFIC SIGNAL CABINET. COORDINATE WITH POWER COMPANY THE SWITCHING OF THE SERVICE. AFTER SWITCH IS MADE REMOVE ALL NOT USED POWER SERVICE EQUIPMENT AND PLUG ALL HOLES.
- **J** USE EXISTING CONDUIT. F&I INNERDUCT. (SEE FILL FACTOR SHEET CONDUITS 1 THRU 6)
- **K** REMOVE ABANDONED ALL EXISTING EQUIPMENT, FLASH POLE, T-BASE, LOOPS AND WIRING. JACKHAMMER ANY EXISTING FOUNDATIONS NOT USED 12" BELOW GRADE.
- **L** JACKHAMMER 2" PVC (SCH 80) ELBOW INTO POLE BASE.

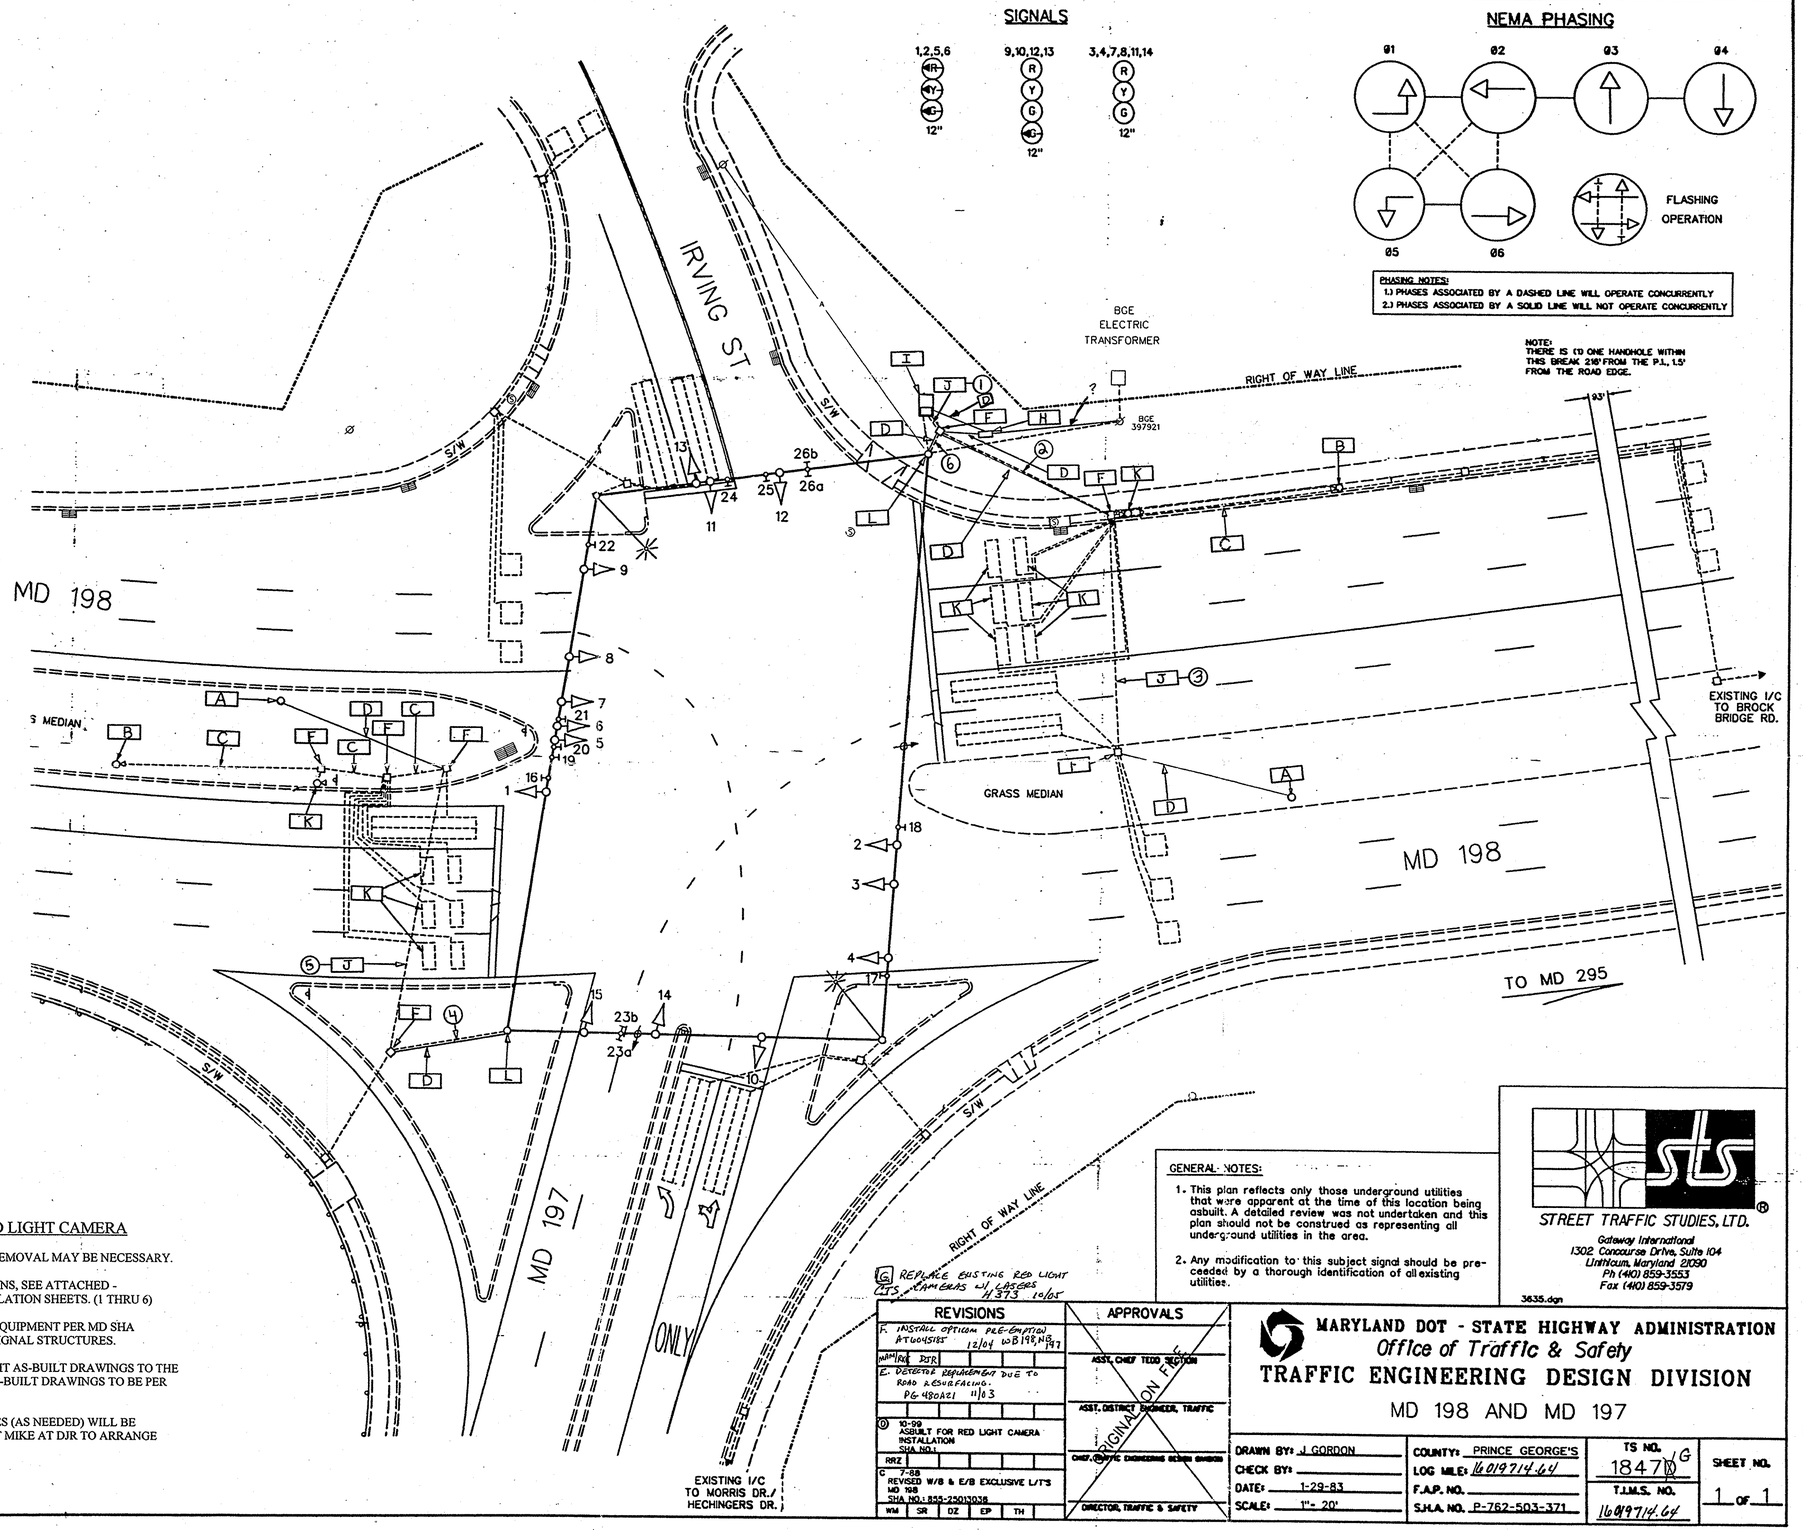

CONSTRUCTION NOTES FOR RED LIGHT CAMERA

1. SOME HAND TRENCHING & SIDEWALK REMOVAL MAY BE NECESSARY.
2. FOR WIRING DETAIL & OTHER DIMENSIONS, SEE ATTACHED - INTERSECTION DRAWING & FILL CALCULATION SHEETS. (1 THRU 6)
3. CONTRACTOR IS TO GROUND CAMERA EQUIPMENT PER MD SHA SPECIFICATIONS REGARDING TRAFFIC SIGNAL STRUCTURES.
4. LASERCRAFT IS TO FURNISH AND SUBMIT AS-BUILT DRAWINGS TO THE STATE HIGHWAY ADMINISTRATION. AS-BUILT DRAWINGS TO BE PER MD SHA SPECIFICATIONS.
5. POLES, ANCHOR BOLTS AND LIGHT POLES (AS NEEDED) WILL BE FURNISHED BY LASERCRAFT. CONTACT MIKE AT DJR TO ARRANGE FOR PICK-UP. (410-442-1706)

GENERAL NOTES:

1. This plan reflects only those underground utilities that were apparent at the time of this location being asbuilt. A detailed review was not undertaken and this plan should not be construed as representing all underground utilities in the area.
2. Any modification to this subject signal should be preceeded by a thorough identification of all existing utilities.

STREET TRAFFIC STUDIES, LTD.
Gateway International
1302 Concourse Drive, Suite 104
Linthicum, Maryland 21090
Ph (410) 859-3553
Fax (410) 859-3579
3635.dgn

GEOMETRIC LEGEND	
PROPOSED	————
EXISTING	- - - - - - - -

LEGEND OF UNDERGROUND AND OVERHEAD UTILITIES	
AERIAL CABLE	—A—A—
ELECTRIC	—E—E—
TELEPHONE	—T—T—
GAS	—G—G—
SEWER	—S—S—
WATER	—W—W—
CABLE TV	—TV—TV—

G REPLACE EXISTING RED LIGHT CAMERAS W/ LASERS CTS H373 10/05

REVISIONS

F. INSTALL OPTICAM PRE-EMPTION ATTACHMENTS 12/04 WB198 NB197
WAM RRZ DJR
E. DETECTOR REPLACEMENT DUE TO ROAD RESURFACING. PG 480A21 11/03
D 10-99 ASBUILT FOR RED LIGHT CAMERA INSTALLATION SHA NO.1
RRZ
C 7-88 REVISED W/B & E/B EXCLUSIVE L/T'S MD 198 SHA NO.: 855-25013038
WM SR DZ EP TH

APPROVALS

ASST. CHIEF TEDD SECTION
ASST. DISTRICT ENGINEER, TRAFFIC
CHIEF, TRAFFIC ENGINEERING DESIGN DIVISION
DIRECTOR, TRAFFIC & SAFETY
ORIGINAL ON FILE

MARYLAND DOT - STATE HIGHWAY ADMINISTRATION
Office of Traffic & Safety
TRAFFIC ENGINEERING DESIGN DIVISION
MD 198 AND MD 197

DRAWN BY: J. GORDON	COUNTY: PRINCE GEORGE'S	TS NO. 1847 G	SHEET NO.
CHECK BY:	LOG MILE: 16.0197 & 14.64		
DATE: 1-29-83	F.A.P. NO.	T.I.M.S. NO.	1 OF 1
SCALE: 1"= 20'	S.H.A. NO. P-762-503-371	16.0197 & 14.64	

OCT 26 2005