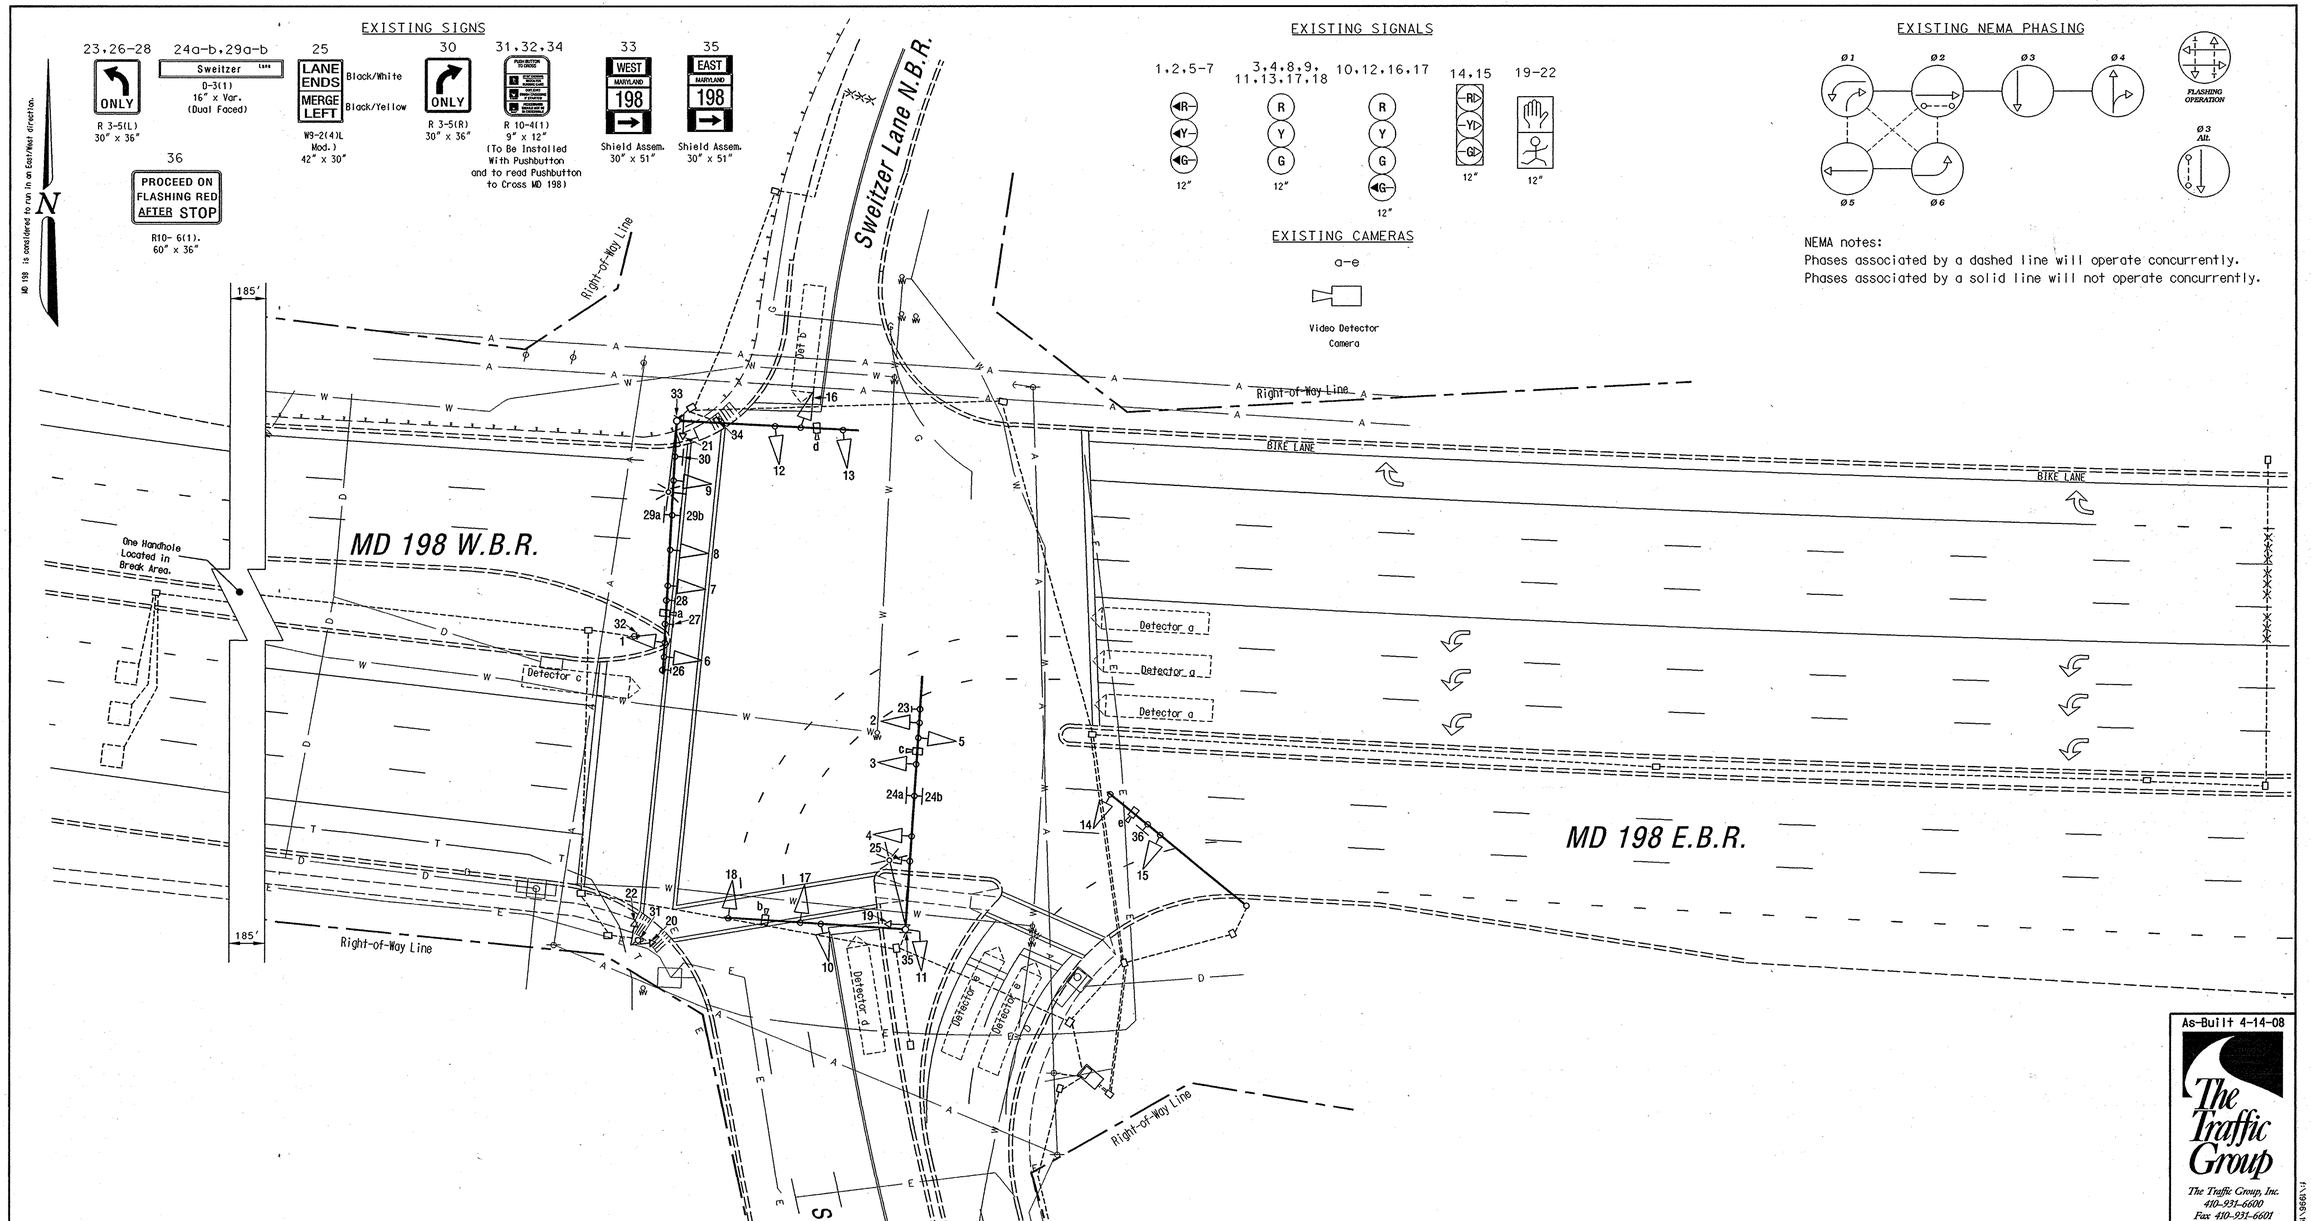

GEOMETRIC LEGEND

EXISTING GEOMETRICS

PROPOSED GEOMETRICS

UTILITY LEGEND

G — G	GAS MAIN
W — W	WATER MAIN
S — S	SEWER MAIN
E — E	ELECTRIC CABLES
D — D	STORM DRAIN
A — A	AERIAL CABLES
T — T	TELEPHONE CABLES

REVISIONS

As-Built 4-14-08	May 29, 2008
S.H.A. No.:BW996M82	
SED	
D Reconstruction due to geometric modifications	April 8, 2005
S.H.A. No.:BW996M82	
FHJ	

APPROVALS

TEAM LEADER, TRAFFIC ENGINEERING DESIGN DIVISION

ASST. CHIEF TRAFFIC ENGINEERING DESIGN DIVISION

CHIEF, TRAFFIC ENGINEERING DESIGN DIVISION

DIRECTOR, TRAFFIC & SAFETY

ORIGINAL ON FILE

MARYLAND DOT - STATE HIGHWAY ADMINISTRATION

Office of Traffic & Safety

TRAFFIC ENGINEERING DESIGN DIVISION

(Traffic Signal Plan)

MD 198 at Sweitzer Lane

DRAWN BY:	Dave Andrews	F.A.P. NO.	N/A	TS NO. 2110 D	SHEET NO.
CHECKED BY:	Steve Renzi	S.H.A. NO.	855-16001		
SCALE:	1" - 20'	COUNTY:	Prince George's	T.I.M.S. NO. G-934	1 OF 1
DATE:	August 22, 1995	LOG MILE:	16001980.67		

F:\1996\1996-0336A\dgn\asbuilt sweitzer.dgn 6/17/2008