F.H.W.A. REGION NO.	STATE	FED. AID PROJ. NO.	SHEET NO.	TOTAL SHEETS
3	MD.			

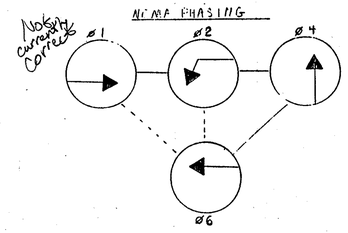

SIGNALS

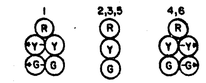

SIGNS

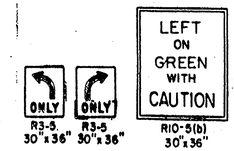

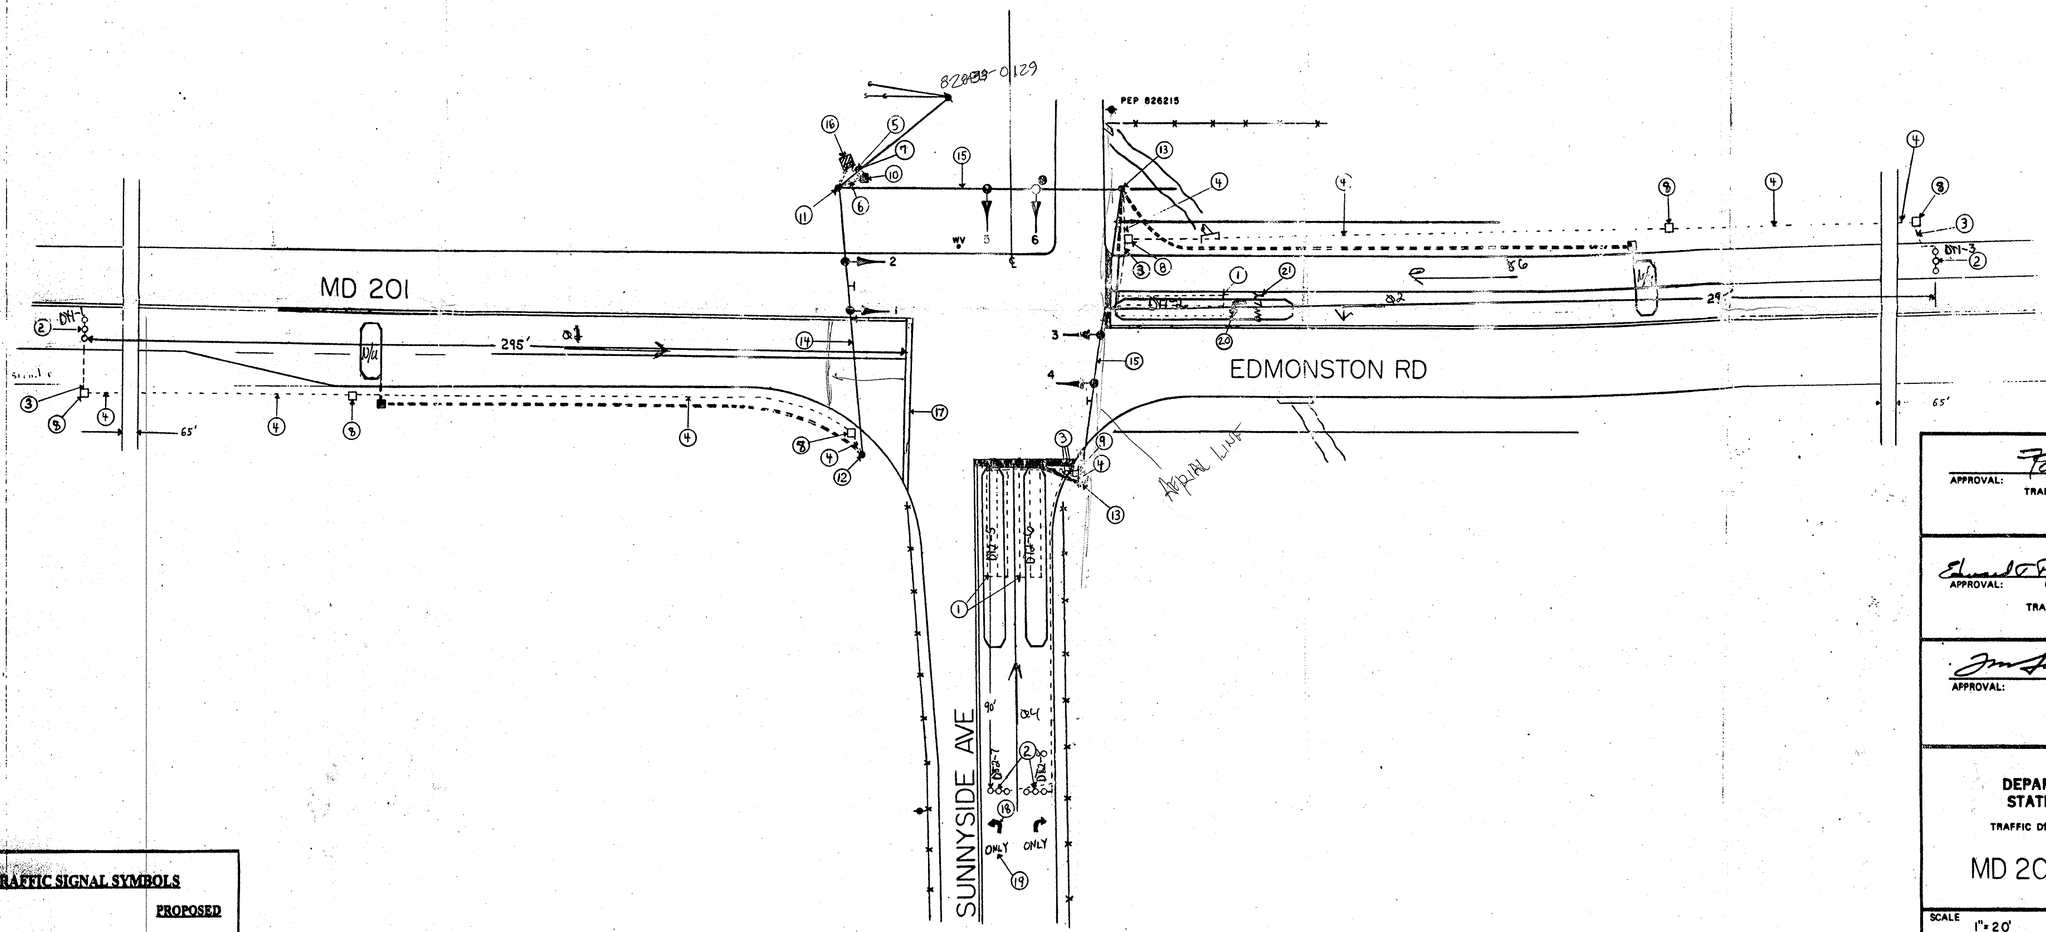

TRAFFIC SIGNAL SYMBOLS

EXISTING		PROPOSED
■	HANDHOLE	□
▭	LOOP DETECTOR(6X30)	⬚
□	LOOP DETECTOR(6X6)	⬚
------	CONDUIT	--------
▪▪▪	MICRO LOOP PROBE SET	▪▪▪

APPROVAL: REGIONAL TRAFFIC ENGINEER

APPROVAL: CHIEF-BUREAU OF TRAFFIC ENGINEERING

APPROVAL: ASS'T. CHIEF ENGINEER TRAFFIC 9/4/75

REVISIONS

(8) Replace failed loop detectors SHA # 2999-1-260-245 2/99

A 7-2-80 OLD CONTRACT NO. P376X-001-385 ASSUM'D

STATE OF MARYLAND
DEPARTMENT OF TRANSPORTATION
STATE HIGHWAY ADMINISTRATION

TRAFFIC DIVISION – BUREAU OF TRAFFIC ENGINEERING

MD 201 & SUNNYSIDE AVE

SCALE	DATE	CONTRACT NO.
1"=20'	8-25-75	P 376X-001-385

DRAWN BY: J GORDON COUNTY: PRINCE GEORGE

DESIGNED BY: J Hodn SIGNAL NO.:

CHECKED BY: A Bubichuk

DRAWING NO. TS-1164A

(6020705)85