F H WA REGION NO	STATE	FED. AID PROJ. NO	SHEET NO.	TOTAL SHEETS
3	MD.	CMG-5019(6)E	17	26

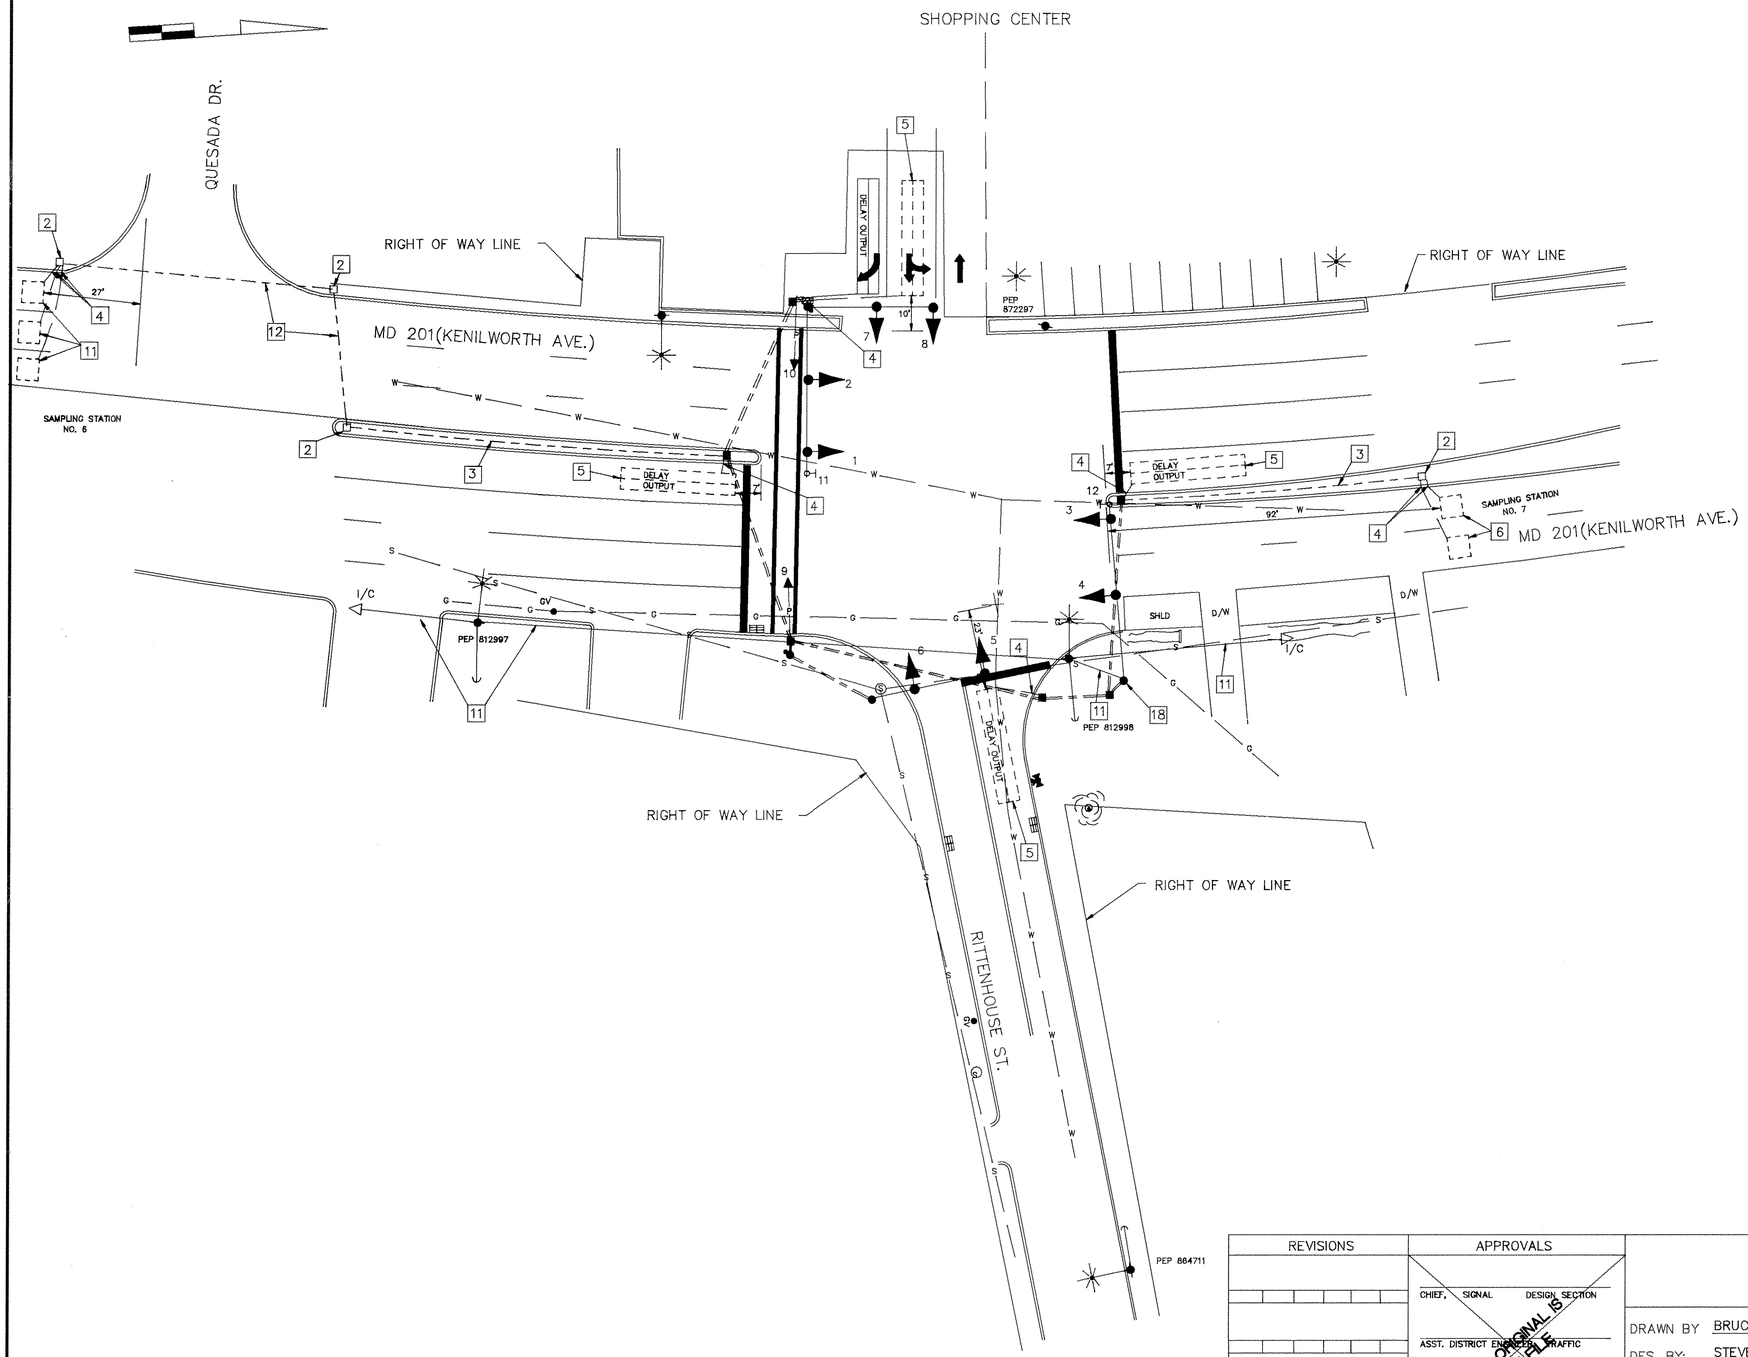

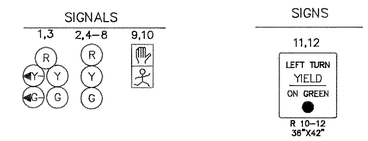

NEMA PHASING

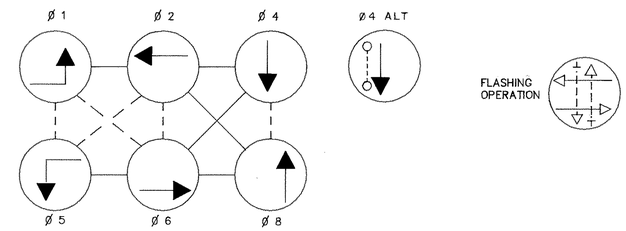

UTILITY LEGEND

—G—G—	GAS MAIN
—W—W—	WATER MAIN
—S—S—	SEWER MAIN
—E—E—	ELECTRIC CABLES
—A—A—	AERIAL CABLES
—T—T—	TELEPHONE CABLE
—C—C—	CABLE T.V.

REVISIONS	APPROVALS
	CHIEF, SIGNAL DESIGN SECTION
	ASST. DISTRICT ENGINEER, TRAFFIC
	CHIEF, TRAFFIC ENGINEERING DESIGN DIVISION
B ASBUILT 3/93 REPLACE DAMAGED LOOP DETECTORS INSTALL TELEMETRY SYSTEM P-125-501-355 CMG-5019(6)E	DIRECTOR, OFFICE OF TRAFFIC AND SAFETY

THE ORIGINAL IS ON FILE

MARYLAND DEPARTMENT OF TRANSPORTATION
STATE HIGHWAY ADMINISTRATION – OFFICE OF TRAFFIC AND SAFETY
TRAFFIC ENGINEERING DESIGN DIVISION

DRAWN BY BRUCE THOMPSON
DES. BY: STEVE RENZI
CHK. BY:

MD 201 and RITTENHOUSE ST.

16020104.16

COUNTY: PRINCE GEORGES

DATE: REDRAWN 2–12–93
SCALE: 1"=20'

F.A.P. NO. MG 5019(1)
S.H.A. NO. P–386–001–385

TS/FILE NO. 760 B

SHEET NO. 17 OF 26

16020104.16 F# 46