FHWA REGION NO	STATE	FED. AID PROJ. NO	SHEET NO.	TOTAL SHEETS
3	MD.		11	12

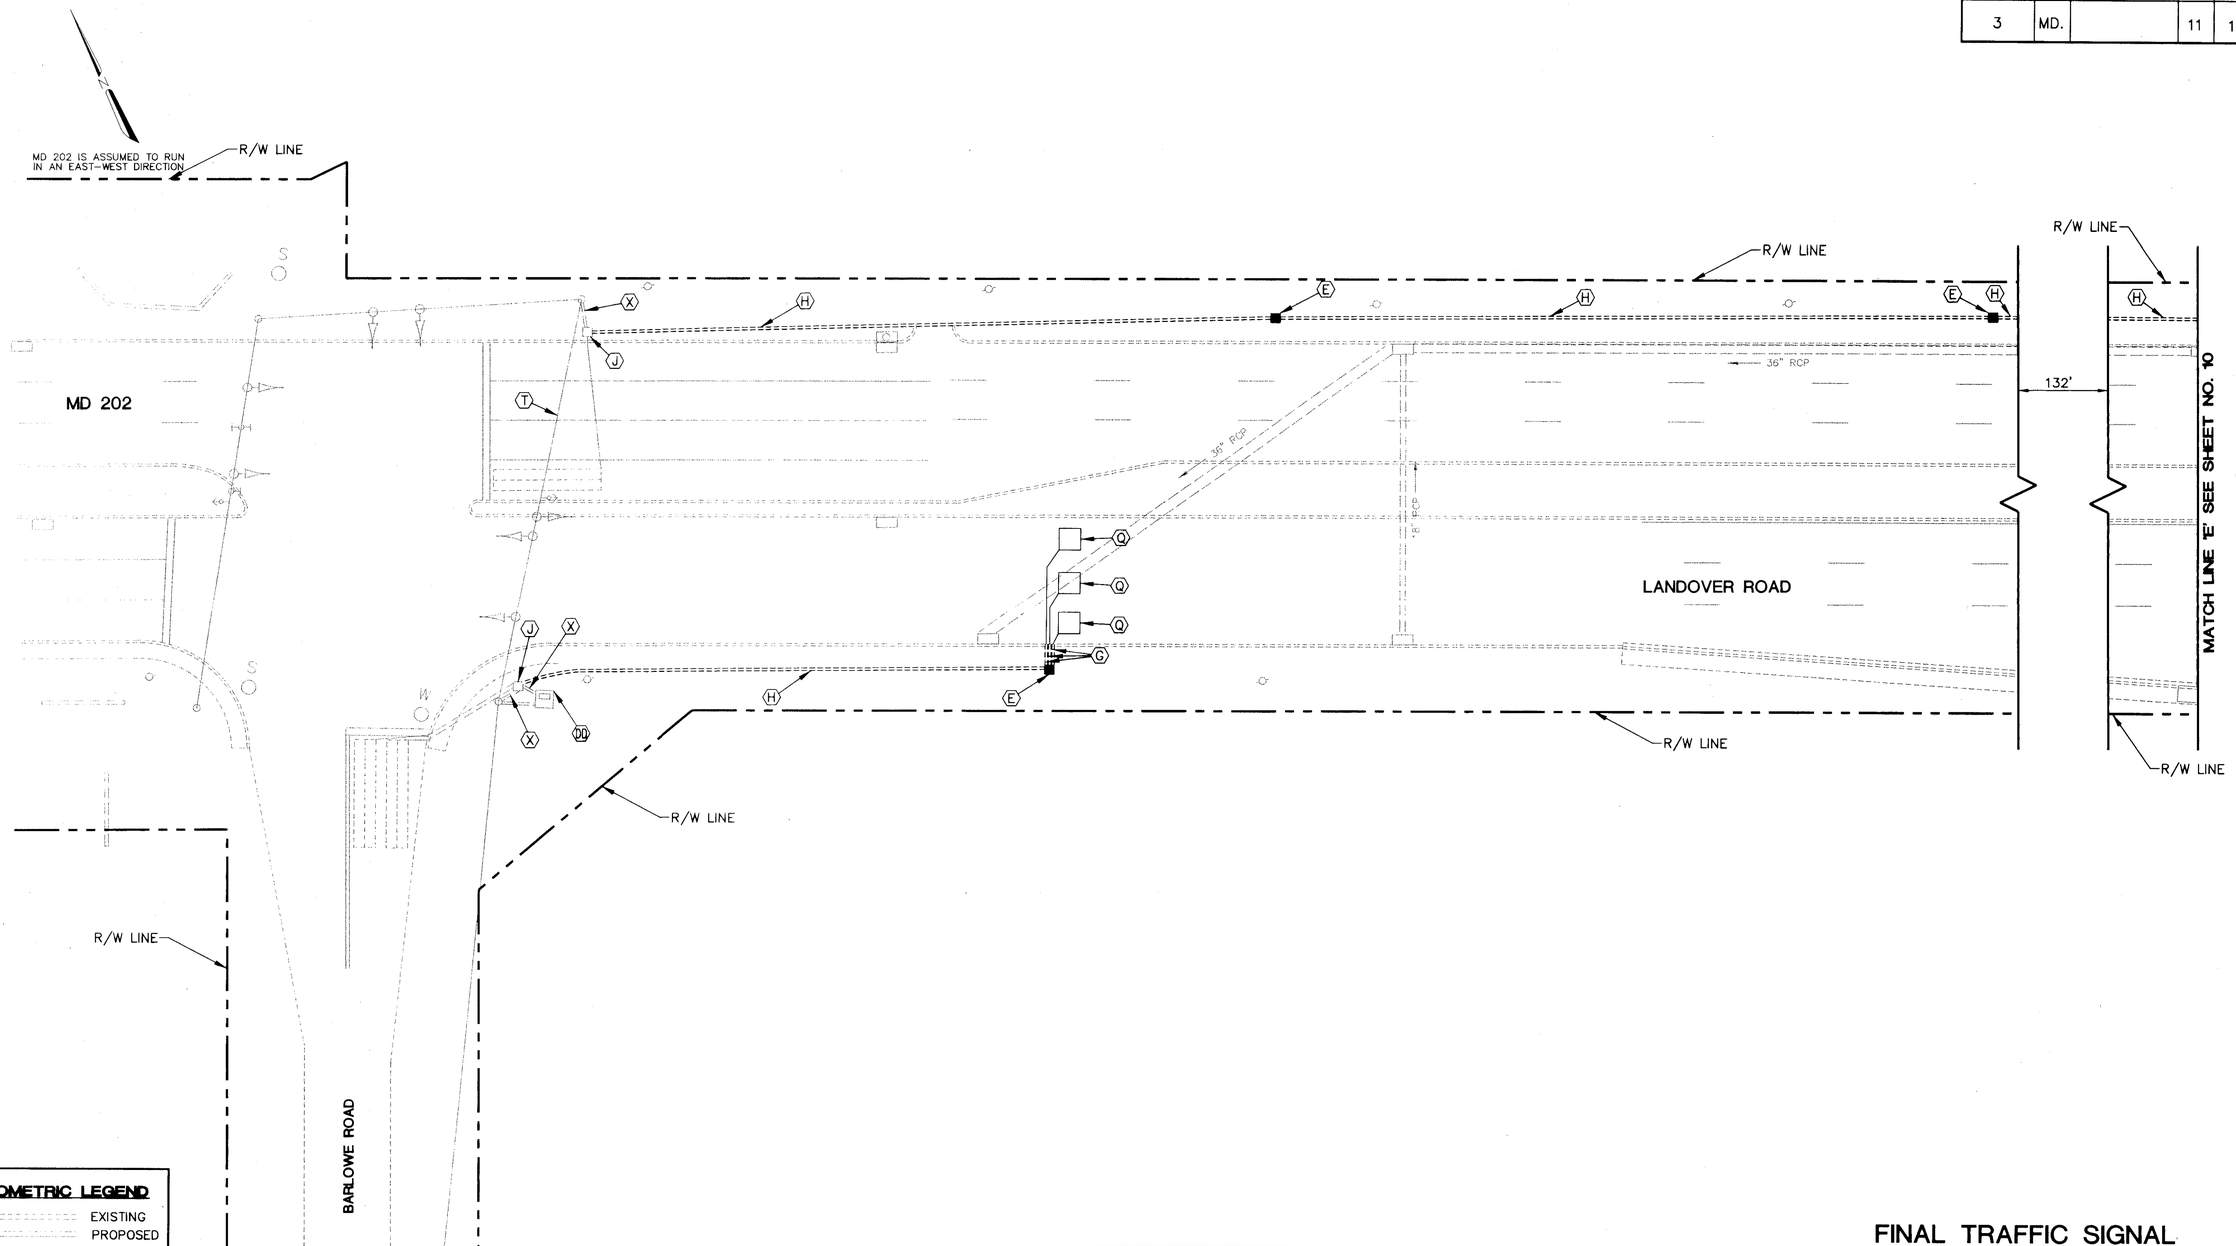

GEOMETRIC LEGEND

EXISTING
PROPOSED

UTILITY LEGEND

G	GAS MAIN
W	WATER MAIN
S	SEWER MAIN
	STORM DRAIN
TV	CABLE TELEVISION
E	ELECTRIC CABLES
T	TELEPHONE CABLES
A	AERIAL CABLES

REVISION "C"
A/E GROUP, INC.
ENGINEERS • PLANNERS
181 East Main Street
Westminster, Maryland 21158
A/E Job No. 96-316

REVISIONS
(C) 04-07-97 RECONSTRUCT SIGNAL DUE TO GEOMETRIC CHANGES.
J.F.L.
(B) 4-10-91 INSTALL OPTICOM EQUIPMENT, REPLACE LOOP, AND AS-BUILT. SHA NO.
(A) 2-4-89 RECONSTRUCT SIGNAL DUE TO GEOMETRIC CHANGES. SHA NO. BW-230-802-312.

APPROVALS

CHIEF, SIGNAL DESIGN SECTION
ASST. DISTRICT ENGINEER, TRAFFIC
CHIEF, TRAFFIC ENGINEERING DESIGN DIVISION
DIRECTOR, OFFICE OF TRAFFIC & SAFETY

ORIGINAL ON FILE

FINAL TRAFFIC SIGNAL

MDOT - STATE HIGHWAY ADMINISTRATION
Office of Traffic & Safety
TRAFFIC ENGINEERING DESIGN DIVISION

SIGNAL • 16020210.05

DRAWN BY: J. GORDAN
DES. BY:
CHK. BY:

MD 202 (LANDOVER RD.) AND BRIGHTSEAT RD.

GENERAL INFORMATION — COUNTY: PRINCE GEORGE'S

DATE: 3/13/78 — F.A.P. NO. T-8006 (26)
SCALE: 1" = 20' — S.H.A. NO. P-346-1-385

TS/STD. NO. 880 C-GI

SHEET NO. 11 OF 12